

SECTIONS OF HOPPER DREDGER N<sup>o</sup> 189

SCALE  $\frac{1}{2}$  " = ONE FOOT

LENGTH BETWEEN P.P. 134'-3"

BREATH MOULDED 32-0


DEPTH MOULDED 13' 0

EQUIPMENT AS SPECIFIED

R BOWEN HOOKS	10 CWT APCH (INC <sup>Y</sup> STOCK)	SINGLE FLIND
40 "	6 30 "	" "
150 FATHOMS 1" SHORT LINK CHAIN (BOW)		
150 "	7 1/2 "	" (STERN)
300 "	8 1/2 "	" THWARTSHIP

CHAINS IN 30 FATHOM LENGTHS


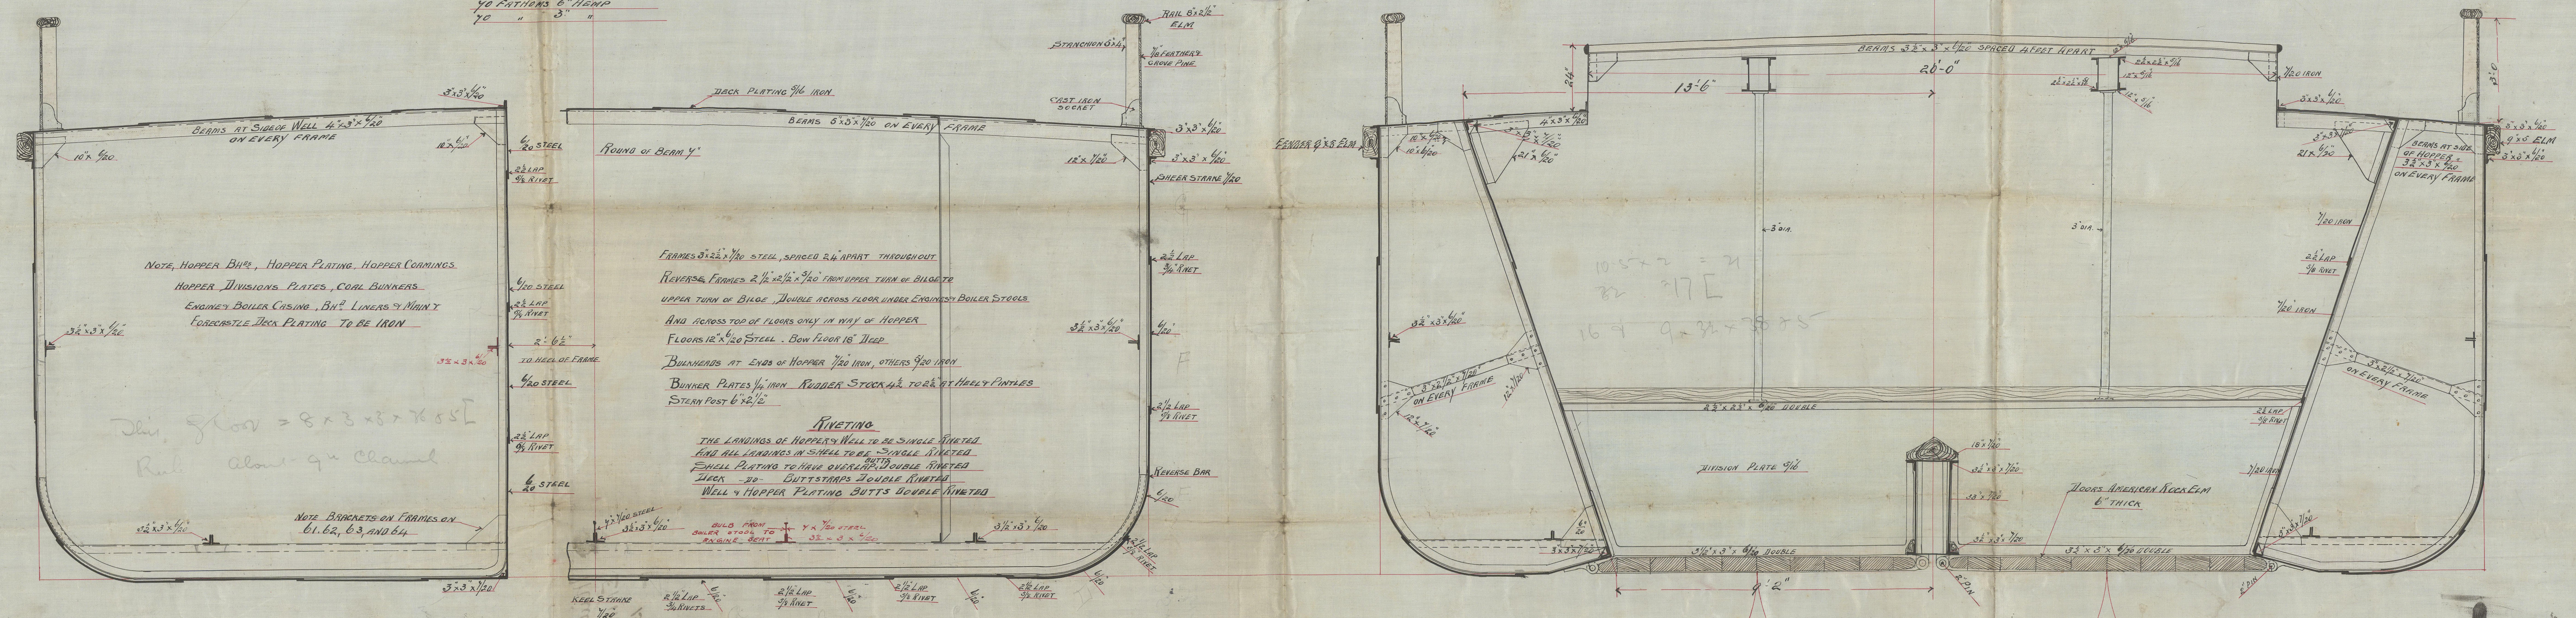

W. L. D.  
19/10/93.  
See Letter



Midship Sections  
ERIN-go-brak  
137' 9" x 32' x 13'

