Office

M.V. "ROSE-JULIE M."

DIMS 140'-0 B? × 26'-0" × 11'-0" MLD.

SCALE .8 = 1 FOOT.

RPT. No. Gms. 2338)

AFT HATCH COAMING IF INCREASED IN HEIGHT 1'6" WOULD RESULT IN 75D ADDITIONAL CUBIC.

COAMINGS TO BE STIFFENED & SUPPORTED AS PER RULE.

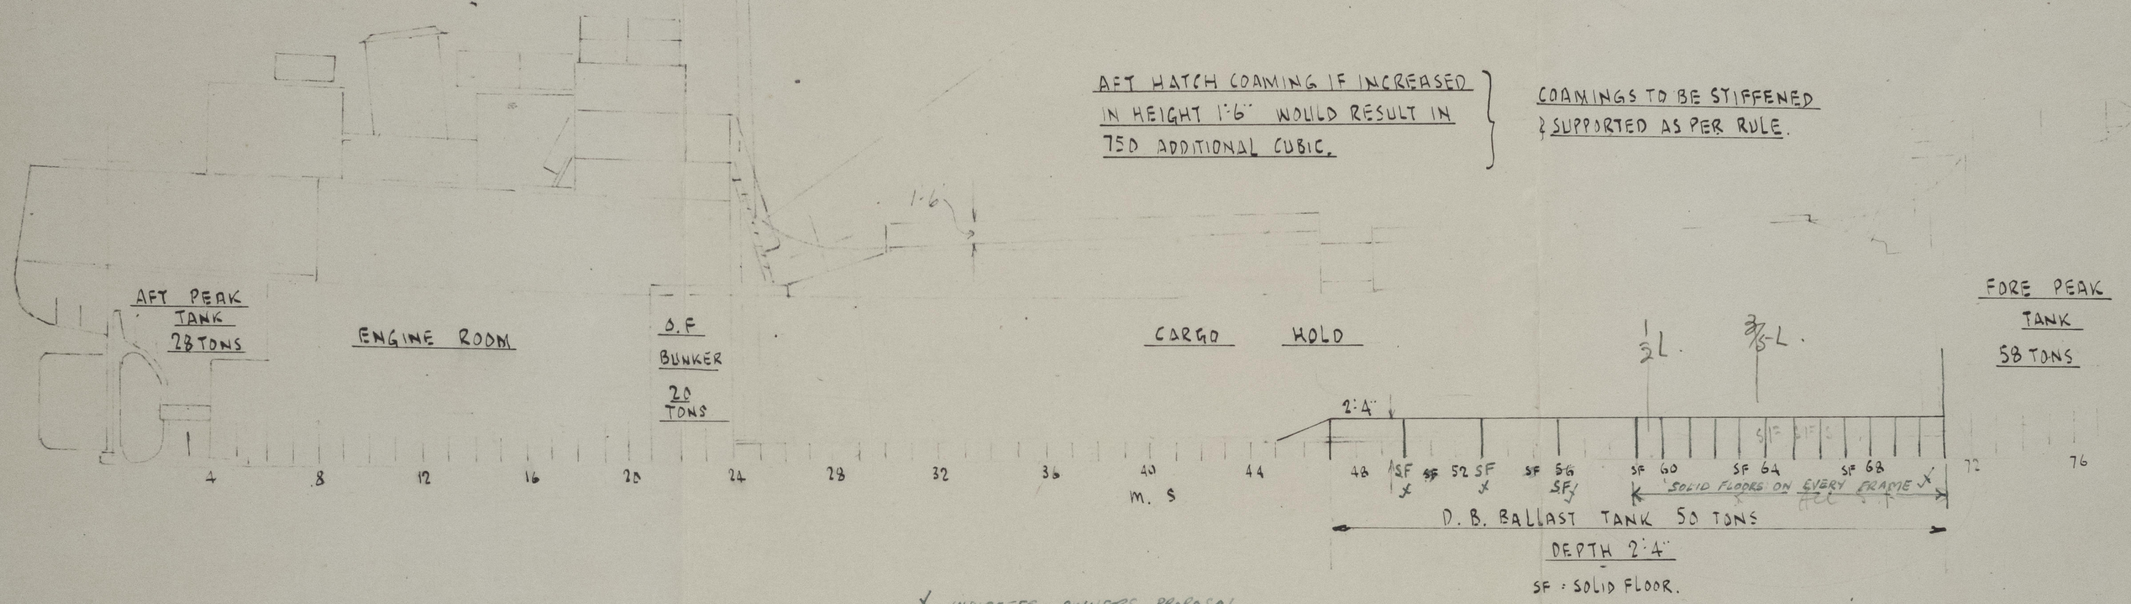

INDICATES OWNERS PROPOSAL SEE LETTER DATED 26/7/48.

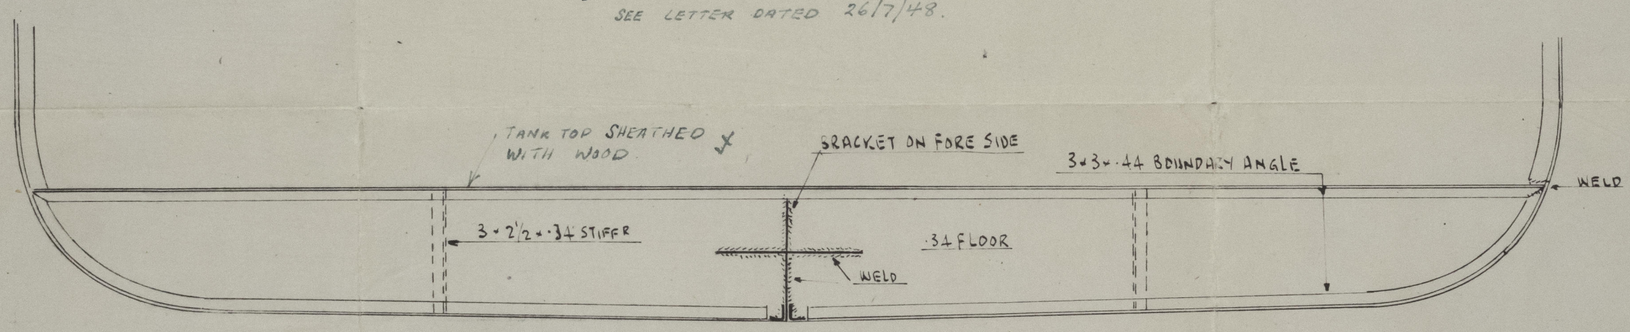

W.T. TANK END FR 47.

Stiffening Angle.

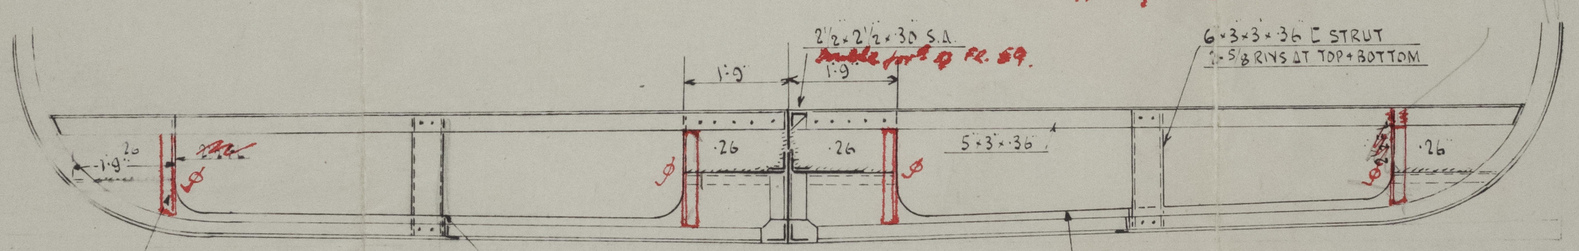

LEAVE EXISTING FLOOR & REVERSE BAR AT ENDS & CENTRE THUS

CROP EXISTING SIDE KEELSON BACK TO 5" FROM HEEL OF BAR

SKELETON FLOOR.

CROP EXISTING FLOORS BACK TO 5" FROM HEEL OF FRAME.

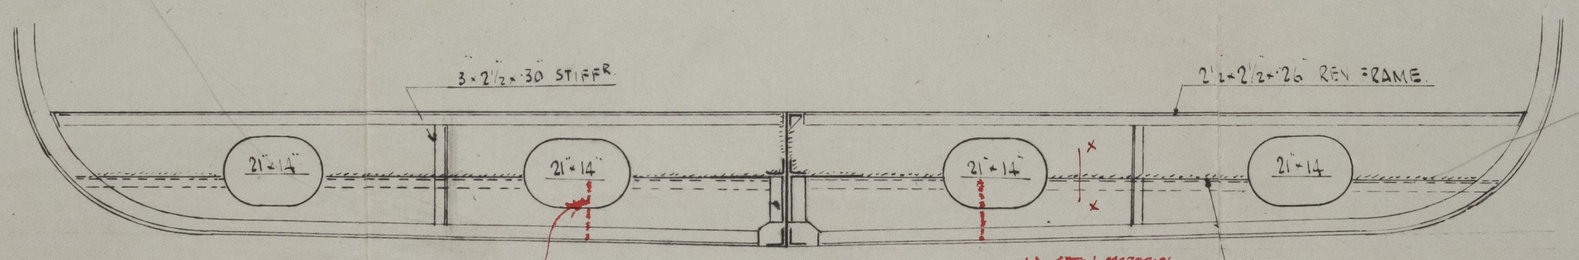

½ Right intercostal between frs 60 and 71. Manhole repositioned to suit. (corresponding to position of existing keelson.)

SOLID FLOORS

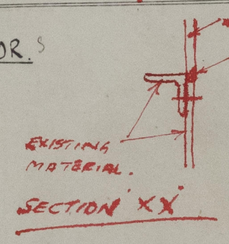

SECTION XX

WELD NEW TOP PIECE TO EXISTING FLOOR.

V welded.

J. S. DOIG (GRIMSBY) LTD. SHIPYARD DRAWING OFFICE 6 JUL 1948 GRIMSBY DOCKS ENGINEERS & SHIPBUILDERS

30.7.48

J.S. DOIG (GRIMSBY) LTD.
SHIPBUILDERS AND ENGINEERS,
GRIMSBY.

DRAWING N°3881

© 2020 Lloyd's Register Foundation

004042-004048-0194