

**PROPOSED NEW PIPING
IN RED**

LONDON COPY.

NOT TO SCALE

M/V ROSE - JULIE M. EX. EMPIRE BANK


FOR DETAILS OF DB TANKS DRG 3782

J.S. DOIG (GRIMSBY) LTD ENGINEERS, GRIMSBY	
PROPOSED NEW DB TANKS. PIPING ARR I	
DRAWN	TRACED DYES DRAWING NUMBER
PRR	
6-9-48	

4012
Lloyd's Register
Foundation

004042-004048-0197

NOT A LONDON COPY

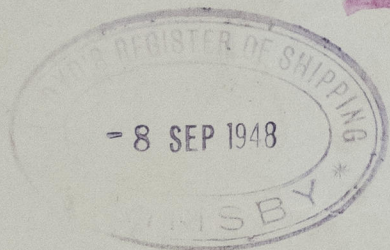

"ROSE-JULIE M"

Proposed double bottom
piping Arr.

RPT. No. Gms 23387

