

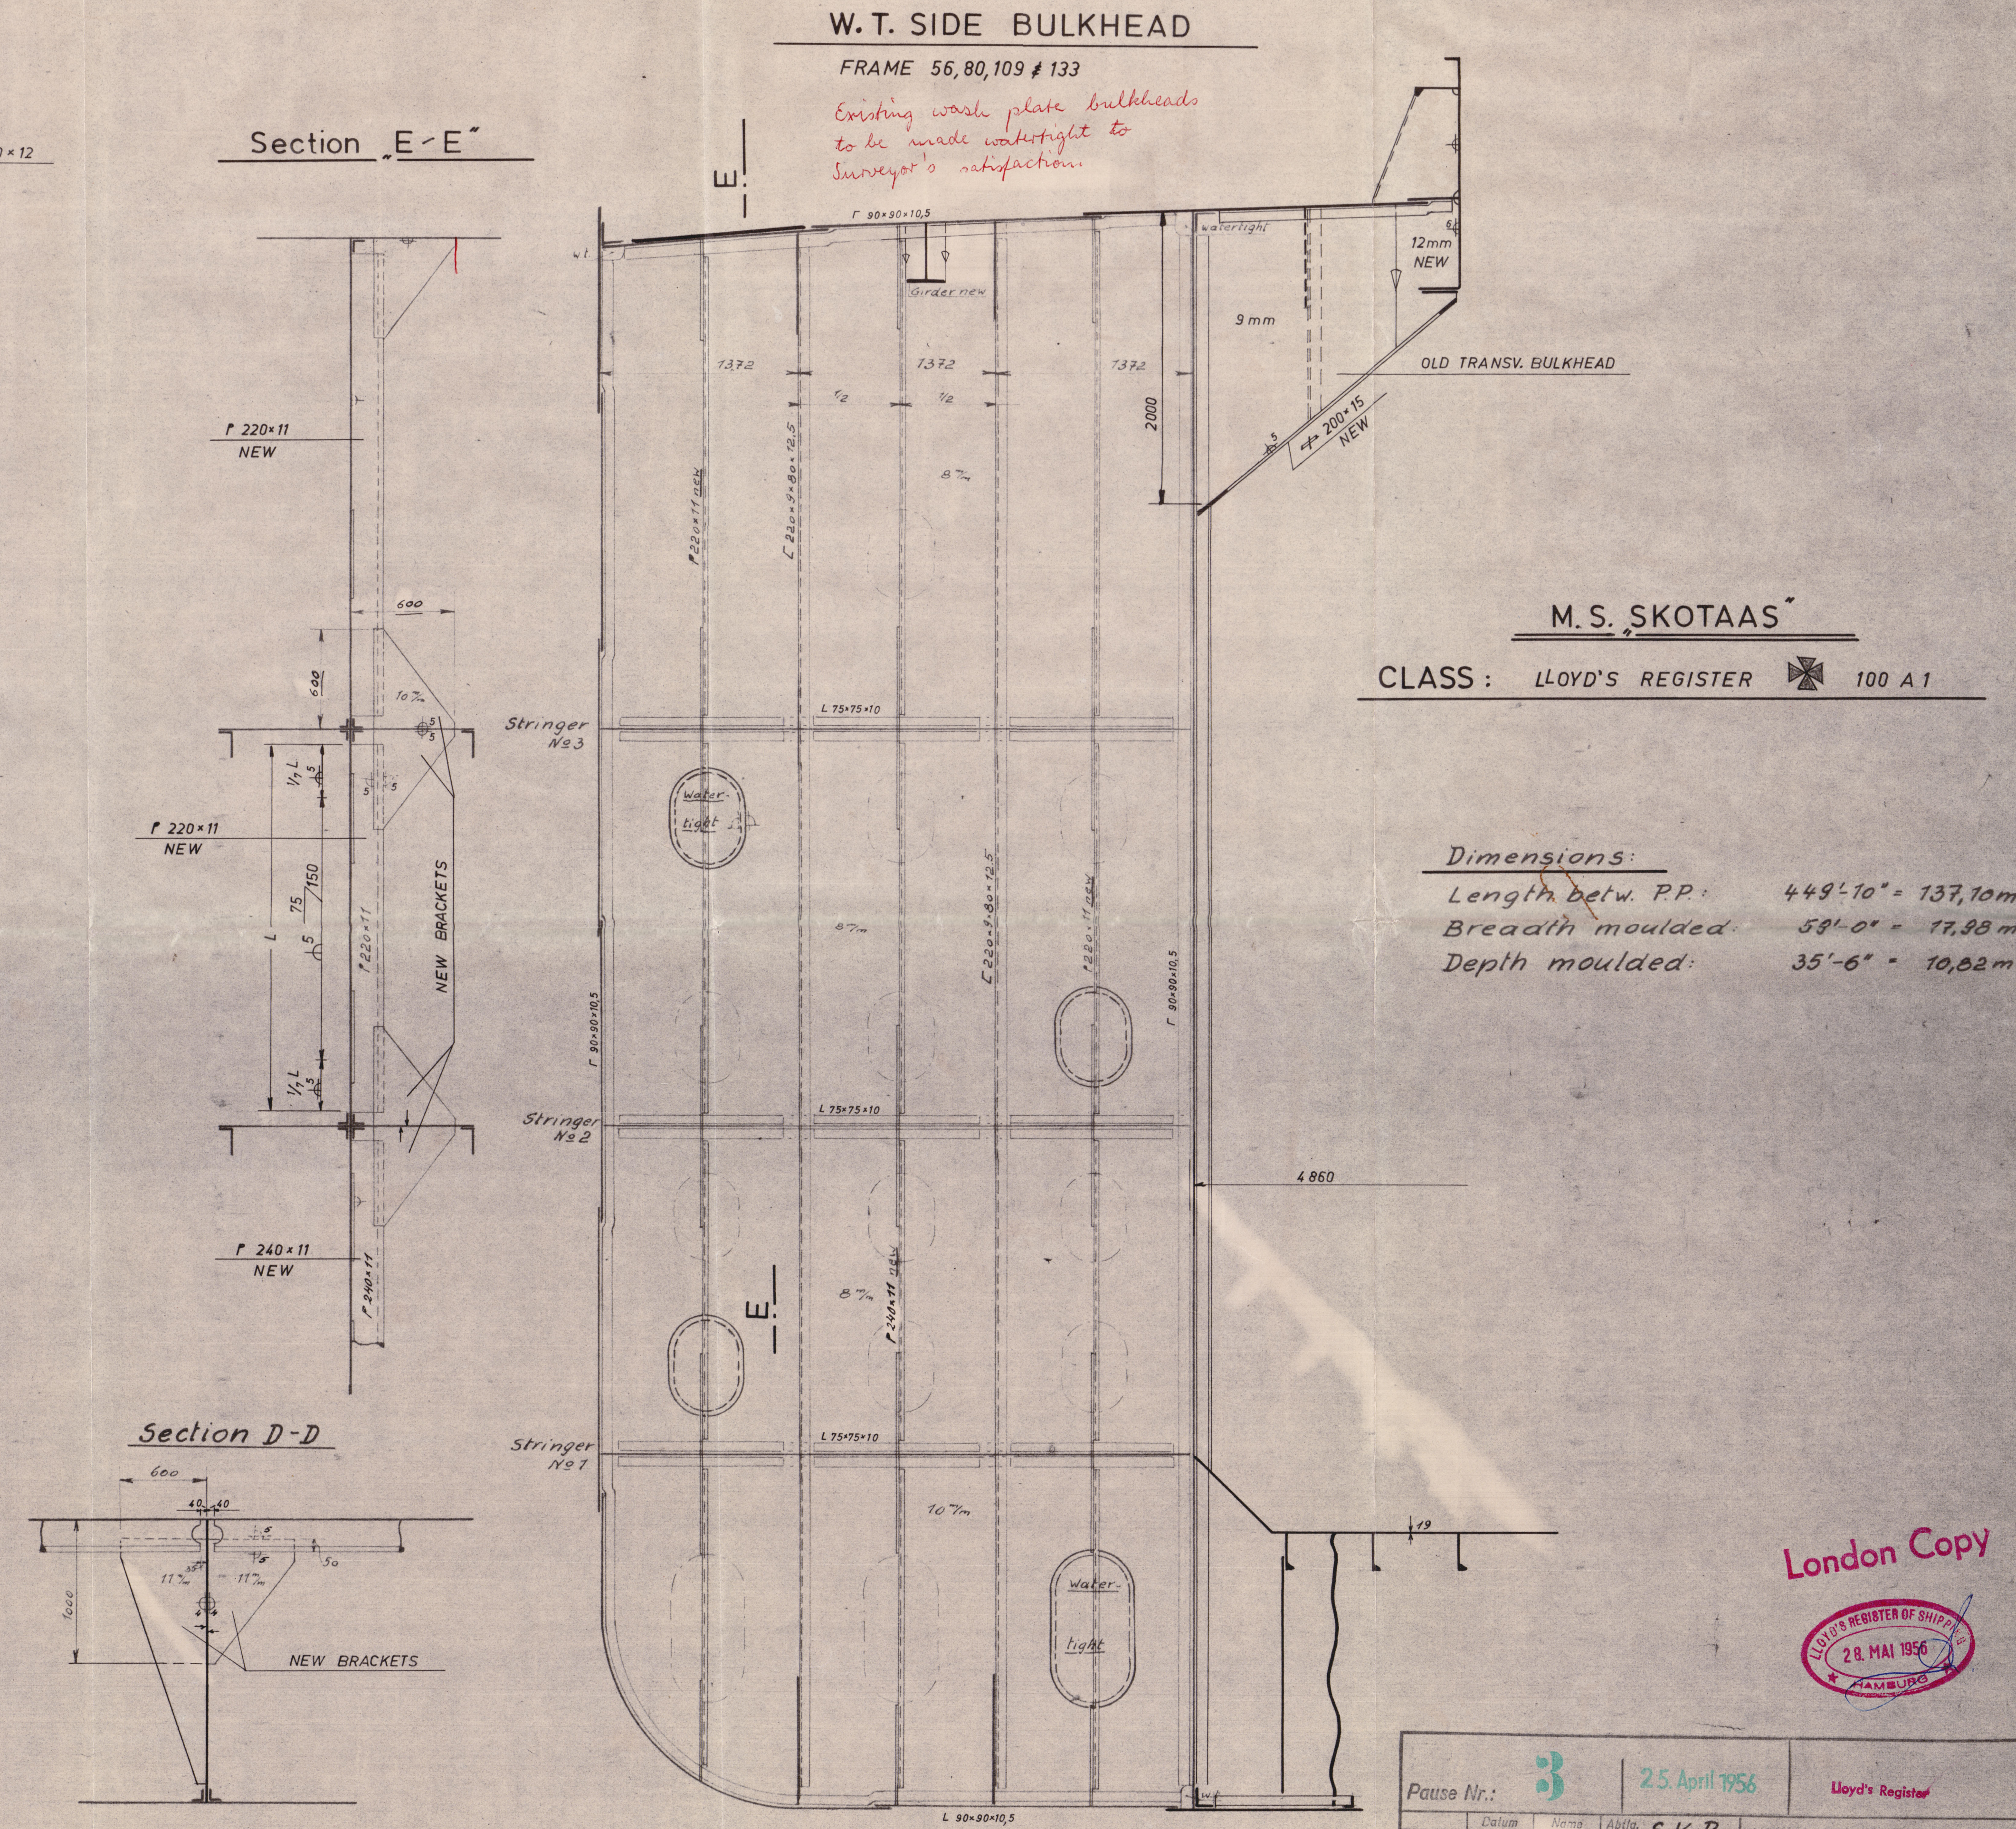


MAIN SECTION

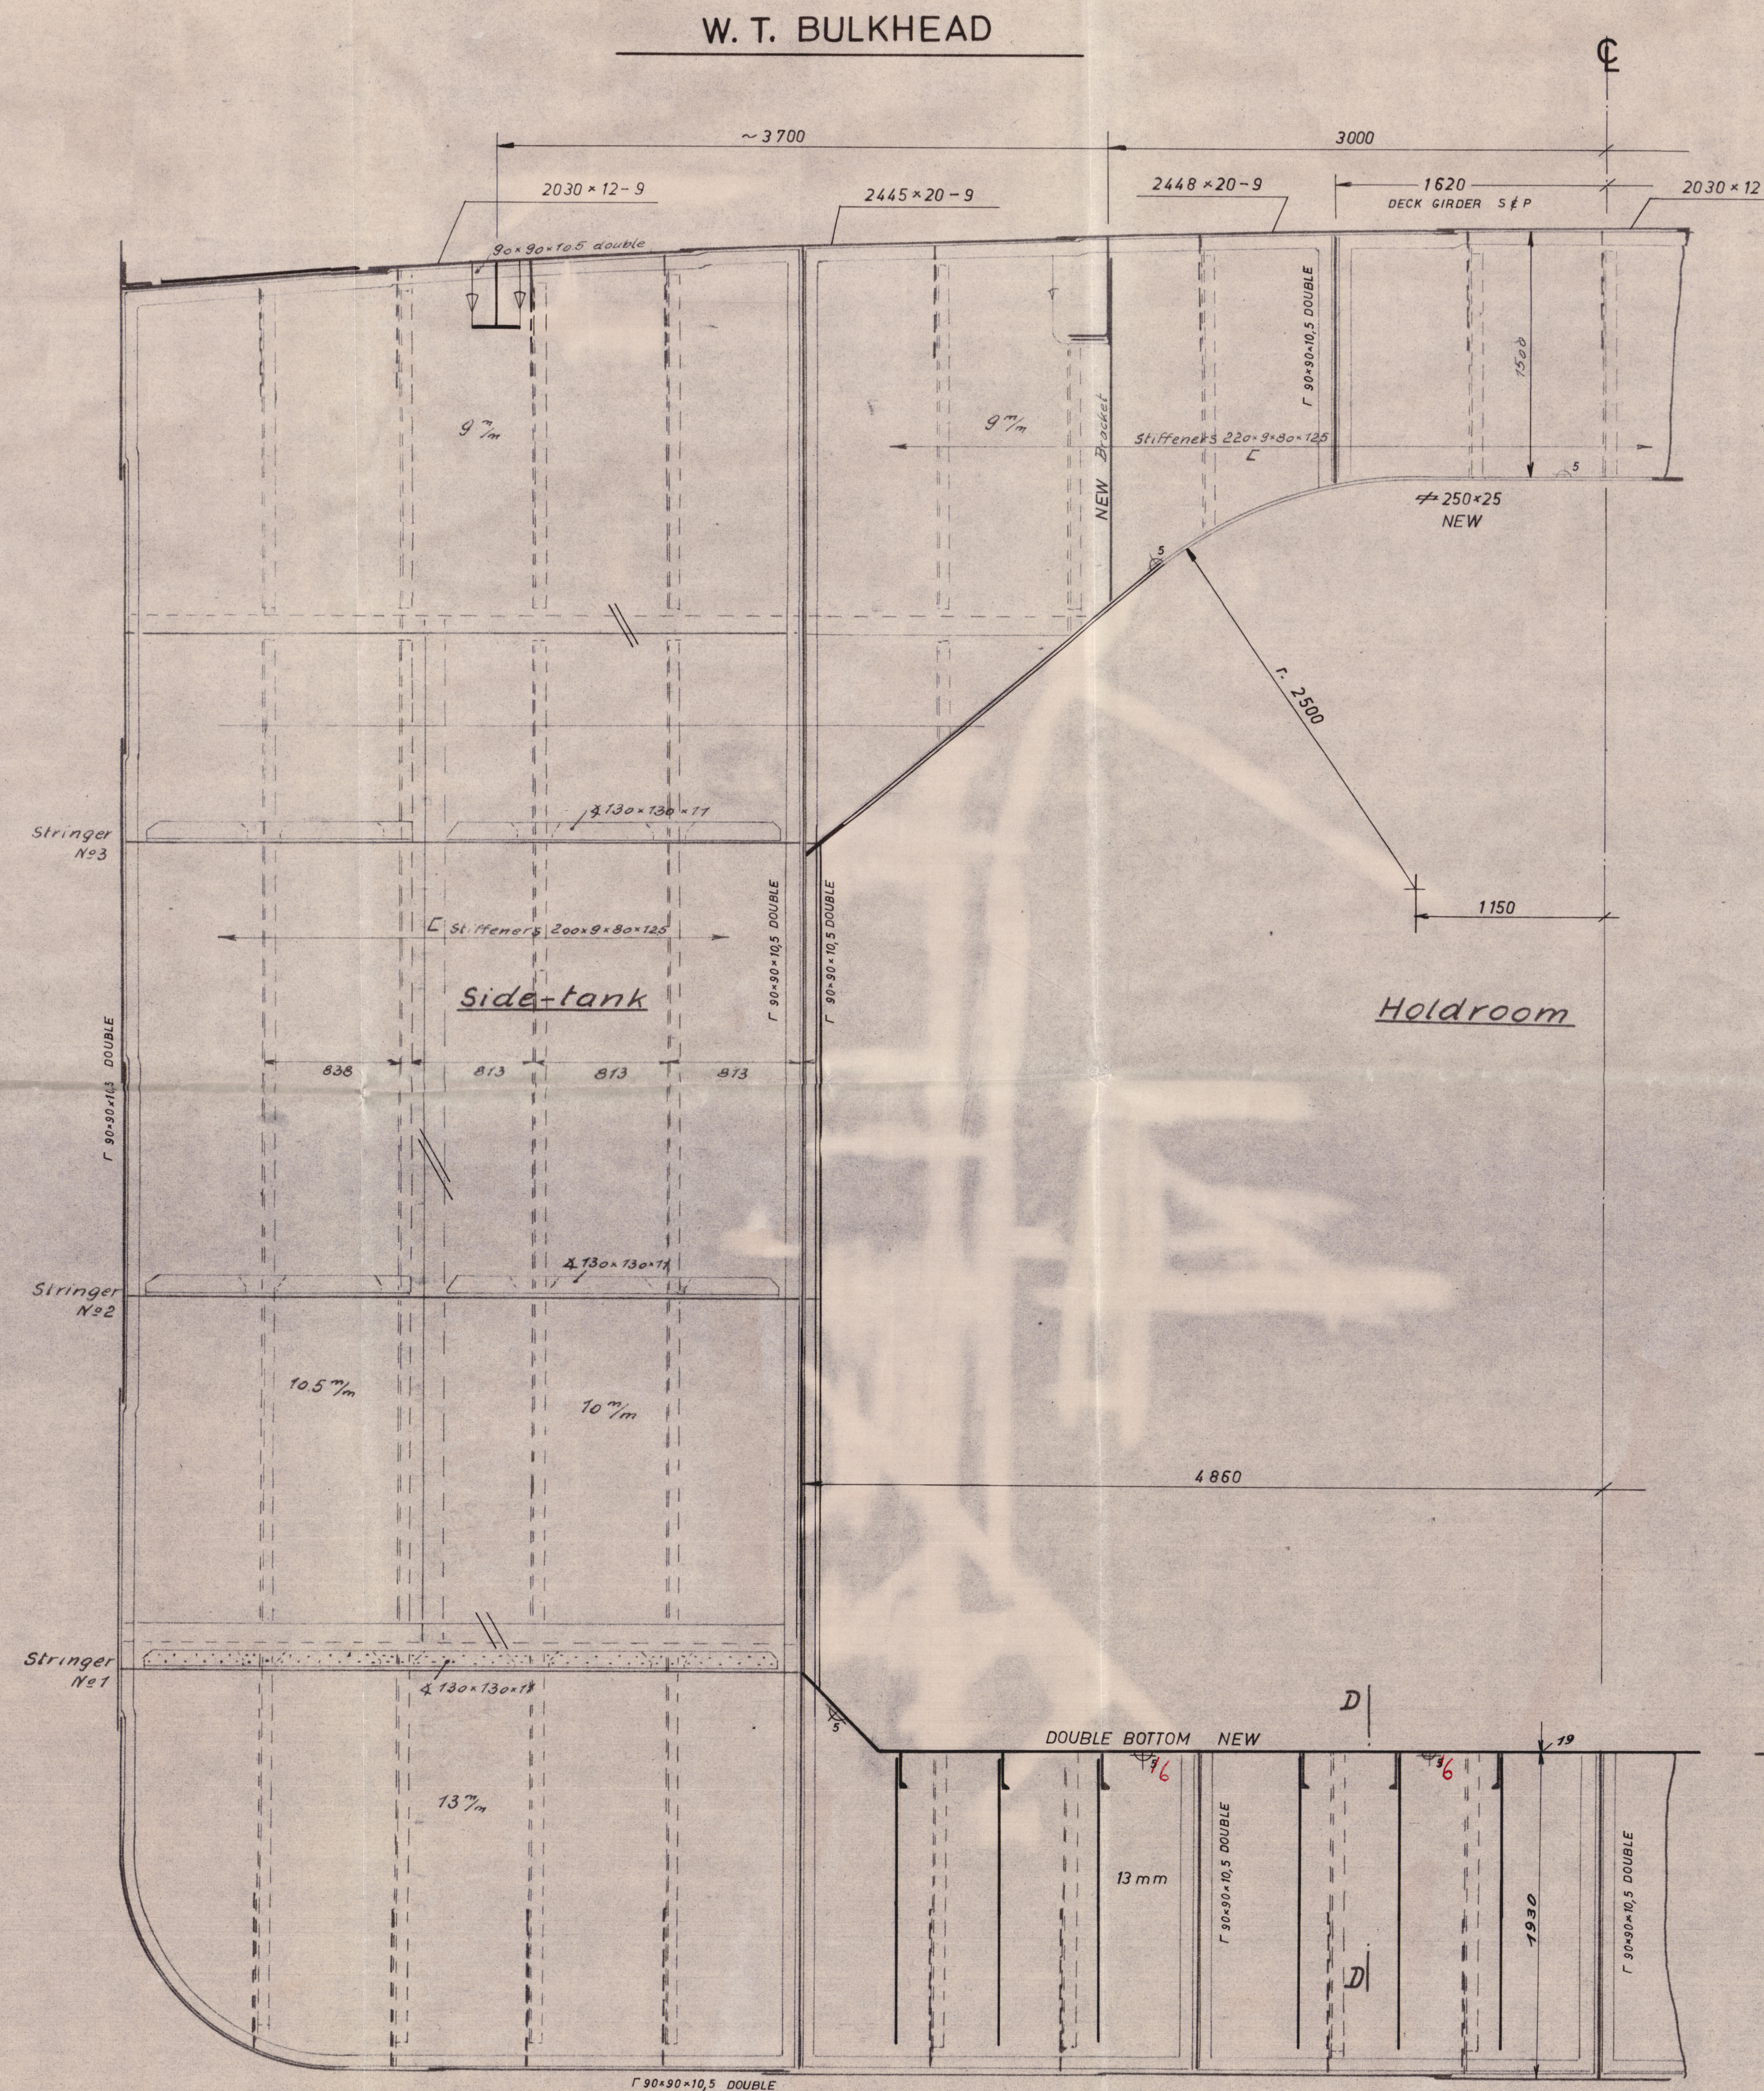

London Copy

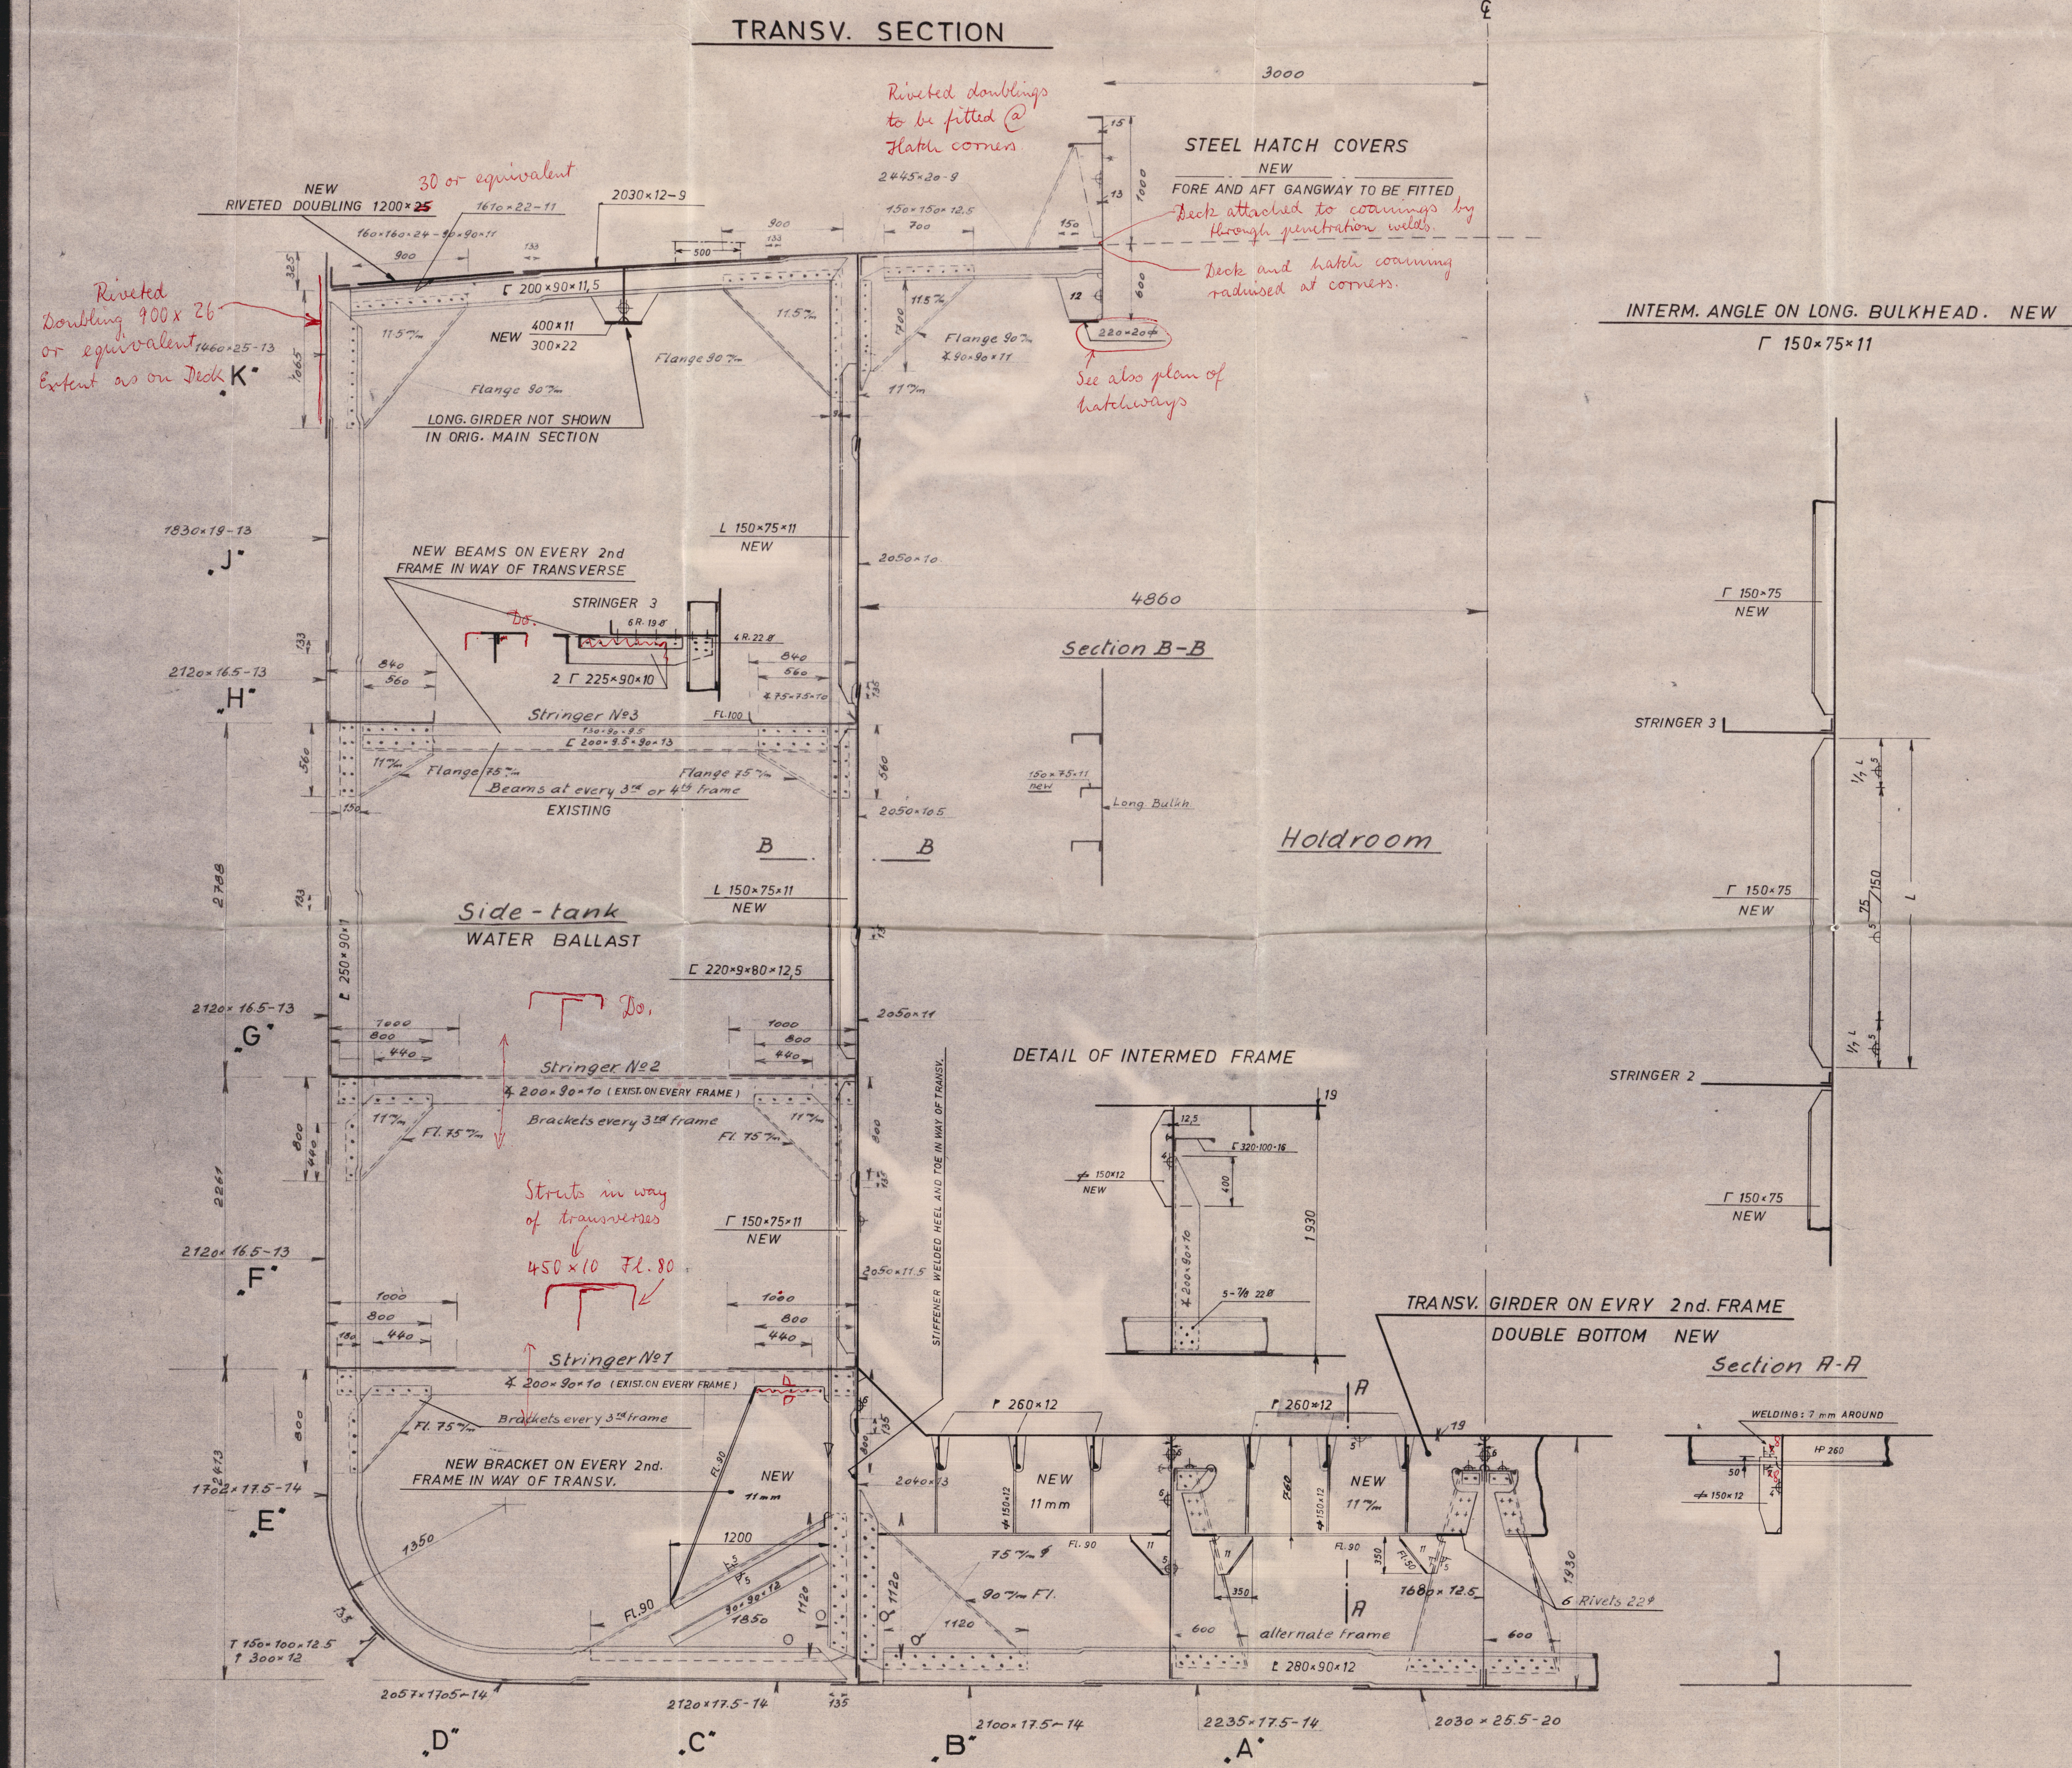

Pause Nr.: 3		25. April 1956		Lloyd's Register	
Datum 24.4.56		Uhrzeit 9:20		Abteil. S. K. R.	
Gezeichnet G. W. P.		Gezeichnet G. W. P.		Firma HOWALDTSWERKE HAMBURG A.-S.	
		Main - section Hauptspann		242221 No. 8579/2 122/1	