

Lloyd's Register of Shipping.

SURVEYS FOR FREEBOARD.

(CONDITIONS OF ASSIGNMENT.)


RPT. N° F132

Ship's Name **"MT. SKOTARS"**Port of Survey **GALVESTON**

Official Number

Surveyor's Signature **Wm Rennie**Nationality and Port of Registry **NORWEGIAN - LARVIK**Date of Survey **3rd June 1943.**

Disposition and dimensions of superstructures, trunks, deckhouses and machinery casings to be inserted in the diagrams and tabular statement:—

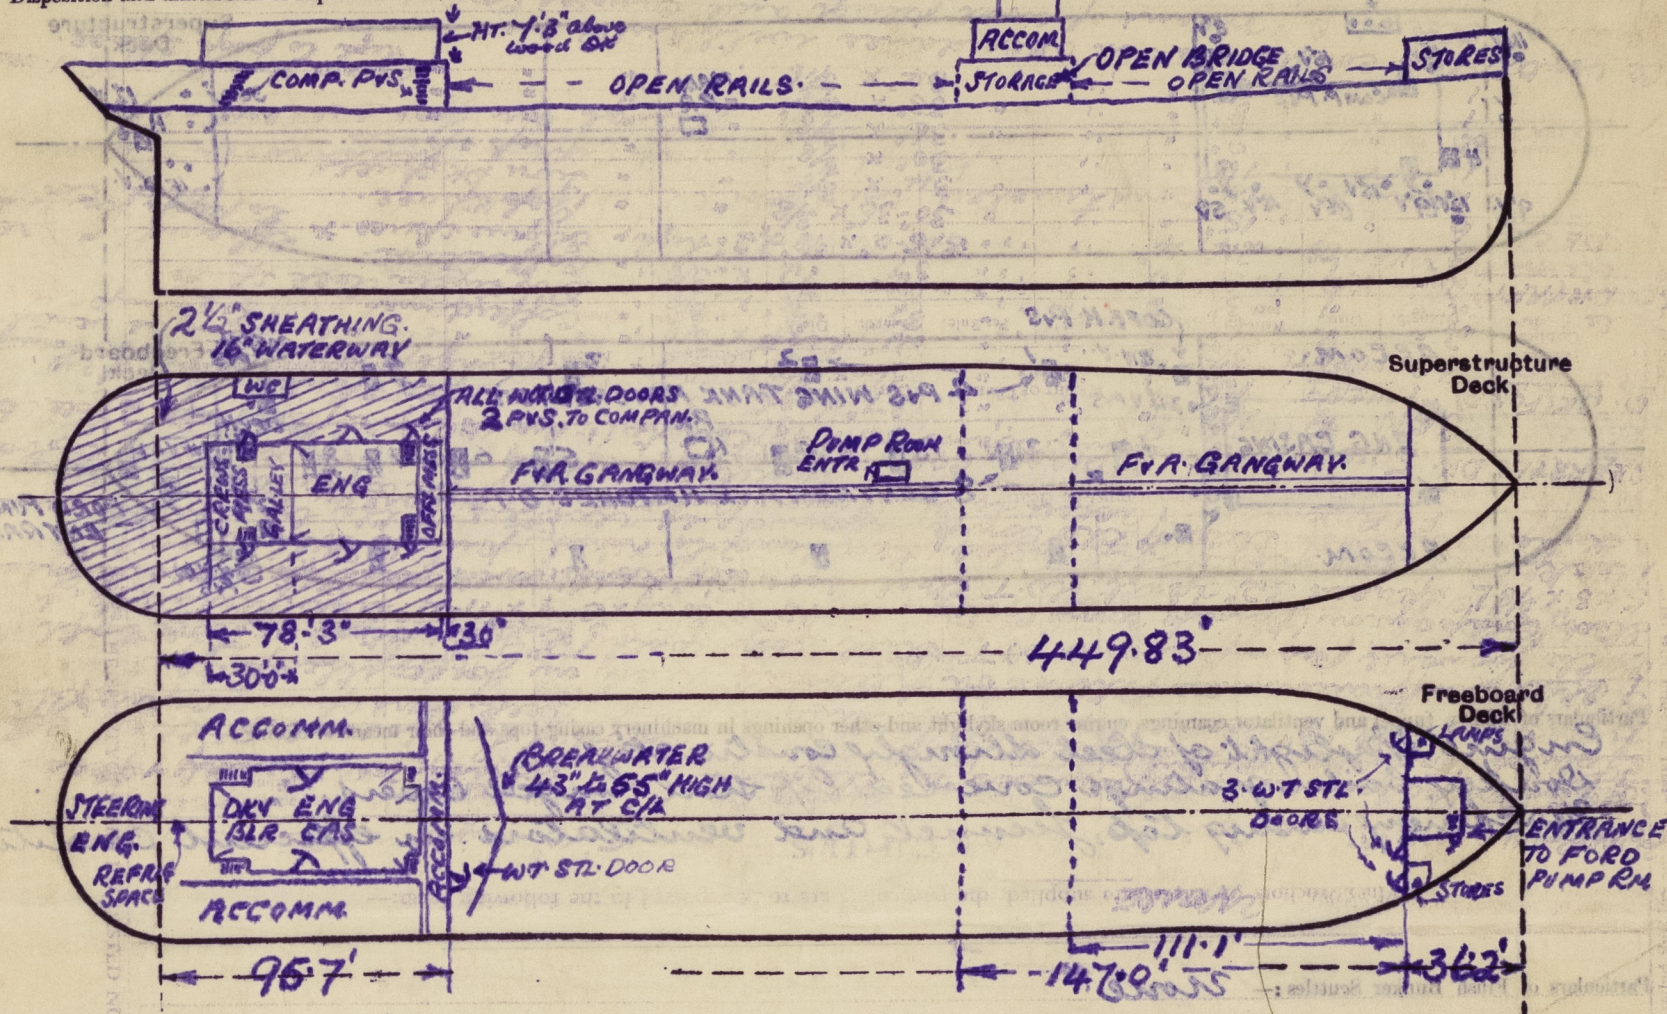

Particulars of Superstructures, Trunks, Casings, Deckhouses.

	Coaming	Plating	Stiffeners	Spacing	End Attachments of Stiffeners	Size of Openings	Height of Sills	Height of Casings
Poop Bulkhead ...	—	1/16"	accom. sheathing in way.	25" to 28"	Bkls T & B	(1) 5'-0" x 2'-2"	18"	—
Raised Quarter Deck Bulkhead ...	—	2 x 1/16"	—	—	—	—	—	—
Bridge, After Bulkhead ...	—	—	—	—	—	—	—	—
Bridge, Forward Bulkhead ...	—	—	—	—	—	—	—	—
Forecastle Bulkhead ...	—	3/8"	3 1/2" x 3" x 3/8" L ^s	31"	none	(2) 2'-0" x 4'-10" (1) 2'-4 1/2" x 5'-0"	18 1/2"	—
Trunk, Aft ...	—	—	—	—	—	—	—	—
Trunk, Forward ...	—	—	—	—	—	—	—	—
Exposed Machinery Casings on Freeboard or Raised Quarter Decks ...	—	3/8"	5' x 3" x 3/8" L ^s	33"	none	(2) 5'-0" x 2'-4"	16"	7'-3" ABOVE SHEATHING
Exposed Machinery Casings on Superstructure Decks ...	—	3/8"	5' x 3" x 3/8" L ^s	33"	none	(2) 5'-6" x 2'-6"	12"	—
Machinery Casings within Superstructures not fitted with Class I Closing Appliances ...	—	—	—	—	—	—	—	—
Deckhouses on Flush Deck Ships ...	—	—	—	—	—	—	—	—

Particulars of Closing Appliances (state if capable of being manipulated from both sides).

Poop Bulkhead ...	1 STARBOARD W.T. Steel door, with 6 cleats operated from both sides.
Raised Quarter Deck Bulkhead ...	—
Bridge, After Bulkhead ...	—
Bridge, Forward Bulkhead ...	—
Forecastle Bulkhead ...	2 STARBOARD W.T. Steel door, with 2 cleats operated from both sides.
Exposed Machinery Casings on Freeboard or Raised Quarter Decks ...	—
Exposed Machinery Casings on Superstructure Decks ...	1 P/S to engine room, W.T. Steel door, operated from both sides.
Machinery Casings within Superstructures not fitted with Class I Closing Appliances ...	1 P/S to engine room, Steel door, operated from both sides.
Deckhouses on Flush Deck Ships ...	—

604055-004061-0233

PARTICULARS OF PROTECTION TO OPENINGS, ETC.

		FREEBOARD DECK HATCHWAYS ON FREEBOARD			AND SUPERSTRUCTURE DECKS.	
Description of Hatchway	...	DRY CARGO HATCH	CENTRE CARGO TANKS (8)	WING CARGO TANKS (8)	Small Hatches	
Dimensions of Hatchway	...	6'-10" x 10'-0"	5'-9" x 5'-9"	5'-8" x 5'-8"	Hd. St. in Fore Space - Peak Hatch 45" x 48"	
COAMINGS	Height above Deck	33" + 3 1/2"	34 1/2"	31"	Coam. 9" x 3" B.A. 7/8 WT. Steel Cover, 8 cleats.	
	Thickness	3/8"	3/8"	3/8"	Hd. Deck - 2 P+S to Cofferdams 26" x 18"	
	Sides	Coam. 9" x 3 1/2" Channel, 3/8" Stl. plate.	
	Ends	Bolts spaced 3 1/4" apart	
HATCH BEAMS	Number	Forecastle Deck Small Hatch 2'-0" x 2'-0"	
	Spacing	Coam. 24" x 3/8" WT. Stl. Cover, 2 cleats	
	Scantling and Sketch	Roof St. Starb. aft. to poop space 38" x 35"	
	Bearing Surface	Coam. 22" x 3/8" Rest 2', covers 2 1/2', 2 tarps.	
FORE AND AFTERS	Number	8 cleats.	
	Spacing	Also on freeboard deck, 1 opening 12" x 18"	
	Unsupp. Lengths	in way of each cargo tank & fuel	
	Scantling and Sketch	bunkers for Butterworth Steaming out	
HATCH COVERS	Material	System. Fitted with watertight	
	Thickness	Galv'd Steel cover plate flush with	
	How fitted	deck.	
	Bearing Surface	
Spacing of Cleats
Number of Tarpaulins

*Are wood fore and afters steel shod at all bearing surfaces? -

Are battens and wedges efficient and in good condition?

Are tarpaulins in good condition and in accordance with rule requirements?

Are lashings provided in accordance with rule requirements?

Particulars of any special features: — none.

Vessel has been satisfactorily submitted to Full Special Survey No. 3 at this time and extensive repairs carried out.

Endorsement at first survey and at surveys for renewal of Certificate:—

The fittings and appliances are in accordance with the particulars shown on this form (or as now modified) and are in good condition.

The fittings and appliances are in accordance with the particulars shown on this form, and are in good condition.

Wm Rennie.



© 2020

Lloyd's Register Foundation