


Office

not read. of the  
 Soc.

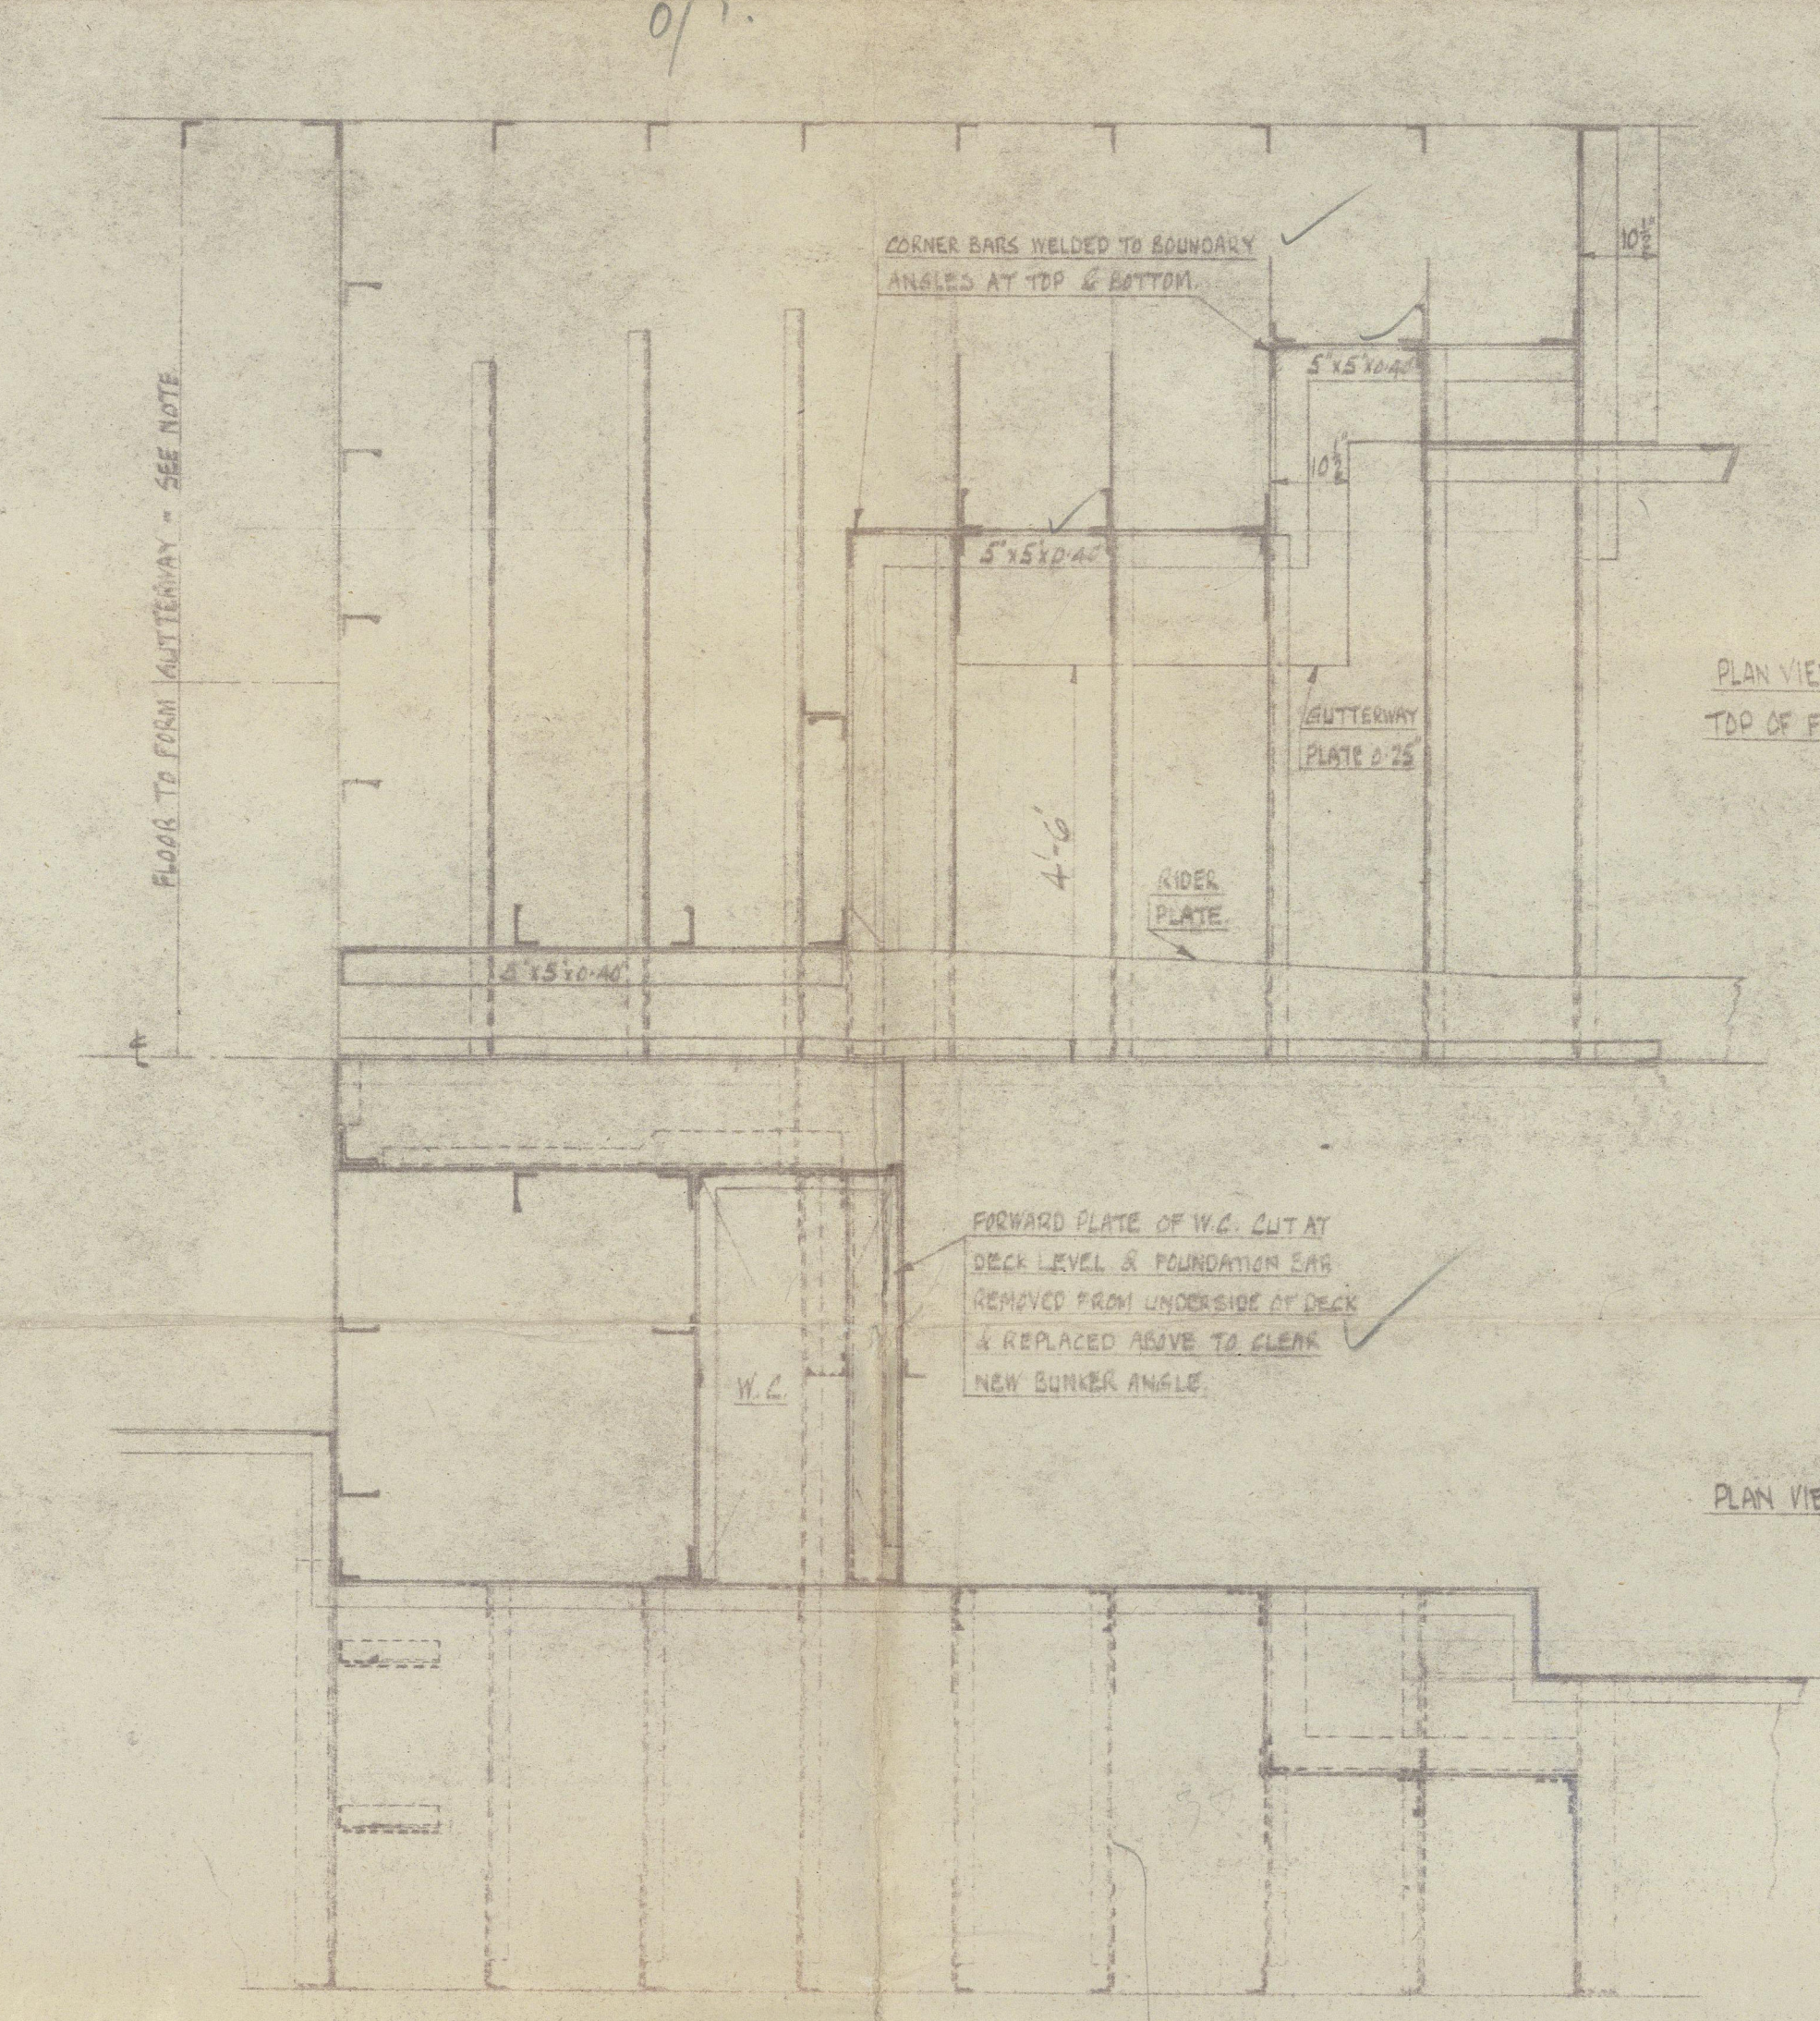

ENLARGED DETAIL SHOWING ATTACHMENT  
OF CROSS RUNNER AND TO CENTER KEELS  
6' FORD OF FR 25  
LOOKING AFT

Office

29.11.46

VOEGER LTD., PORTSMOUTH  
SHIPBUILDERS &  
ENGINEERS  
6 NOV 1946  
SHIP DRAWING OFFICE