


Lloyd's Register of Shipping.

SURVEYS FOR FREEBOARD.

(CONDITIONS OF ASSIGNMENT.)

Ship's Name	EMPIRE LILLIPUT.	Port of Survey	PORTSMOUTH.
Official Number	169094.	Surveyor's Signature	<i>Edmund</i>
Nationality and Port of Registry	BRITISH LONDON.	Date of Survey	23.12.46 & 13.1.47

Disposition and dimensions of superstructures, trunks, deckhouses and machinery casings to be inserted in the diagrams and tabular statement :--

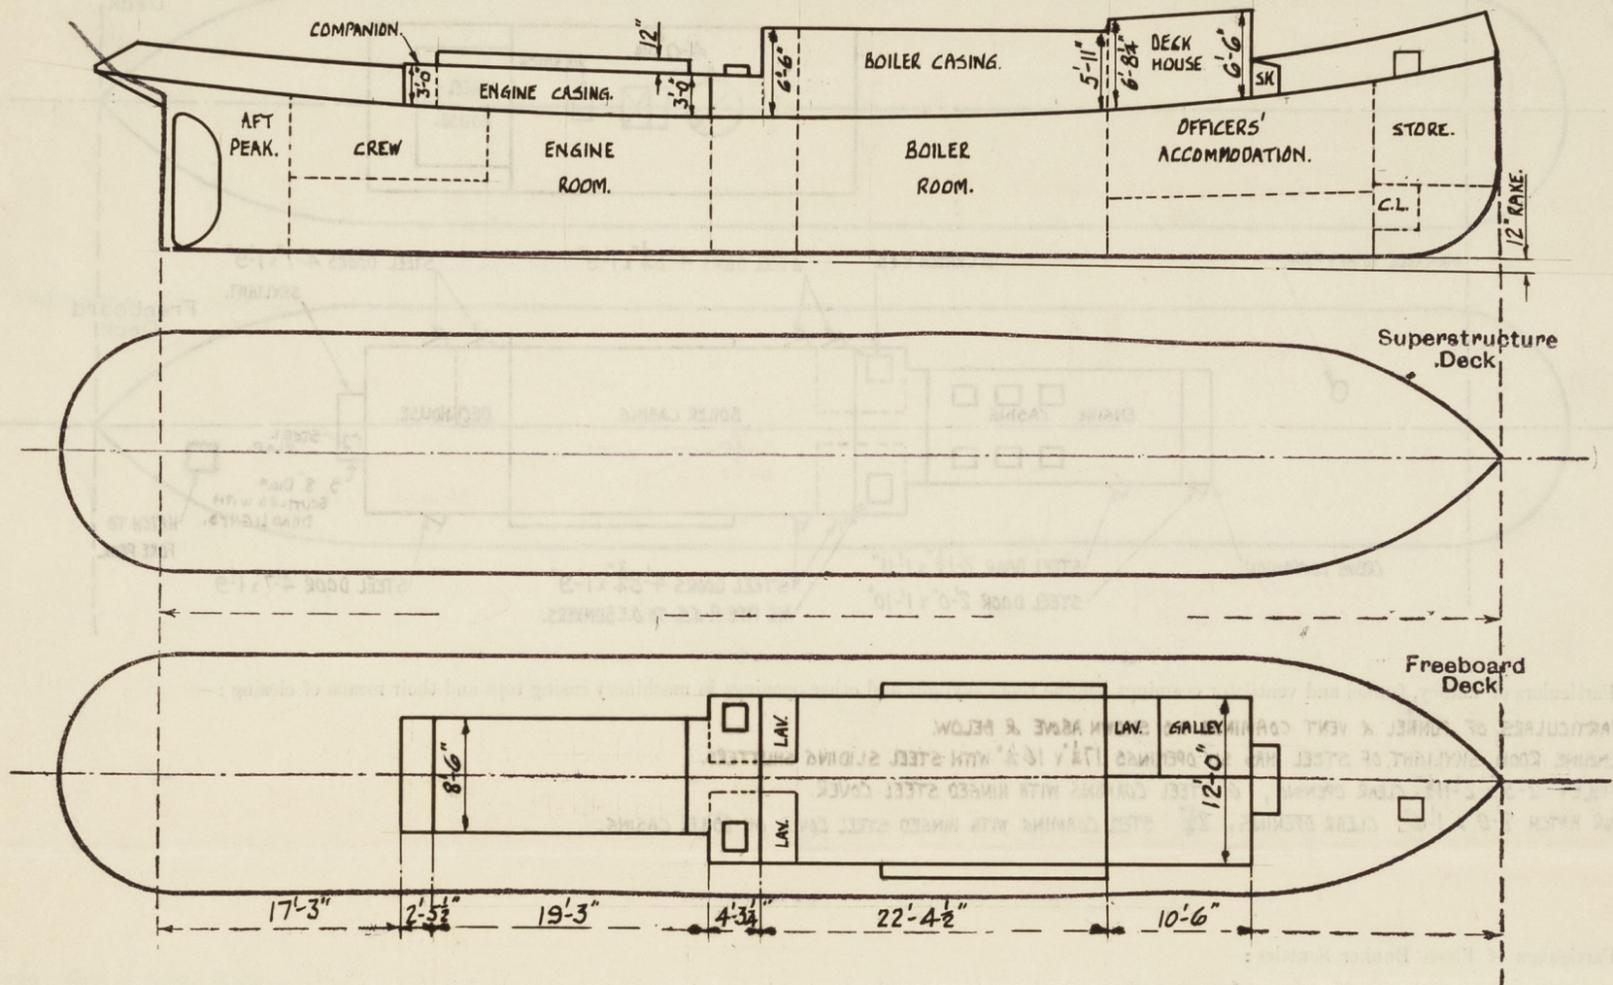

Particulars of Superstructures, Trunks, Casings, Deckhouses.

	Coaming	Plating	Stiffeners	Spacing	End Attachments of Stiffeners	Size of Openings	Height of Sills	Height of Casings
Poop Bulkhead								
Raised Quarter Deck Bulkhead ...								
Bridge, After Bulkhead								
Bridge, Forward Bulkhead								
Forecastle Bulkhead								
Trunk, Aft								
Trunk, Forward								
Exposed Machinery Casings on Freeboard or Raised Quarter Decks ...	17 1/2" x 0-30"	0-26"	3" x 2 1/2" x 0-26"	BOILER CASING 27" ENGINE CASING 45"	BRACKETS TO BEAMS	57" x 21"	18"	B.C. 6'-6" TO 5'-11" E.C. 3'-0"
Exposed Machinery Casings on Superstructure Decks								
Machinery Casings within Superstructures not fitted with Class I Closing Appliances								
Deckhouses on Flush Deck Ships ...	17 1/2" x 0-30"	0-26"	3" x 2 1/2" x 0-26"	28 1/2"	WELDED TO BEAMS.	55" x 21"	19"	6'-8 1/2" TO 6'-6"

Particulars of Closing Appliances (state if capable of being manipulated from both sides).

Poop Bulkhead	
Raised Quarter Deck Bulkhead ...	
Bridge, After Bulkhead	
Bridge, Forward Bulkhead	
Forecastle Bulkhead	
Exposed Machinery Casings on Freeboard or Raised Quarter Decks ...	STEEL DOORS MANIPULATED FROM BOTH SIDES. ✓
Exposed Machinery Casings on Superstructure Decks	
Machinery Casings within Superstructures not fitted with Class I Closing Appliances	
Deckhouses on Flush Deck Ships ...	STEEL DOORS MANIPULATED FROM BOTH SIDES. ✓

PARTICULARS OF PROTECTION TO OPENINGS, ETC.

HATCHWAYS ON FREEBOARD AND SUPERSTRUCTURE DECKS.

Description of Hatchway	FORE PEAK	OIL FUEL BUNKER.							
Dimensions of Hatchway	23" x 23"	24" x 20"							
COAMINGS	Height above Deck	18"	3'-3" ABOVE FREEBOARD DECK. (9" BA ON TRUNK TOP). SEE TEXT.						
	Thickness { Sides	0-30"	0-50"						
	{ Ends	0-30"	0-50"						
	Stiffeners ...	—	—						
Brackets, Stays	—	—							
HATCH BEAMS	Number ...	/	/						
	Spacing ...	/	/						
	Scantling and Sketch	/	/						
Bearing Surface									
FORE AND AFTERS	Number ...	/	/						
	Spacing ...	/	/						
	Unsupported Lengths	/	/						
	Scantling* and Sketch	/	/						
Bearing Surface									
HATCH COVERS	Material	WOOD	STEEL.						
	Thickness	2 1/2"	0-50"						
	How fitted	DROP-IN.	8 TOGGLE BOLTS.						
	Bearing Surface	2 1/2" REST BARS.	GREENY HEMP.						
Spacing of Cleats	18"	—							
Number of Tarpaulins	ONE. Two	—							

- *Are wood fore and afters steel shod at all bearing surfaces? YES ✓
- Are battens and wedges efficient and in good condition? YES ✓
- Are tarpaulins in good condition and in accordance with rule requirements? YES ✓
- Are lashings provided in accordance with rule requirements? YES ✓

Particulars of any special features:—

omit

Endorsement at first survey and at surveys for renewal of Certificate:—

The fittings and appliances are in accordance with the particulars shown on this form (or as now modified) and are in good condition.

9