


24/1/29

Nº 174 145' x 26'-6" x 12'-6" MOULDED.

PROFILE & DECK PLANS.

TO LLOYDS 100A.I. CLASS.


SCALE 1/4" = ONE FOOT.

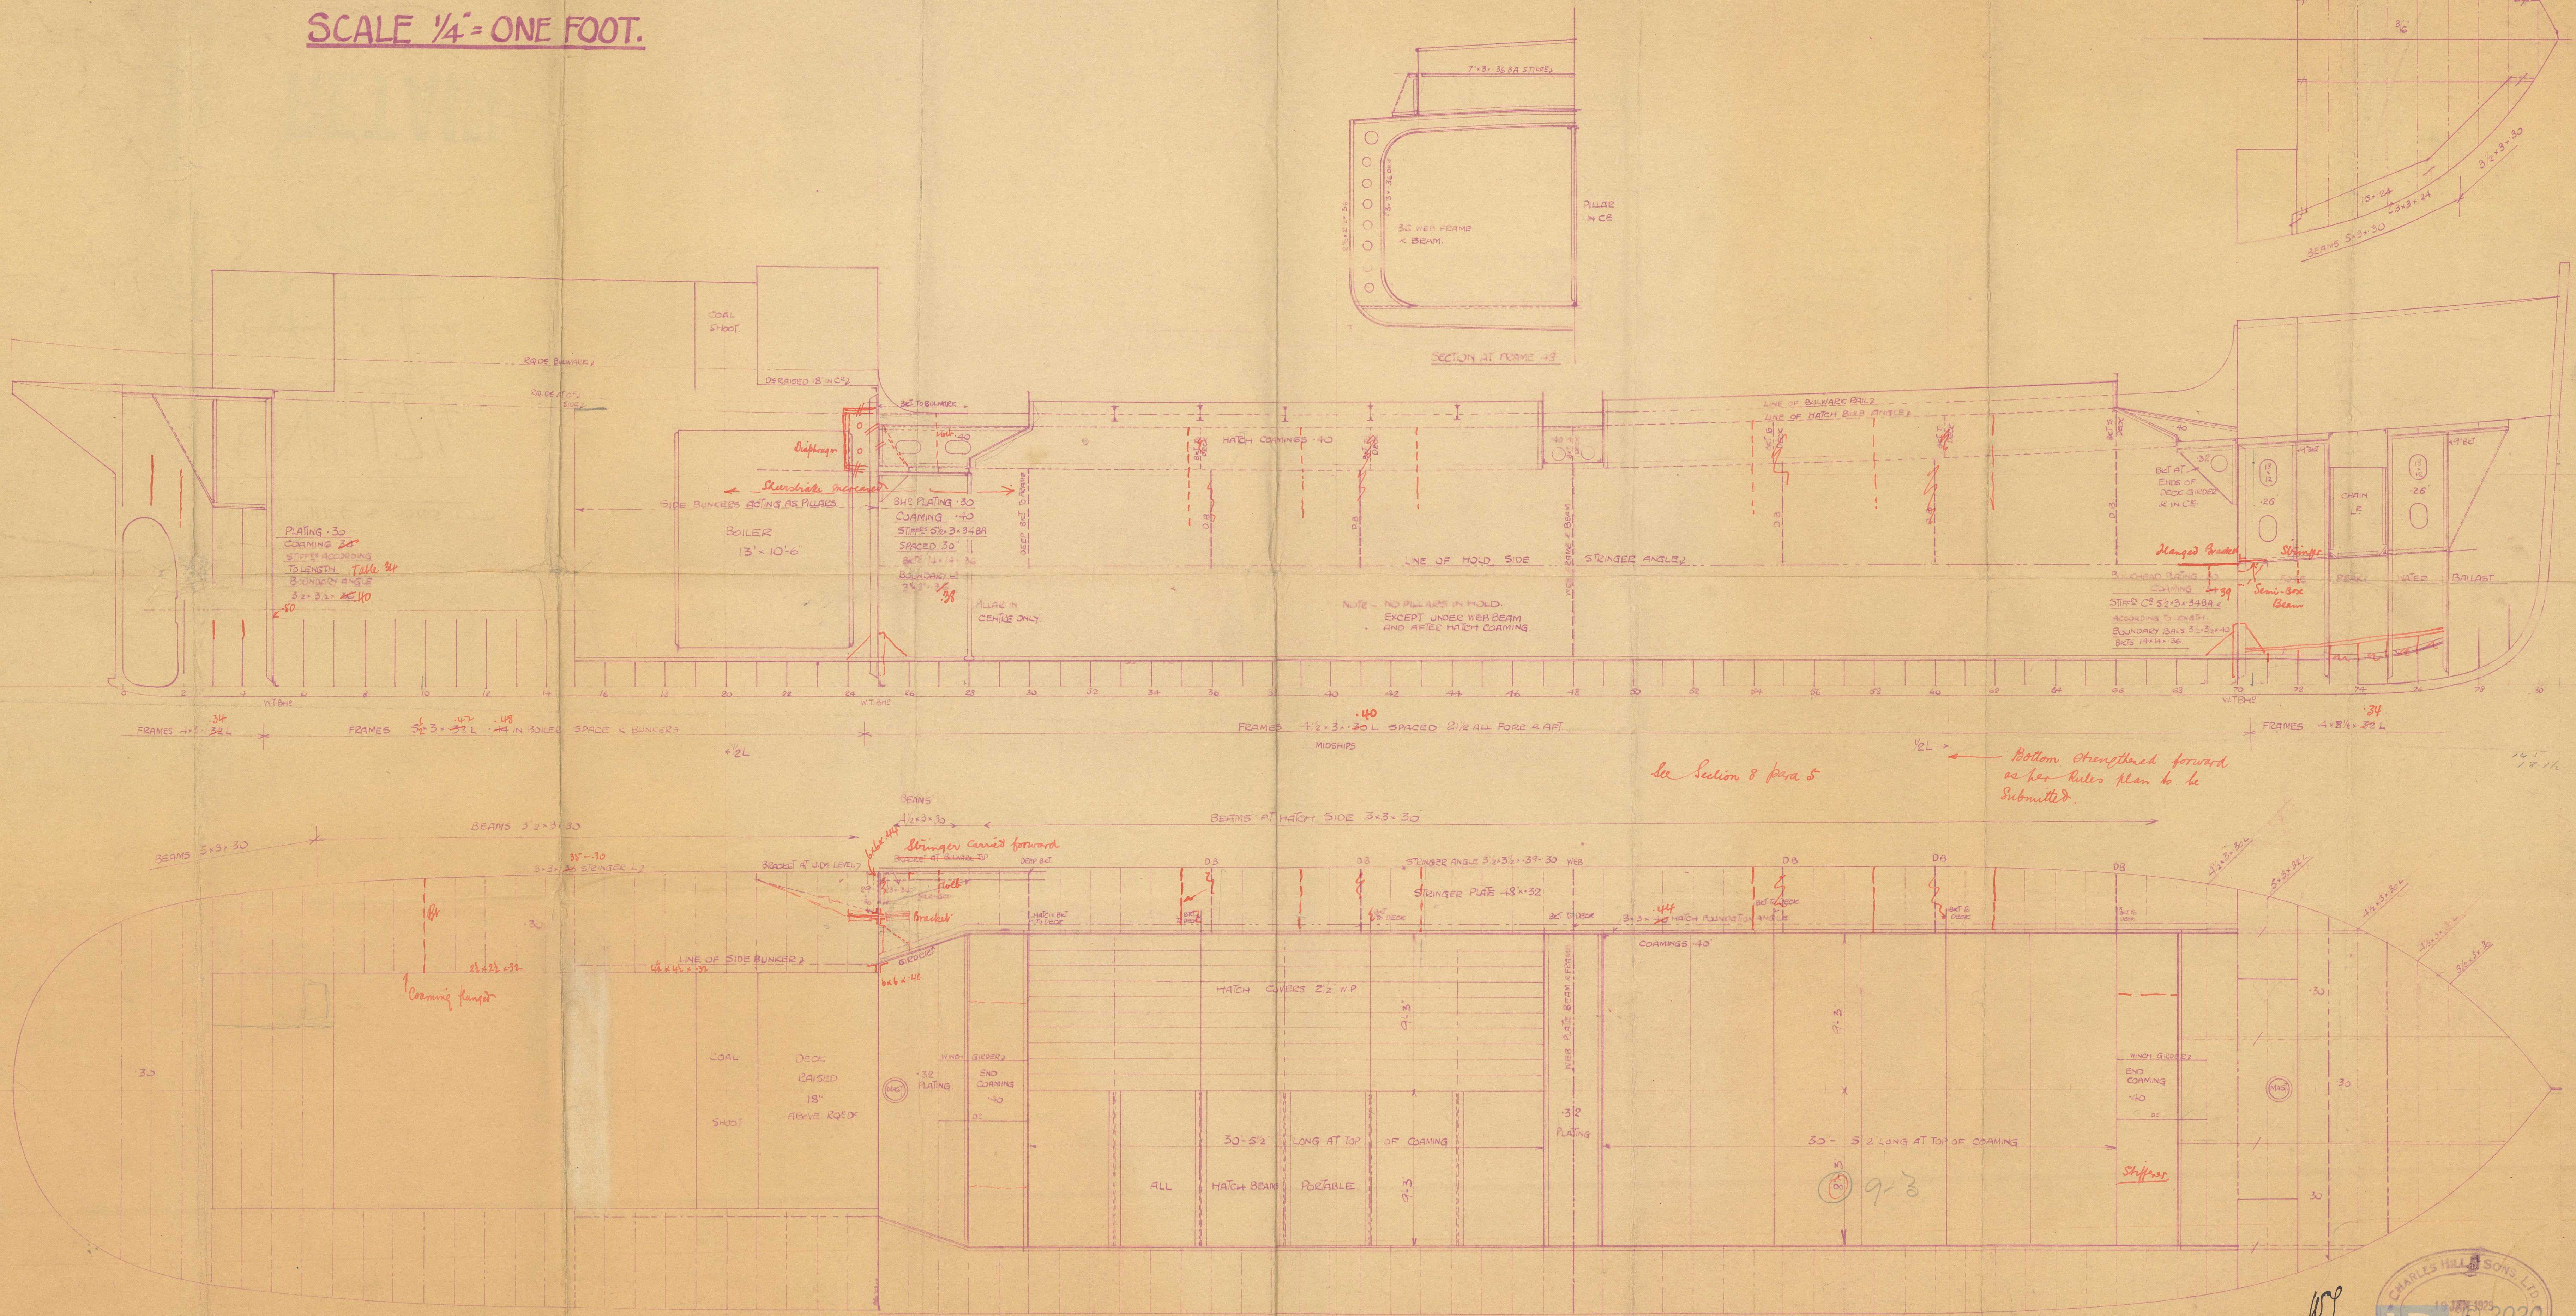

See Section 8 para 5

Bottom strengthened forward  
as per Rules plan to be  
submitted.

23.1.29

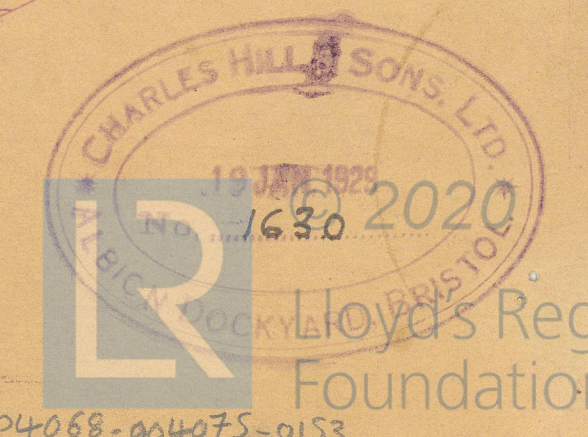



CHAS. HILL & SONS LTD.

N<sup>o</sup> 174

Profile & Deck.

Lloyd Stoke



RETAIN



11-5  
1-7  
3-0



© 2020

Lloyd's Register  
Foundation

004068-004075-0153