

Nº 7.

MIDSHIP SECTION.


LLOYDS DIMS: LENGTH B.P. ON UPPER DECK 399' 6", BREADTH M.P. 52' 66", DEPTH M.P. 26' 92"

TO CLASS 100 A1 LLOYDS: SHELTER DECK WITH FREE BOARD.

Scale: 1" = 1' 00"

NUMERALS	
BREADTH M.P.	52' 66"
DEPTH	26' 92"
+ 5 FOR 8' 6" TWEEN DECK	50
TRANSVERSE NUMBER	80 08
LENGTH B.P.	399' 6"
LONGITUDINAL NUMBER	31999
ERECTOR CASINGS ETC	3617
EQUIPMENT NUMBER	35616
LENGTH + DEPTH TO SHELTER DECK	11' 28"
	23' 34"

EQUIPMENT	
2 BOWER ANCHORS EACH	13 CENTS STOCKLESS
1 ANCHOR	542
1 STREAM	172 EX STOCK
1 KEDGE	72
270 FATHOMS	2 1/2 STUD CHAIN CABLE
90	4 1/2 STEEL WIRE
120	5 TOWLINE
90	3 HAWSER
90	3
2 @ 90	22

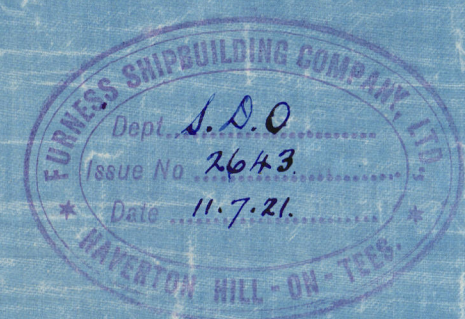

S.Nº 187.

Friend - Furner S. B. & Co

Nº 7.

S. S. ^{EX}ABODI-MENDI

MIDSHIP SECTION

(AS. BUILT)

N/N "MONTE SERANTES"

Trab. Rpt. hº 11059

RETAIN

004093-00400-0024



© 2020

Lloyd's Register
Foundation

RECEIVED
JUL 13 1921
LLOYD'S REGISTER.
MIDDLEBROUGH.



© 2020

Lloyd's Register
Foundation

2024 1/2

FOR ENCLOSURE TO

Lloyd's Register of Shipping
Middlesbrough.

From FURNESS SHIPBUILDING CO. LD.
HAVERTON HILL-ON-TEES.