

NEWCASTLE-ON-TYNE, N. F. 342.

Rpt. C. 11 (Contd.)

Index No.




Lloyd's Register of Shipping.

Ship's Name S. S. "WAVE KNIGHT."Official No. 180875

Memorandum of alterations reported since ship was surveyed for assignment of Load Lines in _____

Butterworth openings, 12" dia. are cut in upper deck in way of cargo tanks. Openings being closed by steel plates attached by studs.

Positions relative to cargo hatches are shown in sketch below.

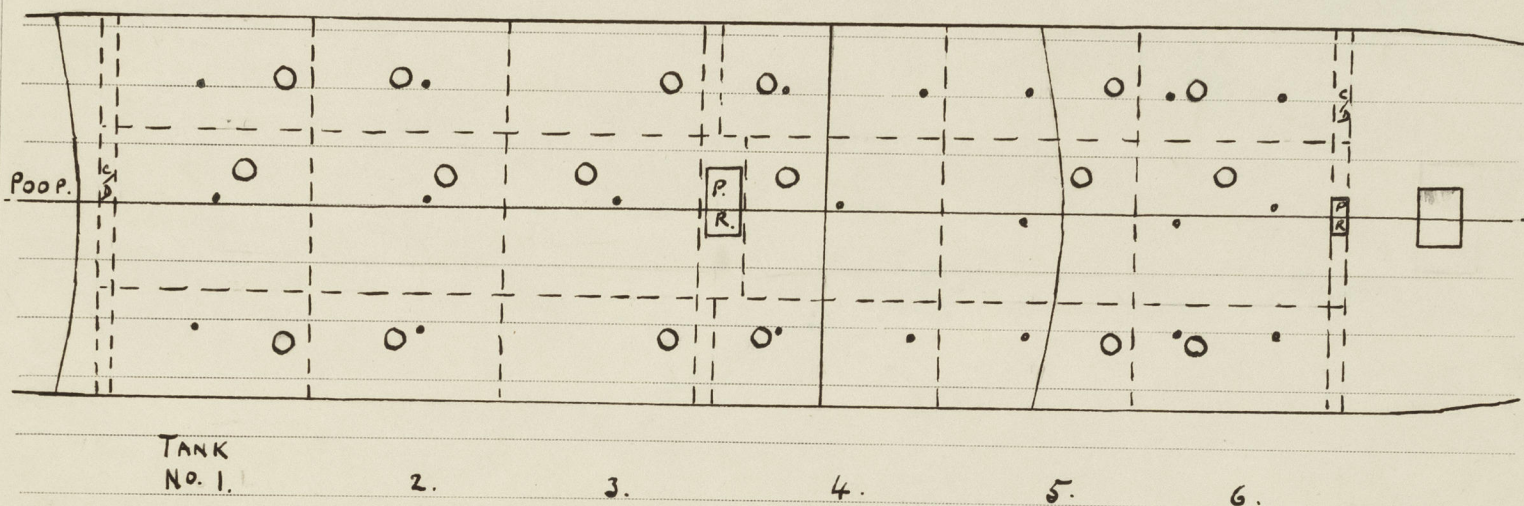

Cargo Hatches shown :- ○

Butterworth openings shown :- .

James. W. X. Keay.

Newcastle-on-Tyne.

6th. July 1951.

a copy of this report has been placed on board the vessel.



© 2020

Lloyd's Register
Foundation