

- 5/8 No 200 -

- DIMENSIONS -

LENGTH BETW R.R.	265'-0"
BREADTH MOULDED	39'-0"
DEPTH MOULDED TO MAINDECK	19'-6"
HEIGHT BETW MAIN & SECONDECK	7'-6"
HEIGHT OF POOP & FORECASTLE	7'-6"
DRAFT MOULDED	17'-2 1/2"

SCALE: 1/8" = 1'-0"


CAPACITIES		
	GRAIN	BALE
HOLD NO. 1	8000	
NO. 2	13500	13500
NO. 3	9100	9100
NO. 4	9800	
TOTAL LOW HOLDS	33300	22600
TWEENDECK NO. 1	4400	
NO. 2	11000	11000
NO. 3	7300	7300
NO. 4	12700	12700
TOTAL TWEENDECK	35400	31000
POOP	11000	
NO. 4	20000	
TOTAL IN POOP	31000	
FORECASTLE	6000	
TOTAL	111000	
CROSS BUNKER	130 TONS @ 42 C	
SIDE BUNKERS	80 TONS @ 45 C	
TOTAL BUNKERS	185 TONS	

RECEIVED
HULL & MACHINERY
DRAWING NO. 200
TECHNICAL
NO. 55412
20-2-91

GENERAL ARRANGEMENT.
(AS BUILT)

S/S ALEXANDRA

MESSRS HESLINGORS TERNS. & MASL.

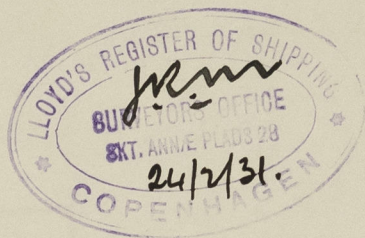

RETAIN



© 2020

Lloyd's Register
Foundation

004116-004124-0188