


SCALE $\frac{1}{8}" = 1 \text{ FOOT}$

DIMENSIONS
190'-0" x 30'-6" x 14'-6"

"Empire Harvest"
pls. 67910.

N. N. B. P. Engineer

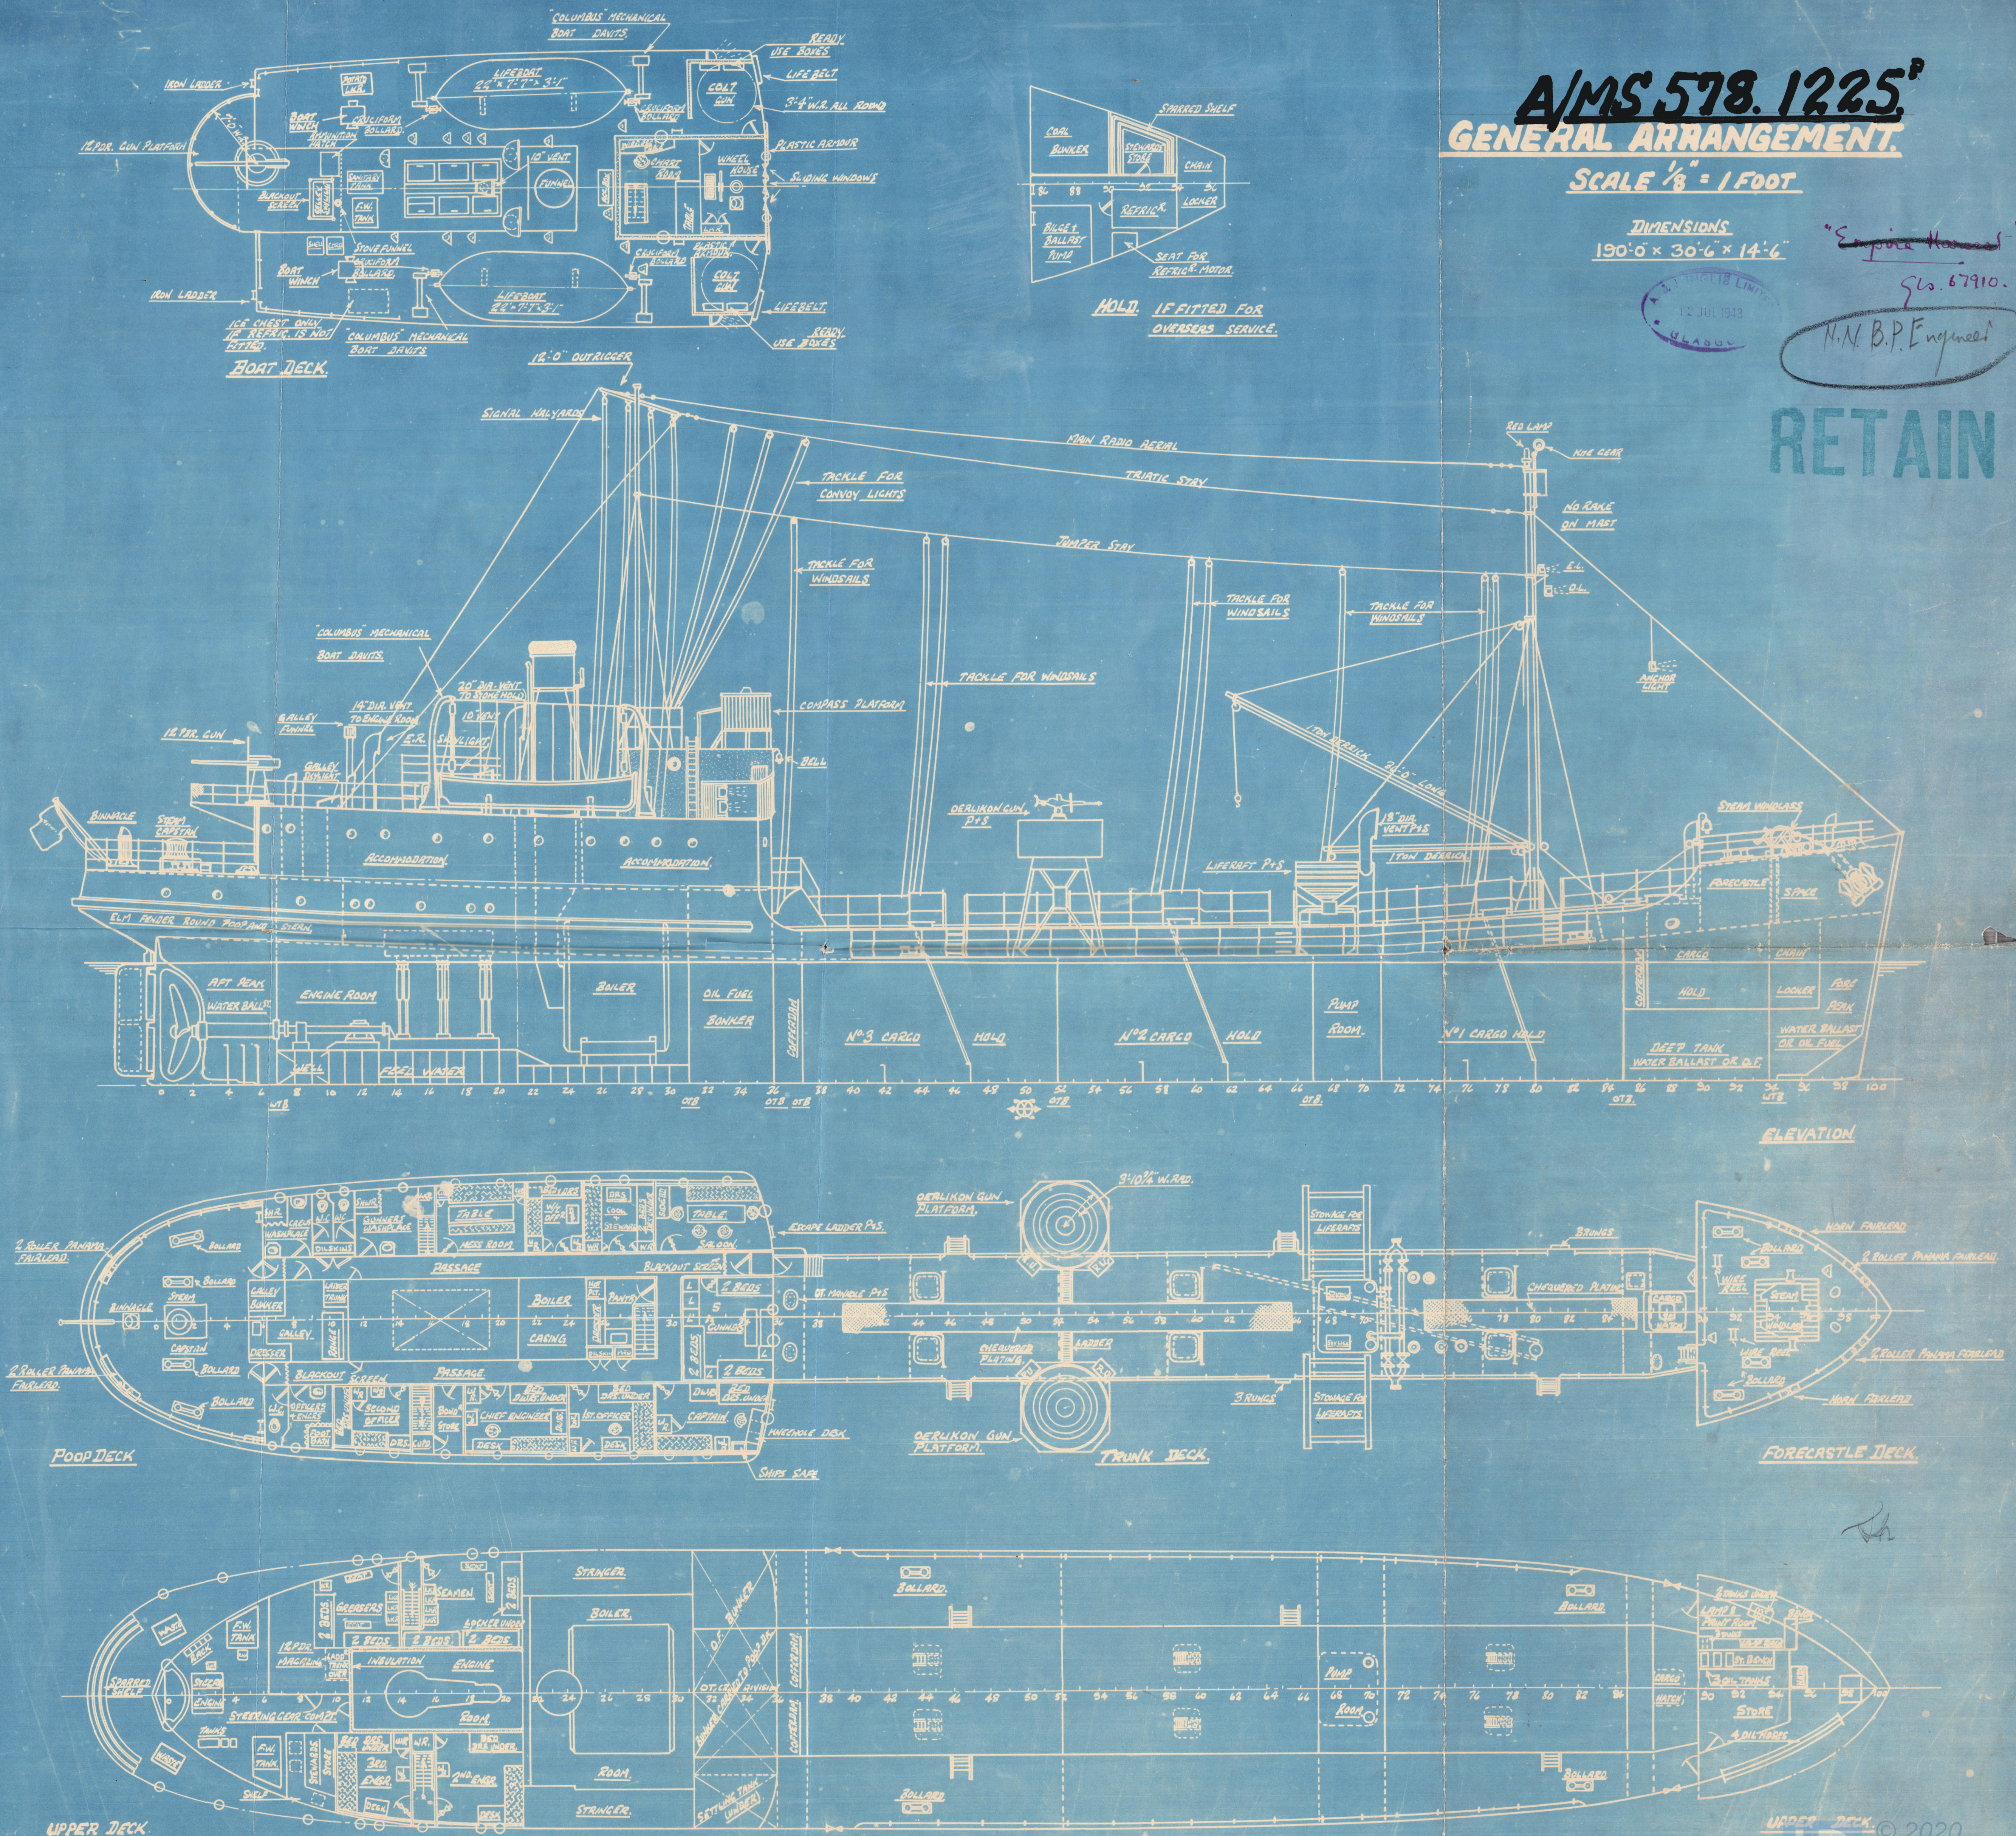

UPPER DECK. © 2020

15
11
12 73
38
11
49

(24)



© 2020

Lloyd's Register
Foundation

G. G. Dobre.
D. D. M. B. (H)
30:7:43.



© 2020

Lloyd's Register
Foundation

004116-004124-0193