

6 FEB 1948

PETROLEUM SLUDGE VESSEL "NORDLAND."

TO CLASS A.I. FOR SERVICES IN & BETWEEN PORTS IN THE BRITISH ISLES.

LENGTH B.P. 146.1 FT. BREADTH MLD 28.5 FT. DEPTH MLD 15.3 FT.

LLOYDS NUMERALS: 1ST LONG N° 2159 2ND LONG N° 5390.


EQUIPMENT N° 5557

2 STOCKLESS BOWER ANCHORS 3 CWT EACH.
1 STREAM ANCHOR 3 CWT. *or 3 3/4 CWTs. Stockless*
165 FATHOMS OF 1" STUD LINK CABLE.
45 " 1/16" STREAM CHAIN.
75 " 2 1/2" STEEL WIRE TOWLINE.
90 " 2" F.S.W.R. HAWSER.

STEM BAR 6" x 1 3/4" ✓
BAR KEEL 6" x 2" ✓
STERN FRAME 7 1/2" x 5 1/2" ✓
RUDDER POST 7 1/2" x 5 1/4" ✓
RUDDER HEAD 6" DIA. ✓

RIVETING.

SHELL PLATING 5/8 DIA^R RIVETS 4 DIA^R SPACING.
SHELL FRAMES 5/8 " " 7 " " ✓
DECK PLATING 1/2 " " 7 " " ✓
DECK BEAMS 5/8 " " 7 " " ✓
TANK TOP 5/8 " " 4 " " ✓
ELSEWHERE AS SHOWN. ✓

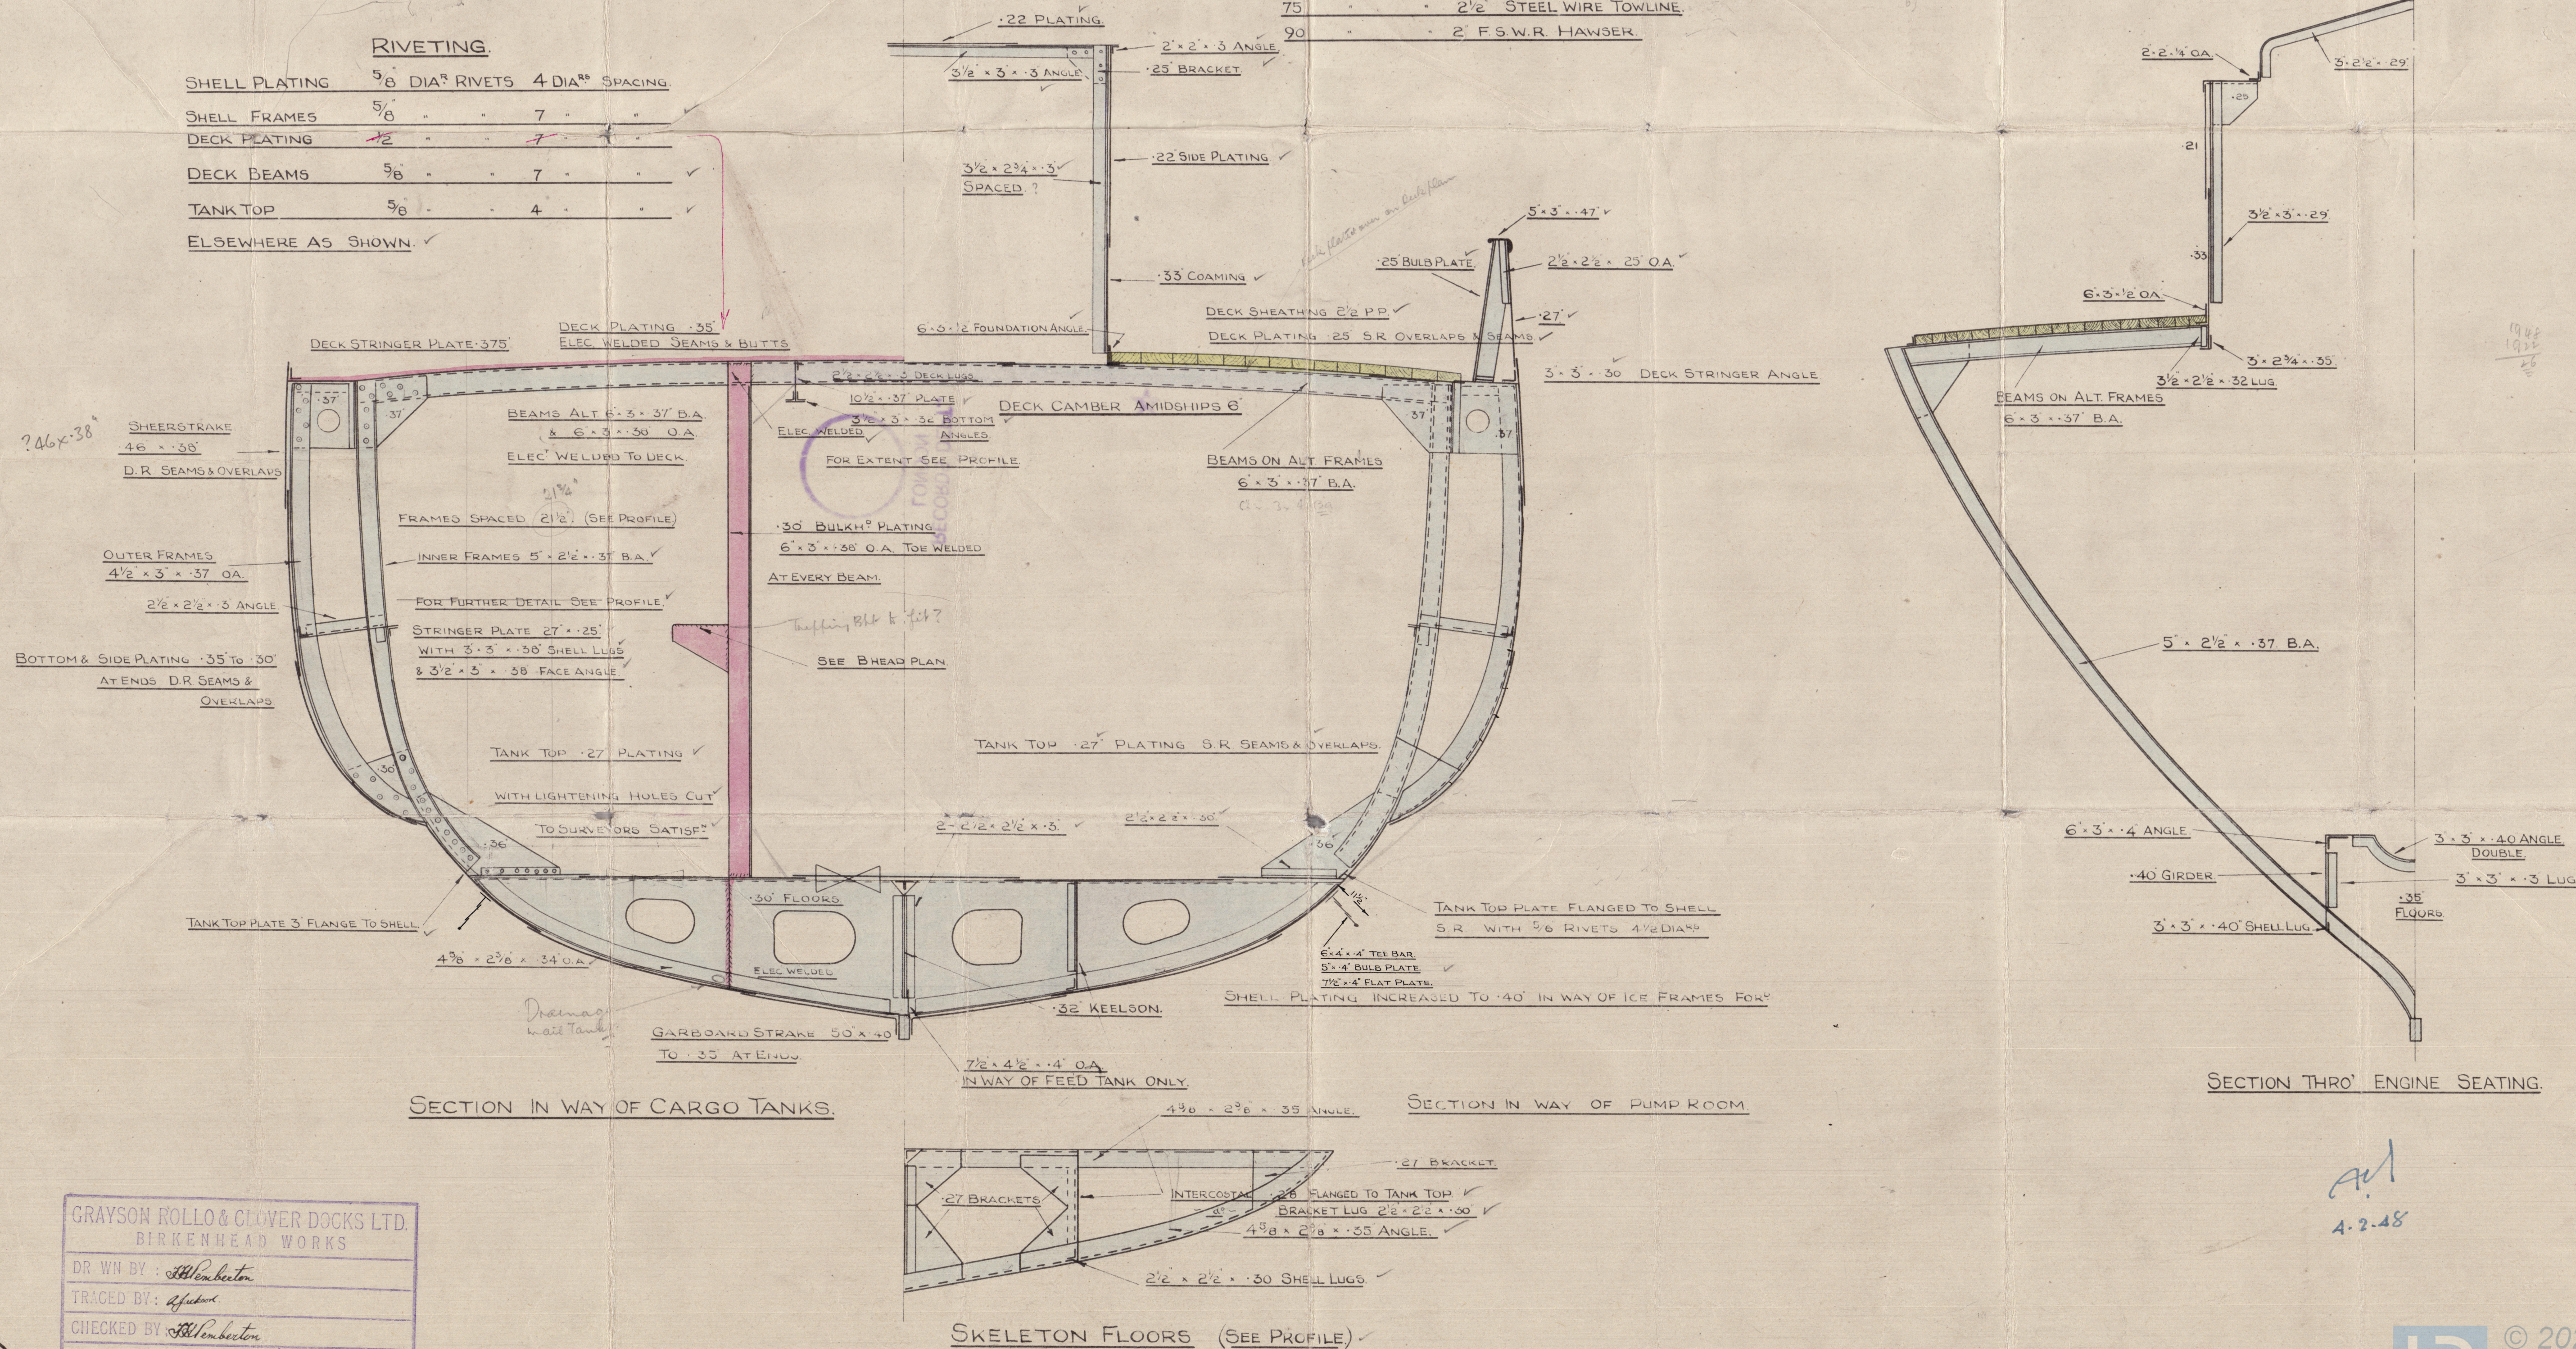

SECTION IN WAY OF CARGO TANKS.

SECTION IN WAY OF PUMP ROOM.

SECTION THRO' ENGINE SEATING.

SKELETON FLOORS (SEE PROFILE)

GRAYSON ROLLO & CLOVER DOCKS LTD.
BIRKENHEAD WORKS
DR. WN BY: *W. H. Burton*
TRACED BY: *W. H. Burton*
CHECKED BY: *W. H. Burton*
DRAWING N°: 6113 DATE 15 JAN 1948

4.2.48

"TULIPFIELD" ★

Midship section

RECORDS DEPT.
LONDON

1

004135-004144-0039

Tulipfield
Midship section