


S.T. "HARGOOD"

DETAIL OF PROPOSED HORIZONTAL GIRDER

FOR

OIL FUEL BUNKERS.

SCALES: $\frac{3}{8}$ AND 1" = 1 FOOT

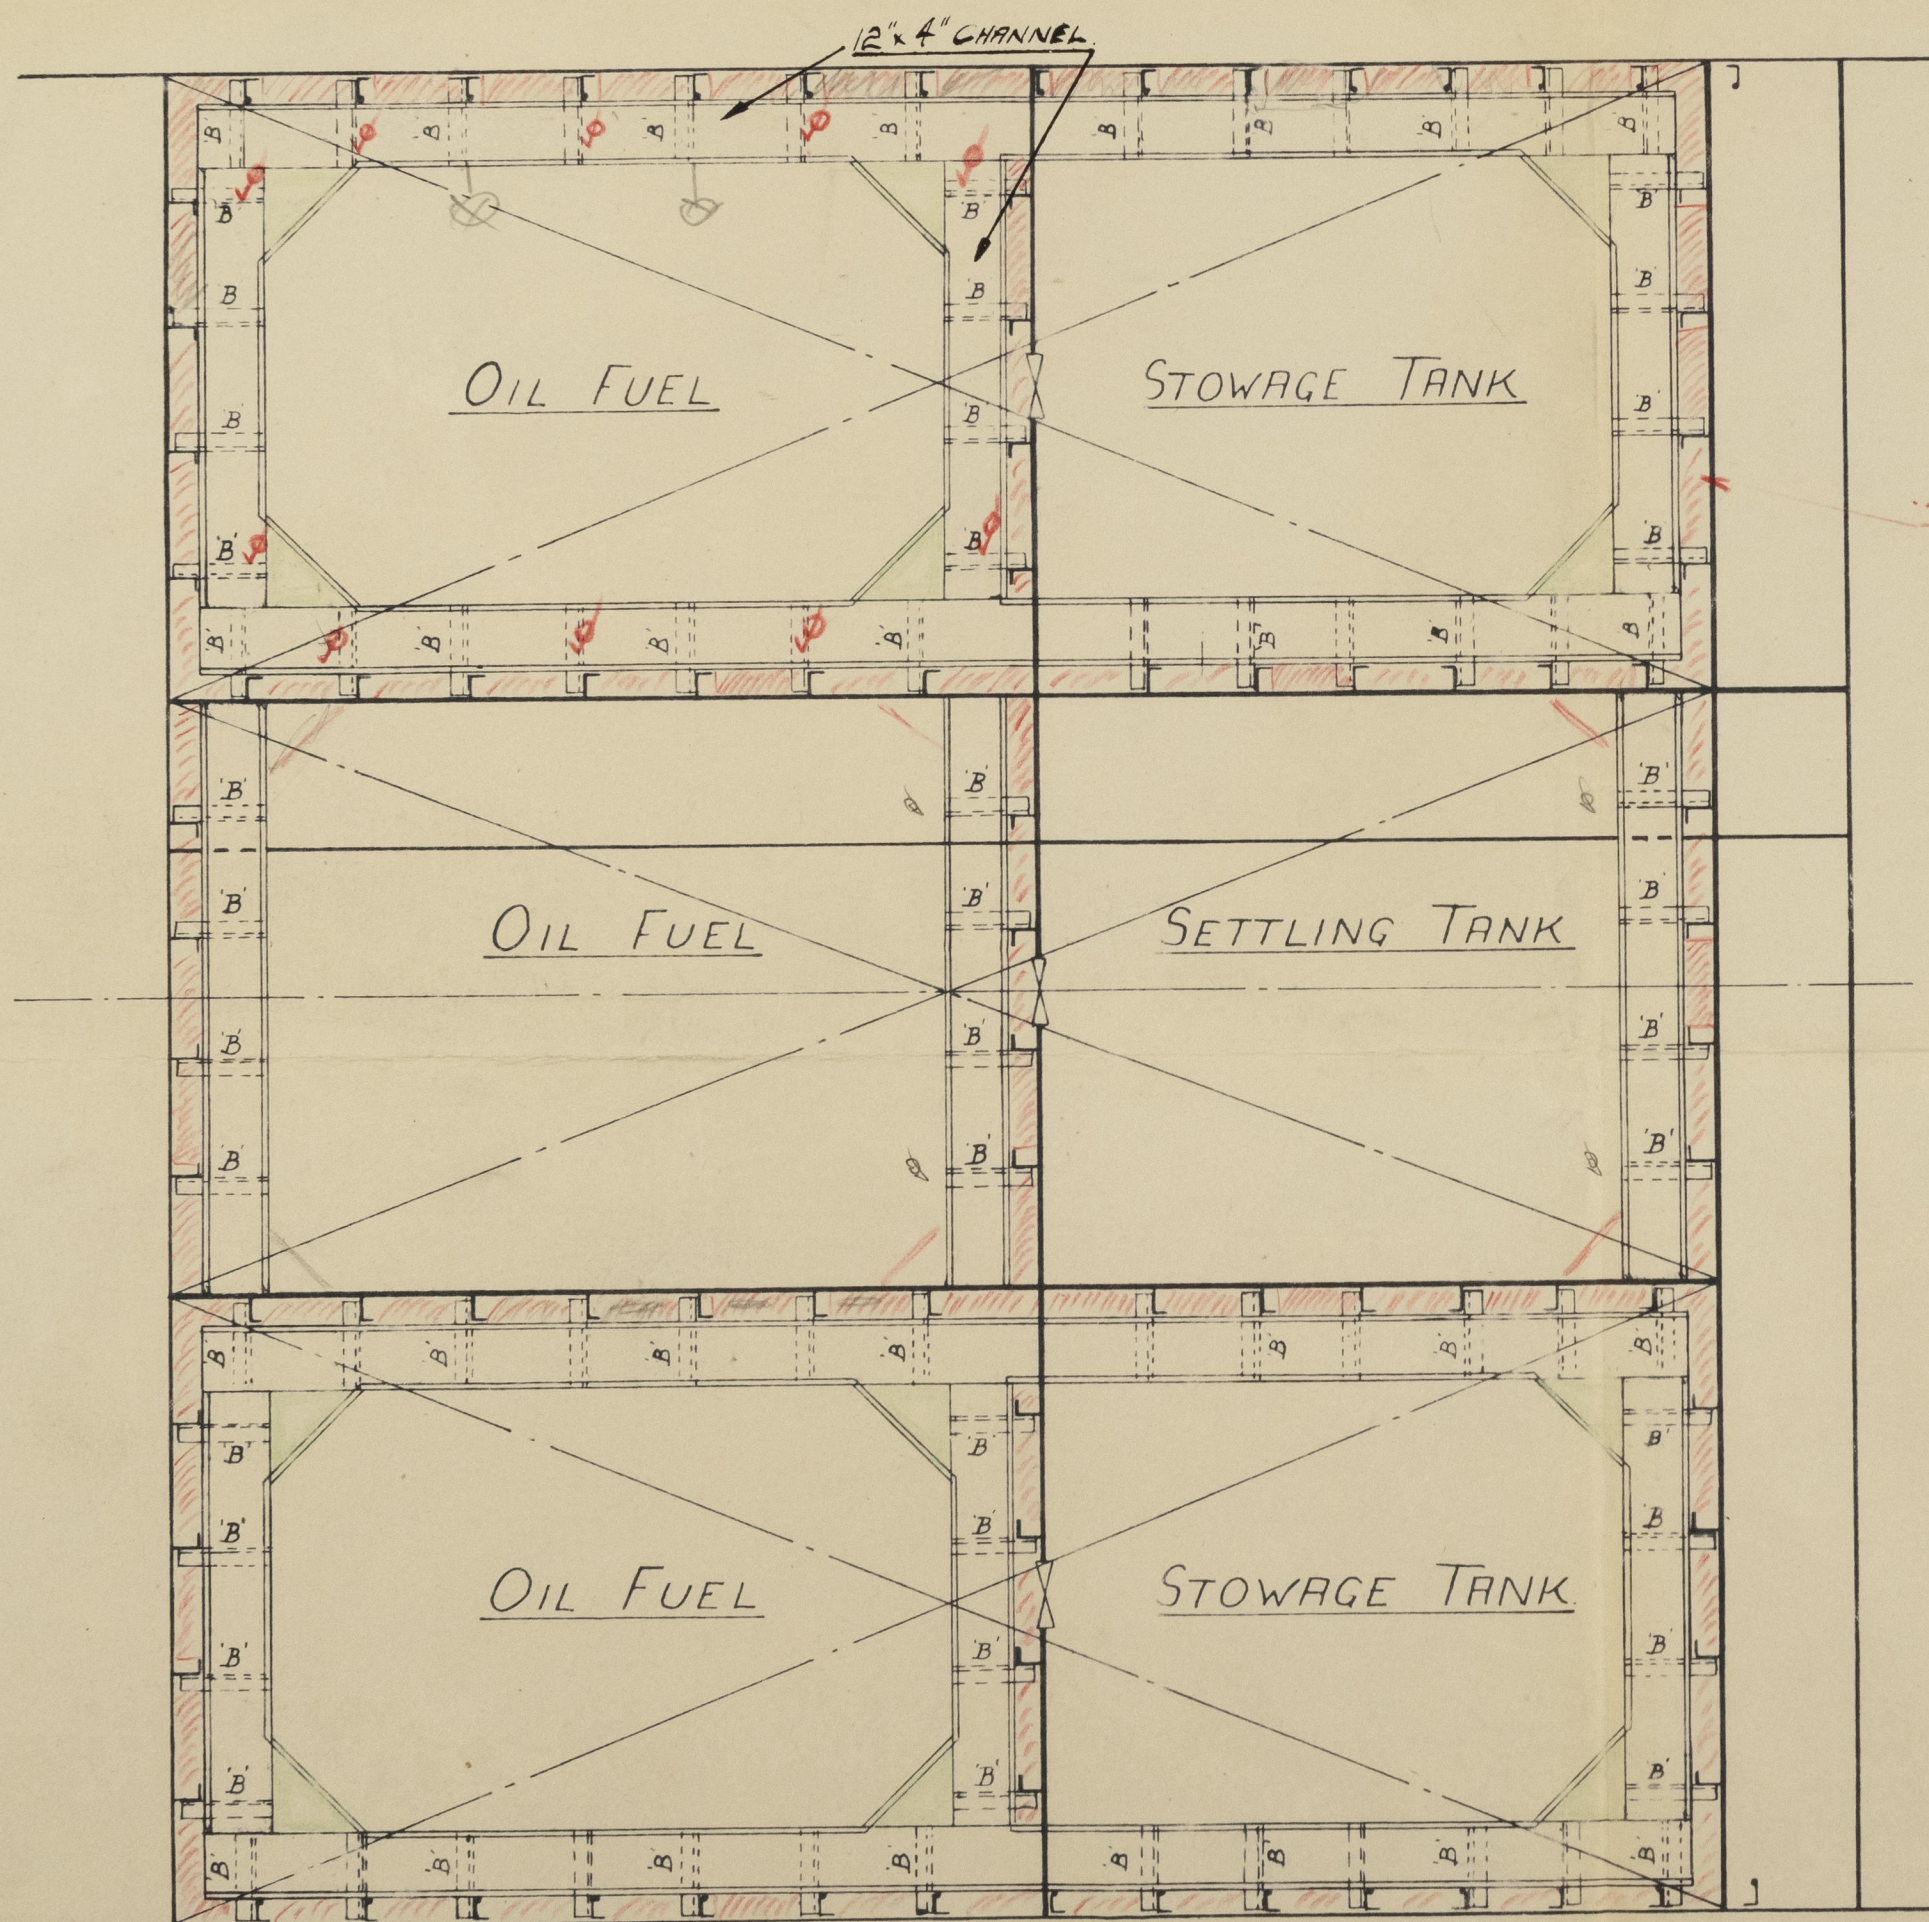

.40" INTC PLATES
THROUGHOUT

RIVETTED

12"x4" CHANNEL 32 lbs per R.F.

RIVETTED

5"x3" ANGLE BRACKET
RIVETTED TO VERTICAL
STIFFENERS & HORIZONTAL
GIRDER.

PLATE BRACKET WHERE
MARKED THUS

5"x3"x $\frac{3}{8}$ " ANGLE
RIVETTED.

WELD

BRACKETS CUT
FROM 12"x4" CHANNEL
WELDED

22.9.49

© 2020

LEAKE & WILSON
Consulting Engineers & Architects
120 ALFRED GELDER STREET
FOULDA

004135-004144-0088

GRIMSBY.

S/T. "HARGOOD"

Detail of Horizontal Section for

O.F. Bunkers.

Gms rept No. 23988.



© 2020

Lloyd's Register
Foundation

004135-004144-0088