

S. S. SHAHZADA

PROFILE AND DECKS








S.S. N^o 1013

SCALE: 1/4" = 1'-0"

DIMENSIONS: 404'-0" B.P. ON L.W.L. x 54'-0" EXT. x 53'-9" M.L.D. x 31'-3" M.L.D. TO UPPER DECK
TO CLASS 100 A1 AT LLOYD'S SPECIAL SURVEY

SHEER FORWARD	= 120"
1/4" L	= 67"
1/4" AFT	= 60"
1/4" L	= 55"
ROUND OF BEAM	= 31"
TUMBLE HOME AT BRIDGE DECK	= 12"
TUMBLE HOME AT UPPER	= 4 1/2"

ALL B.A. SCANTLINGS ARE N.B.B.

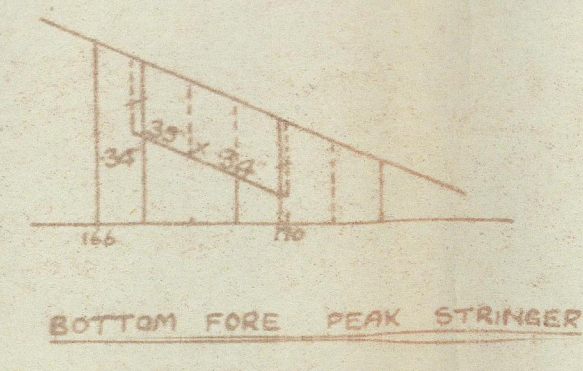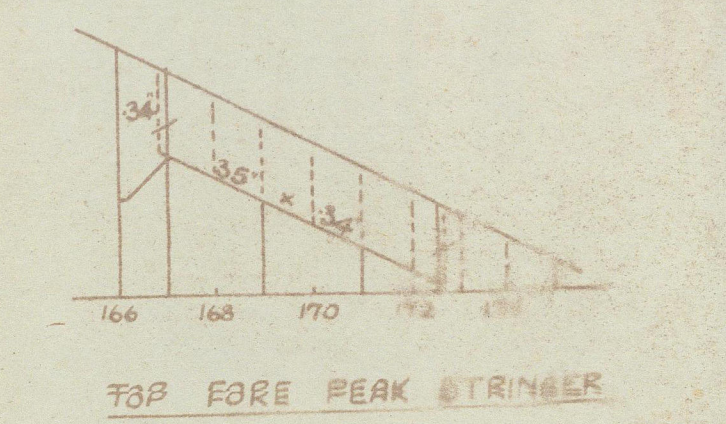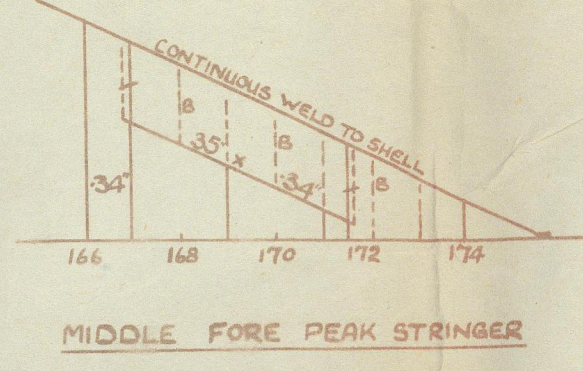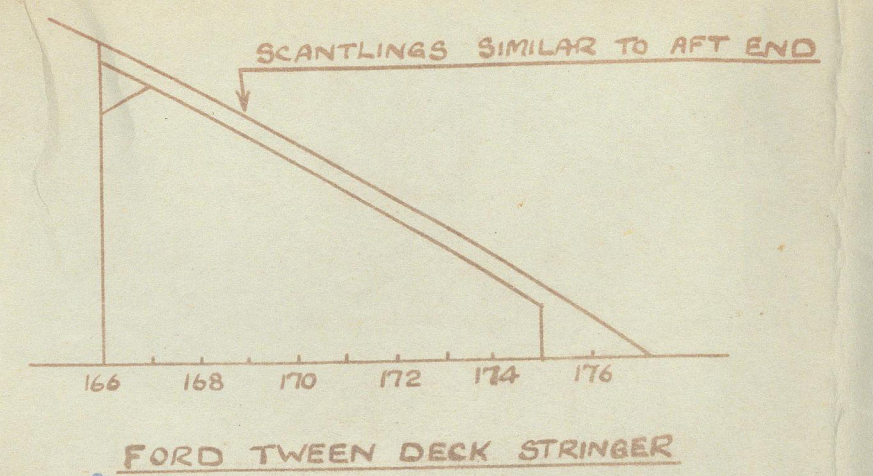 

SHAHZADA ❀


PROFILE & DECKS
As BUILT

2

RETAIN

© 2021

004170-004176-0039

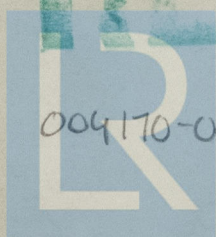

Lloyd's Register
Foundation