

# RETAIN

5/9/19

Nº 964.




PART MIDSHIP SECTION SHOWING PROPOSED MODIFICATION TO  
PROMENADE DECK, ETC.

SCALE 1/2" = ONE FOOT.

SECTION AT HEAVY BEAMS AND SIDE PILLARS.

FORE AND AFT ELEVATION.  
LOOKING INBOARD.

SECTION AT INTERMEDIATE BEAMS.

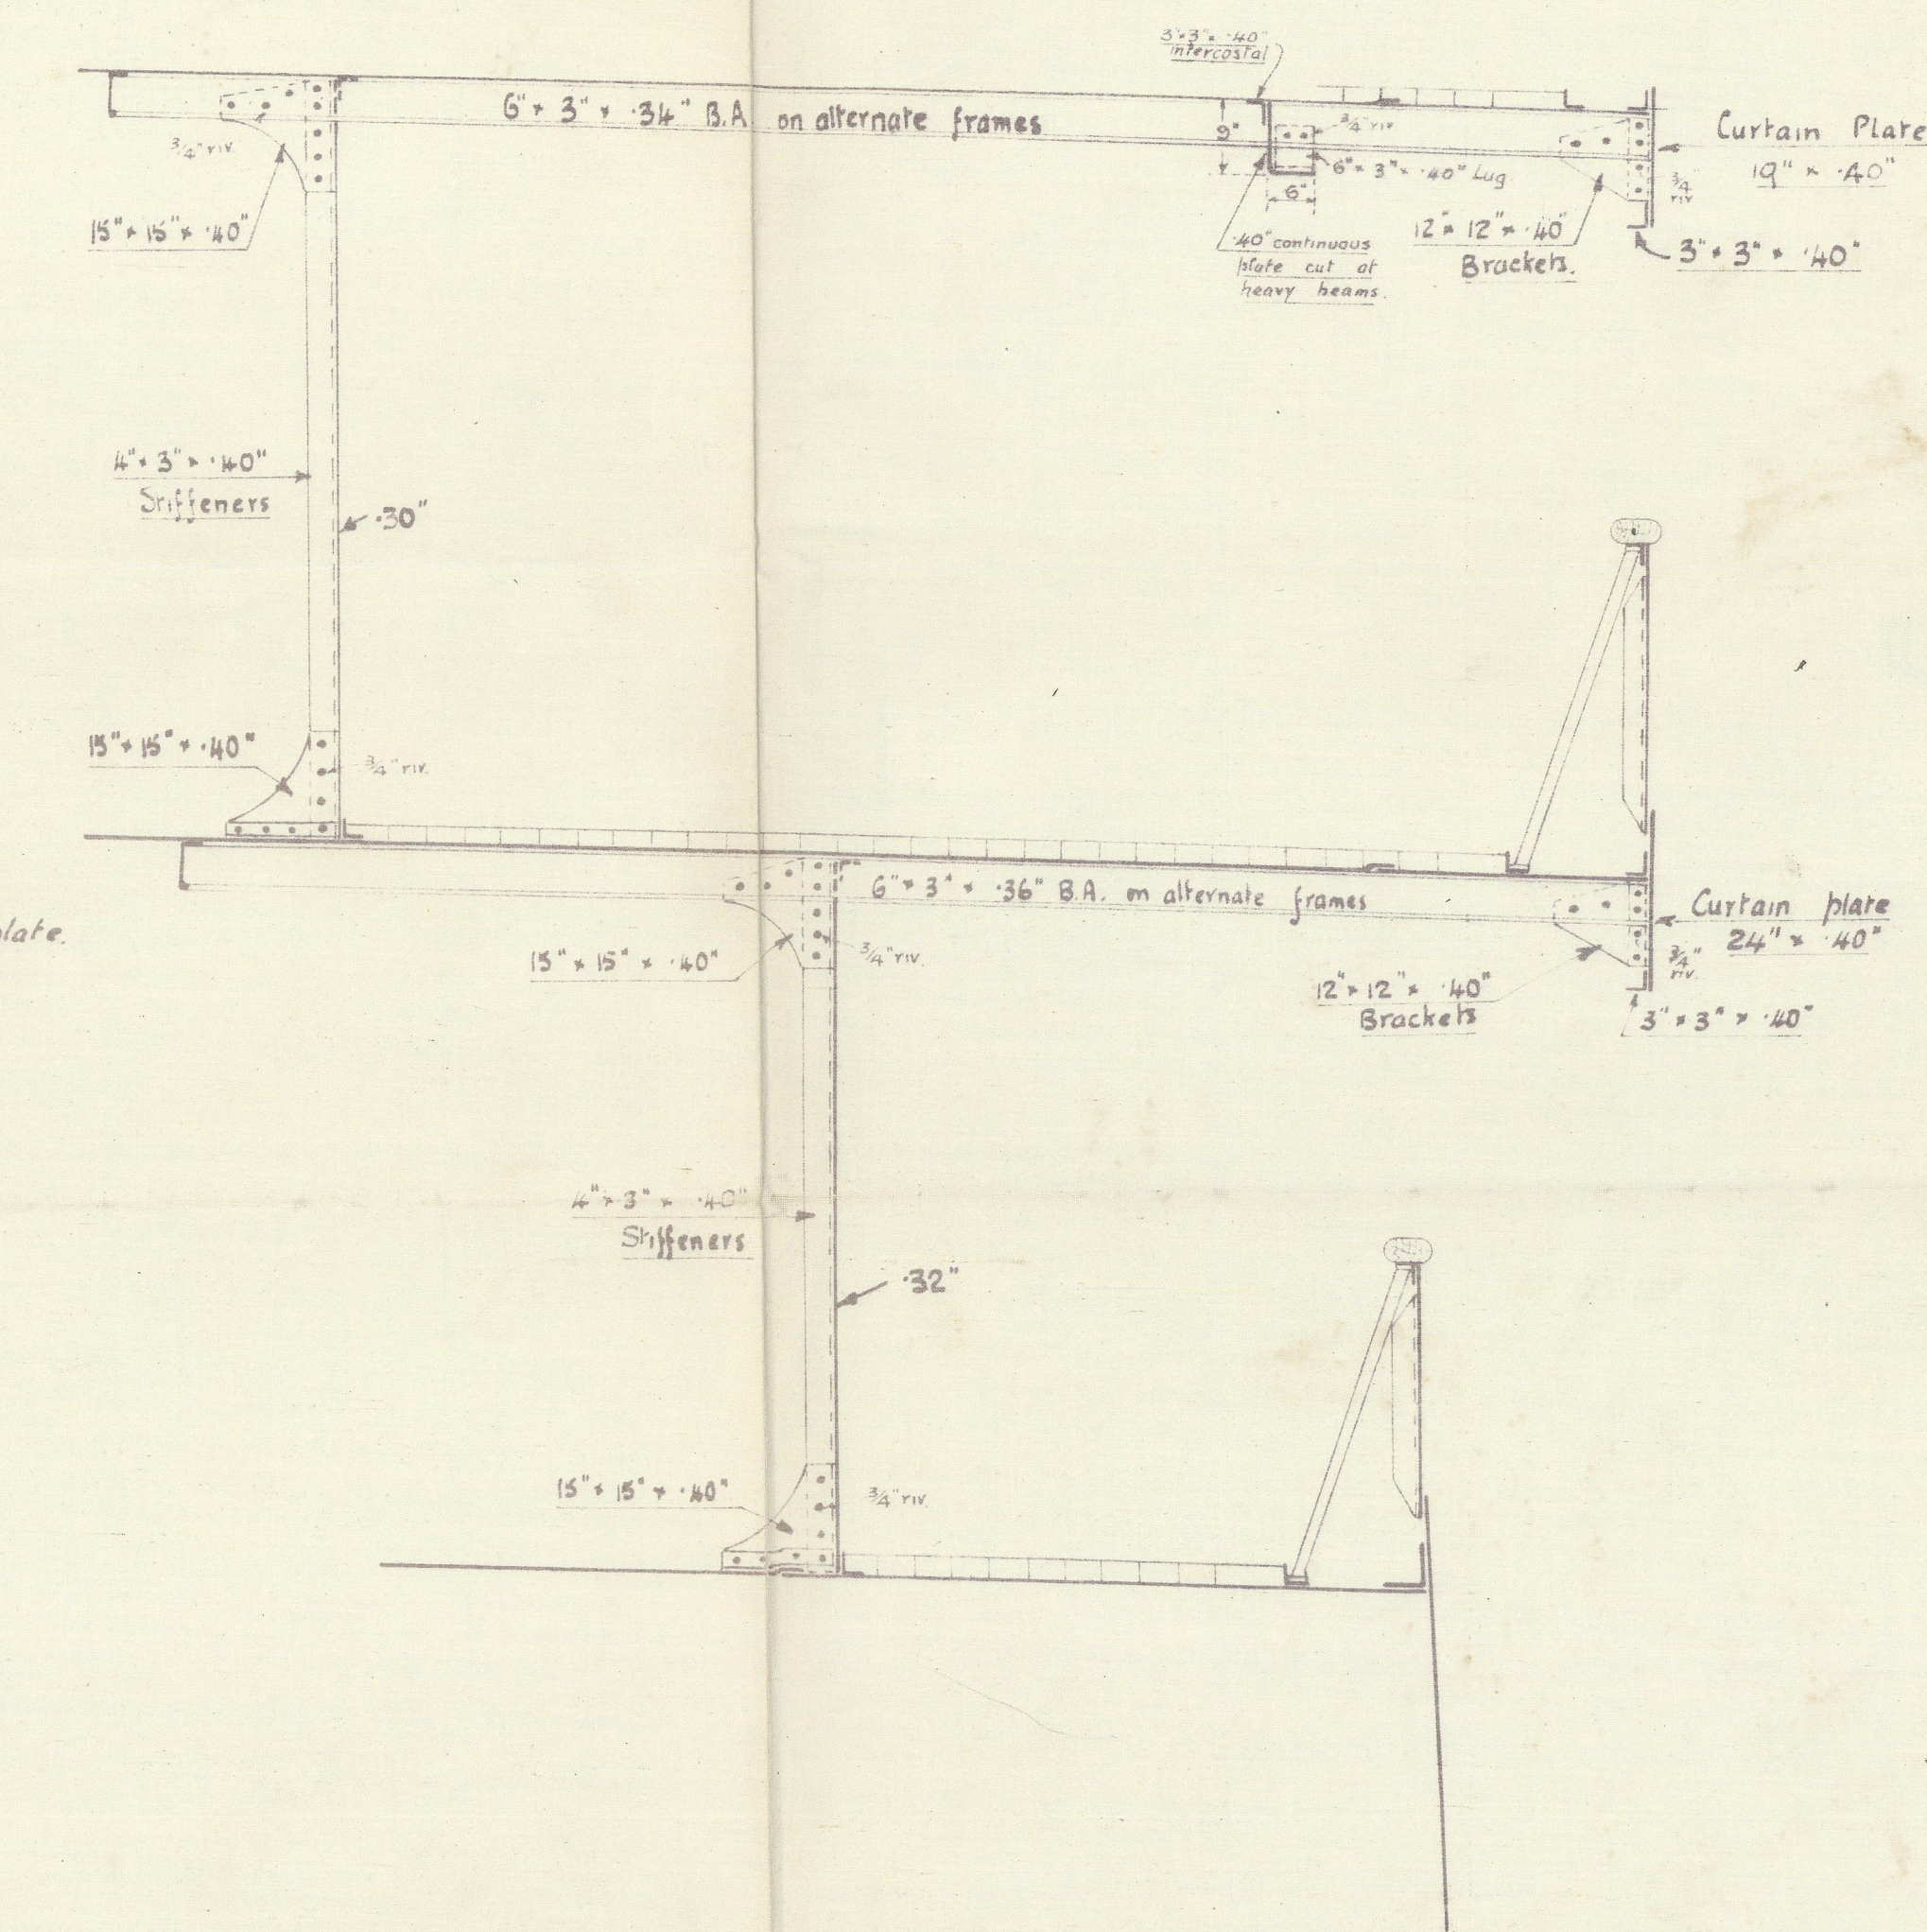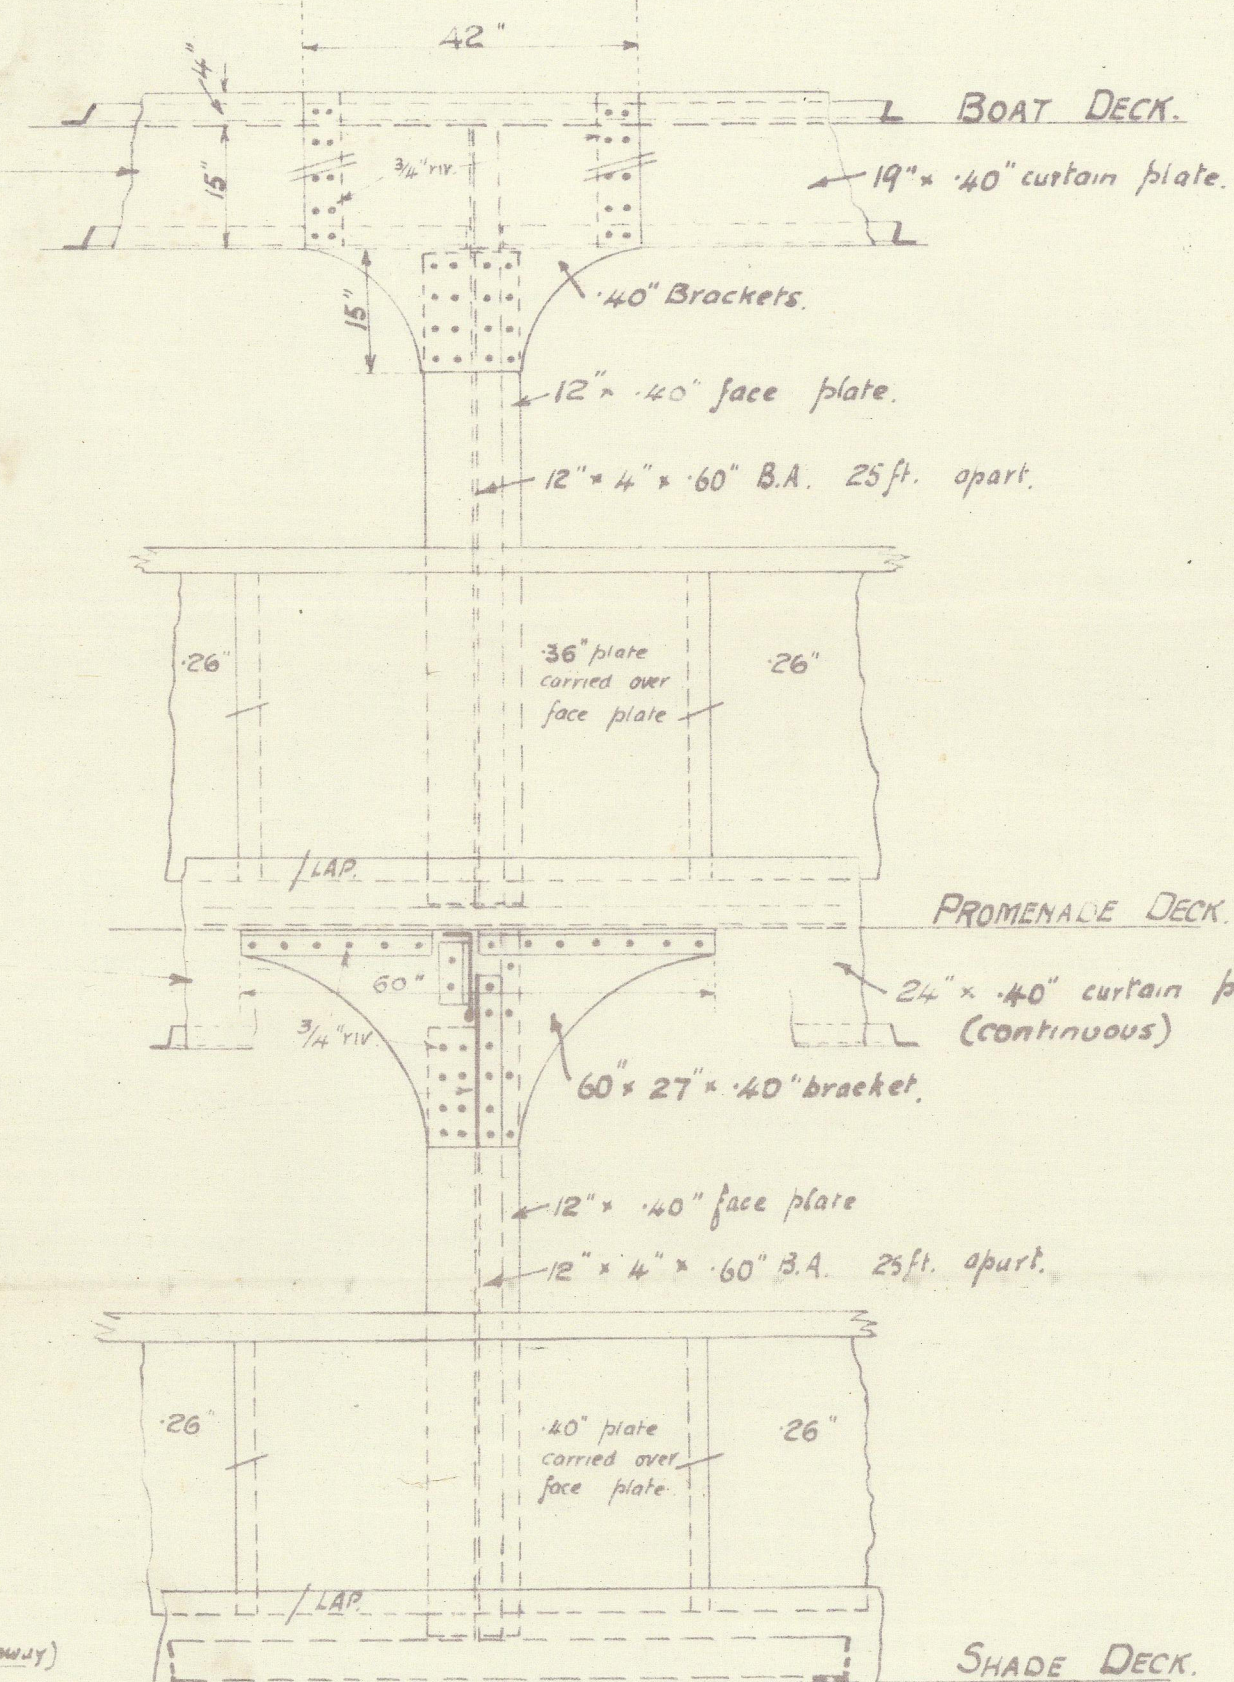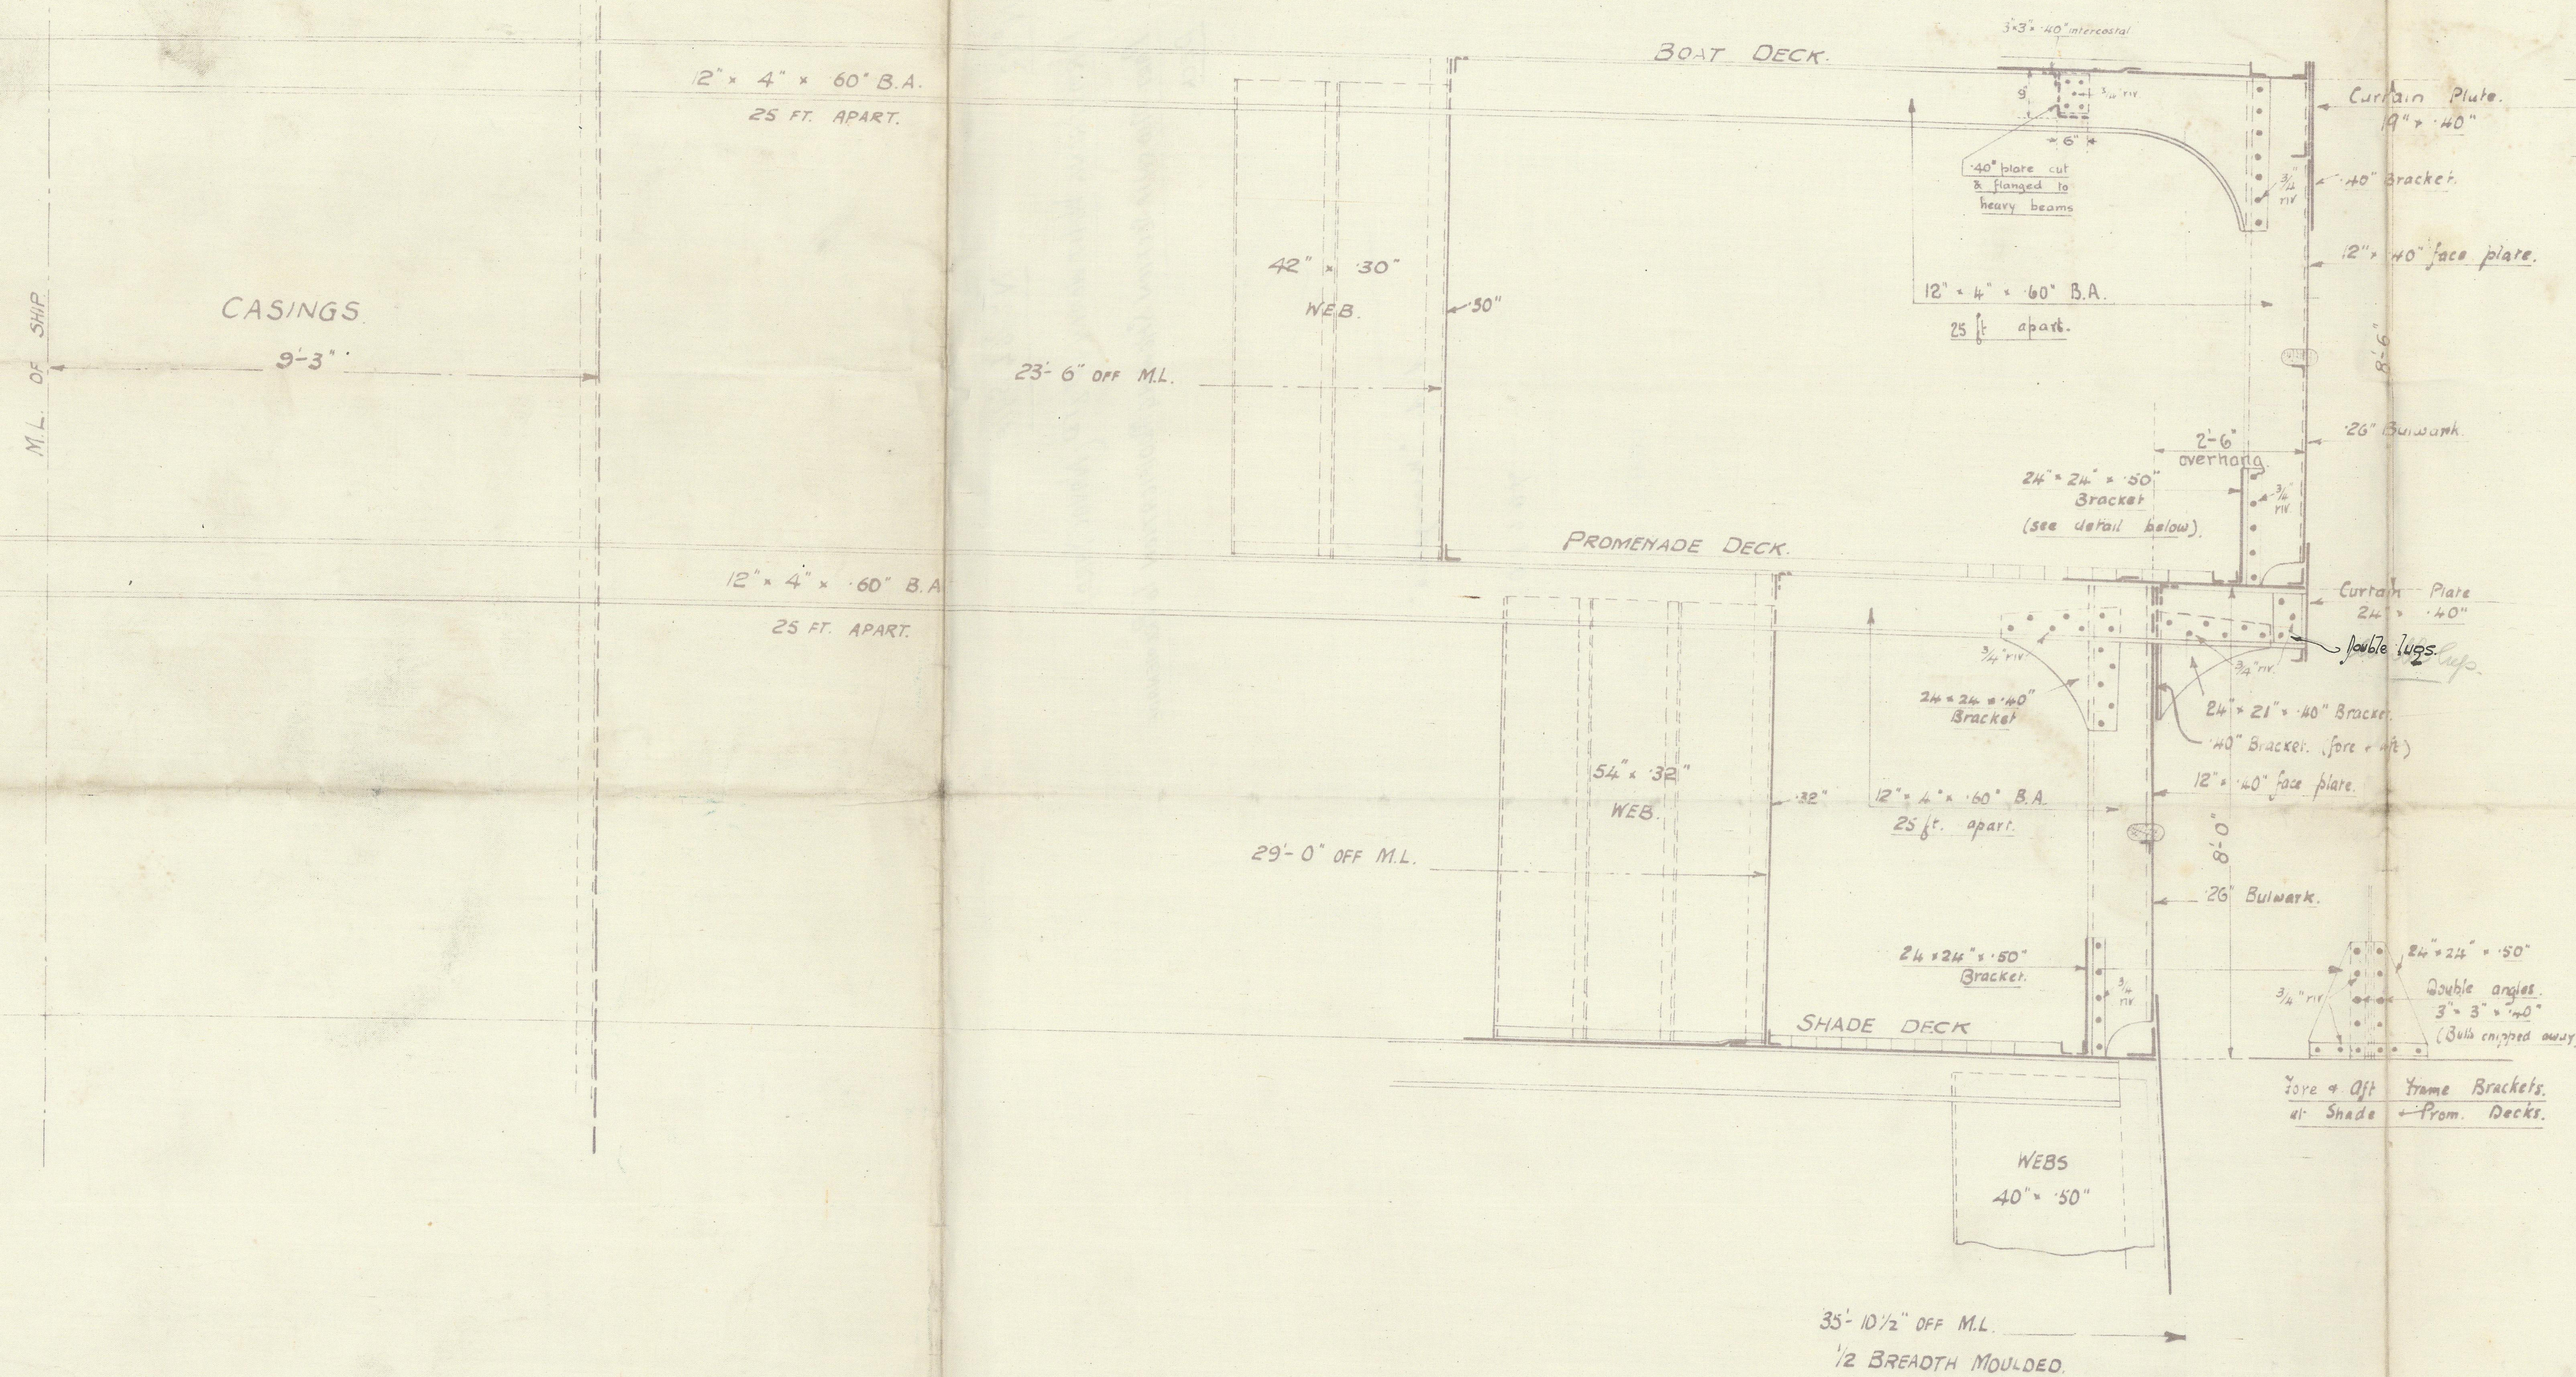

5.9.19.





© 2021

Lloyd's Register  
Foundation



N° 22

N° 964 SHIP

ARMSTRONG WHITWORTH & CO LTD (NAVAL YARD)

PART MIDSHIP SECTION SHOWING MODIFICATION TO PROMENADE  
DECK.



S. A. "Mongolia"

NEWCASTLE ON TYNE  
Report No. 46680.

004170-004176-0086

25  
104 - 1  
235 = 581

60484



© 2021

Lloyd's Register  
Foundation