

SHIP NR. 29.
PROFILE AND DECKS.

SCALE 1/8"=1'

LENGTH BETWEEN P.P. 390'-0"
BREADTH MOULDED 53'-3"
DEPTH TO UPPER DECK 36'-0"

Illustrations in green proposed for a draught of 26'-6"


PRELIMINARY FREEBOARD DATA:

SHEER FORWARD = 7'-2"
AFT = 3'-9"
COEFFICIENT FINENESS .766
CORRECTION FOR DOUBLE BOTTOM .02
TONNAGE OPENINGS IN UPPER DECK AFT ~~to be closed~~
HATCHES AND FREING PORTS FITTED AS PER RULES.



SHIP NR. 29.
PROFILE AND DECKS.

AMENDED PROFILE & DECK PLANS
NAKSKOV N°29.

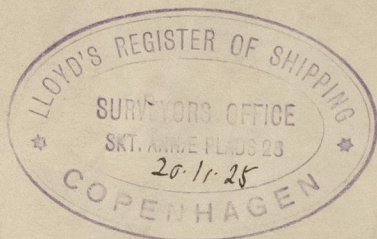

Gen Box 592

"
Lalandia

Alteration - see b/pn R/H

Sp 12834 of 9/49.

RETAIN



© 2021

Lloyd's Register
Foundation

004184-004193-0173