


38'-8" To P+B (COMB)
 418'-0" x 56'-0" x 30'-8" MLD.

BUILDERS:- BREMER VULCAN, VEGESACK 1915 TO CLASS ± 100 A[E] G.L.

"INDIANA"

COUPE AU MAITRE

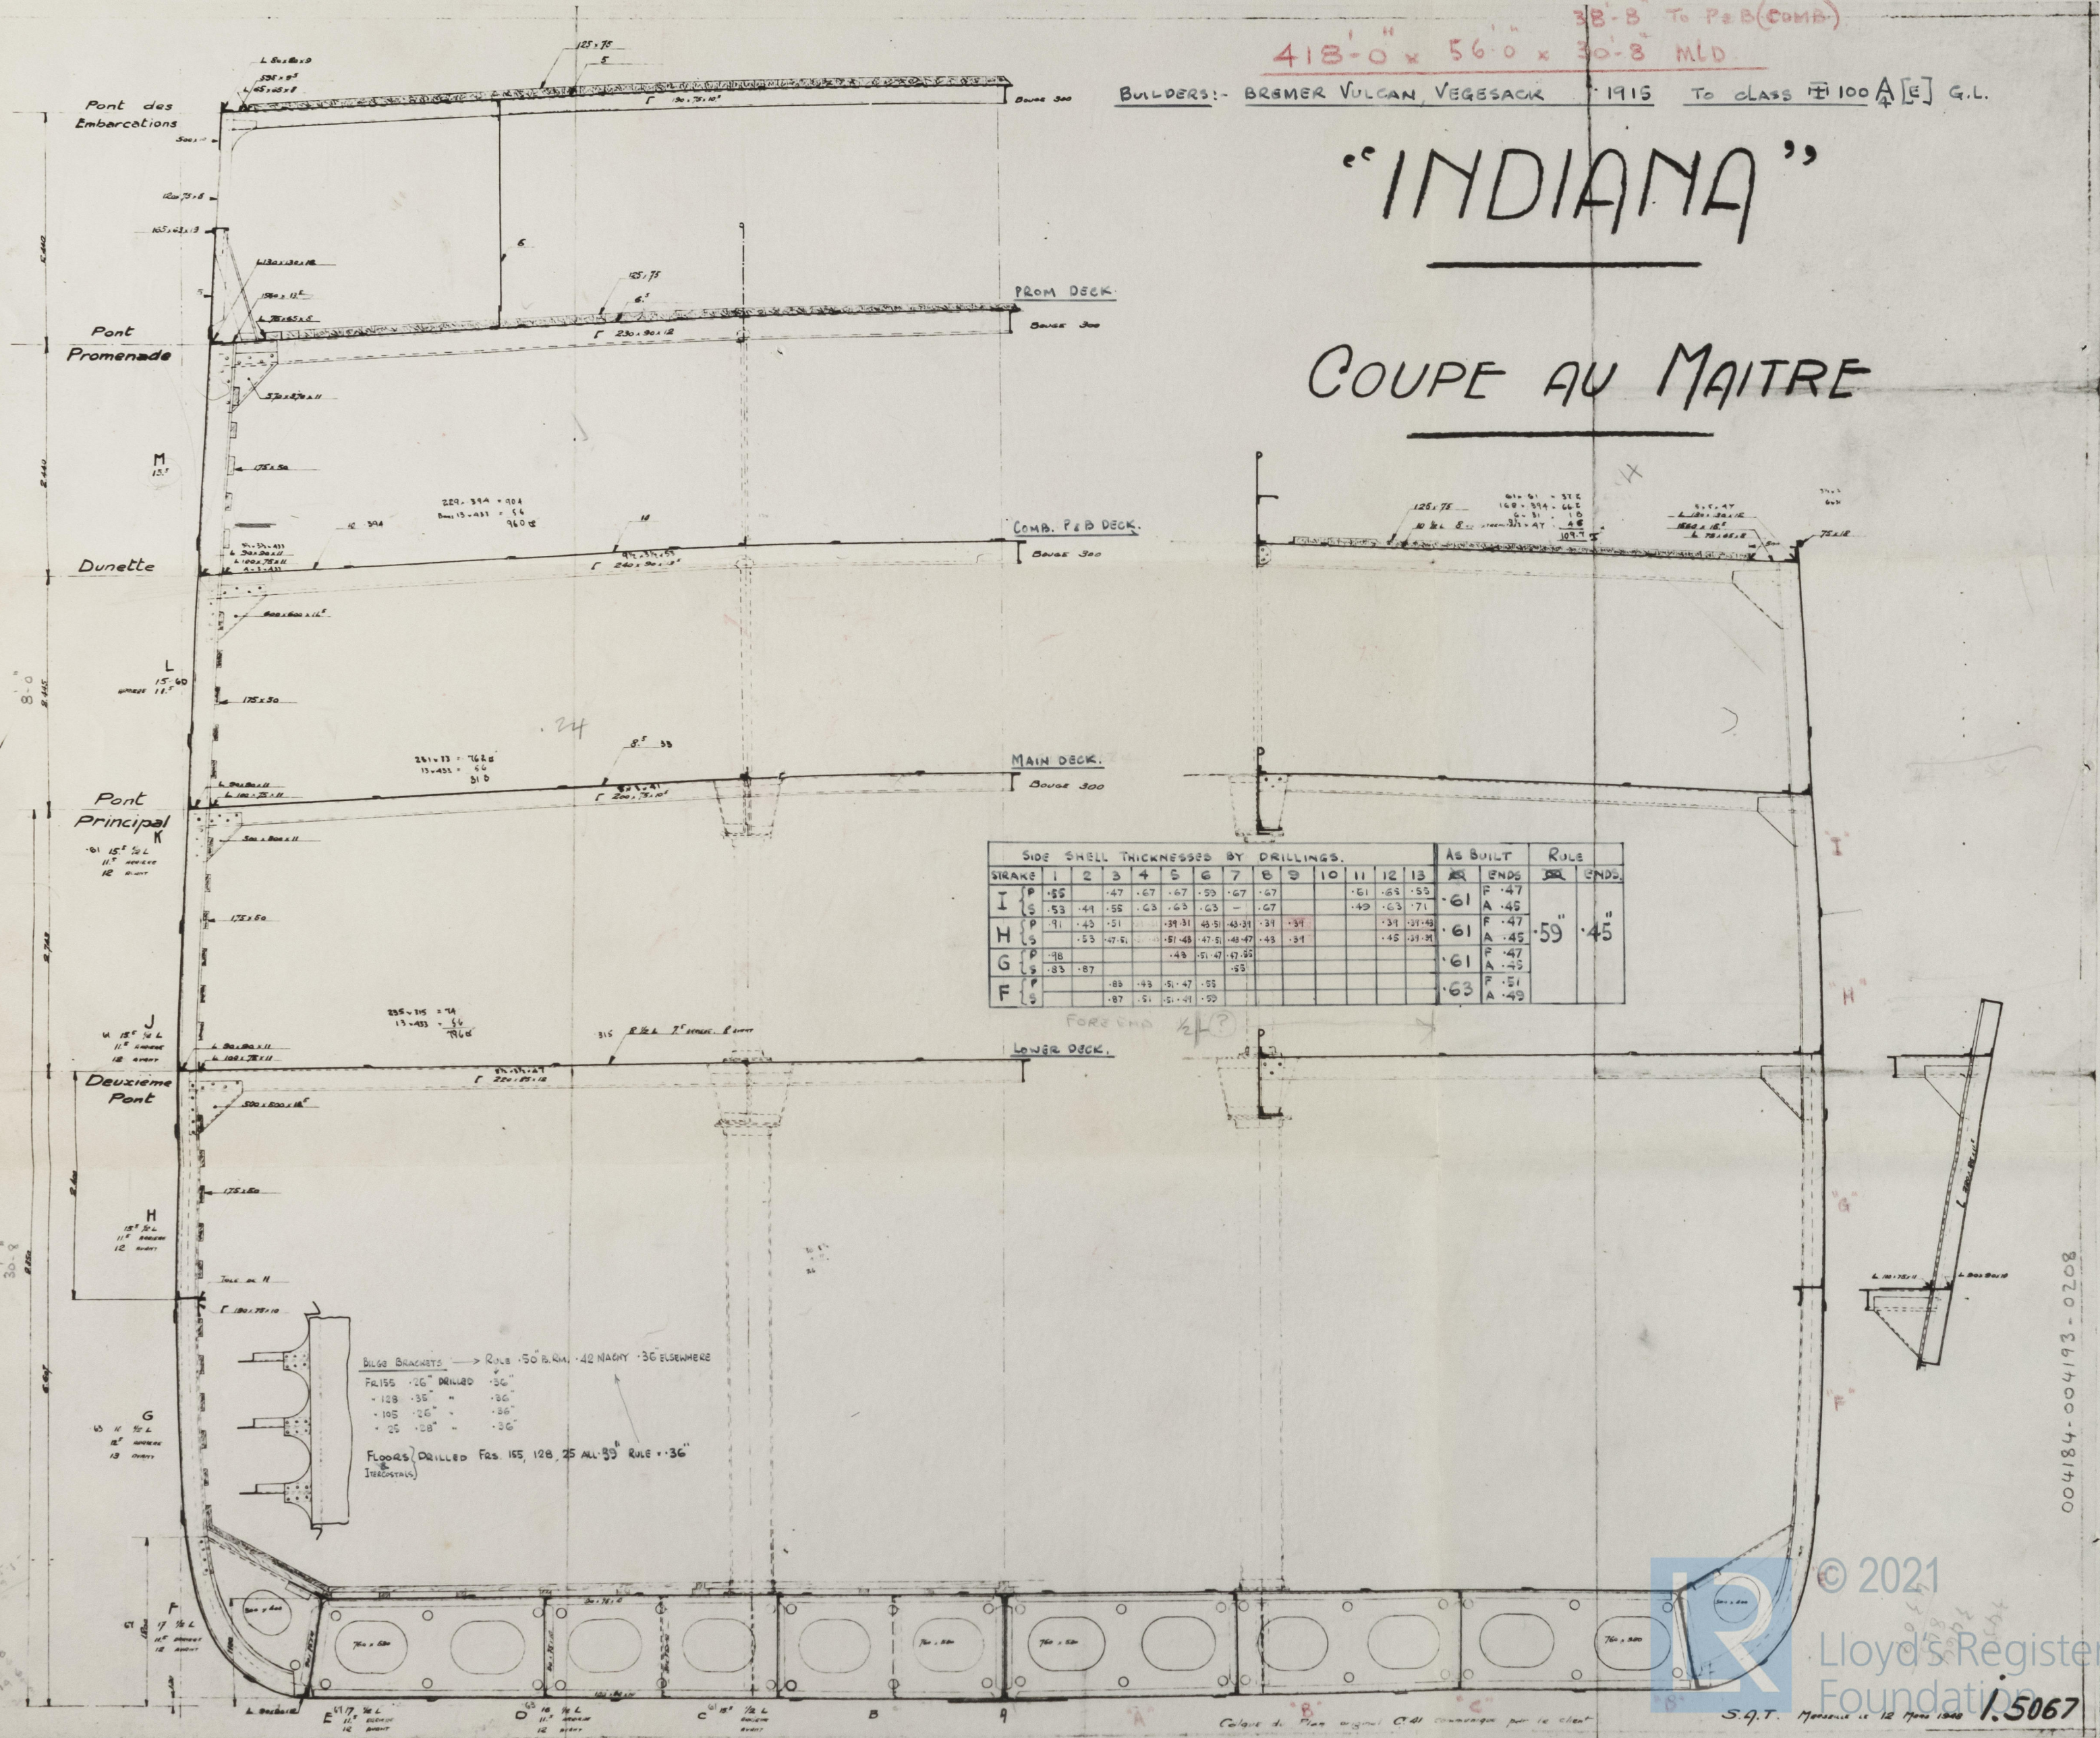

004184-004193-0208

1

Midship Section

$\frac{5}{16}$ INDIANA.

Marsilles

23.2.18.

now Assimina



© 2021

Lloyd's Register
Foundation

004184-004193-0208