

15 JUL 1948

No. 25419

Rpt. C. 11 (Contd.)

Index No.

# Lloyd's Register of Shipping.


Ship's Name ASSIMINA (EX. DERNA)Official No. 2253/1948

Memorandum of alterations reported since ship was surveyed for assignment of Load Lines in MARSEILLES.

Companionways fitted to N° 1, 2 + 3 hatchways as per plan N° 5435-23C-1 attached. Openings 5'9" high by 2'8" wide.

12" side scuttles fitted in main sheer strake as per plan N° 5298-20-1. Top of side scuttle 1'6" below freeboard deck. Permanent deadlights fitted.

Skylight fitted on cross bunker hatchway - hatchway covered by fitted and welded plating 10 m/m thick. Skylight welded to plating. Dimensions as per sketch:-

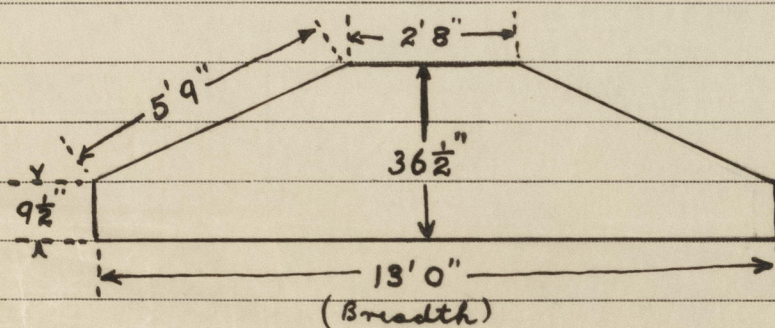

Length of casing 11'0".

D. K. Lynn.

Copy sent to  
New York 19.7.49.