


-No 528-

PROFILE SHOWING EXTENT OF SHELL CHOCKS.

SCALE 1/8" = ONE FOOT



*326
17
check with value of ship*

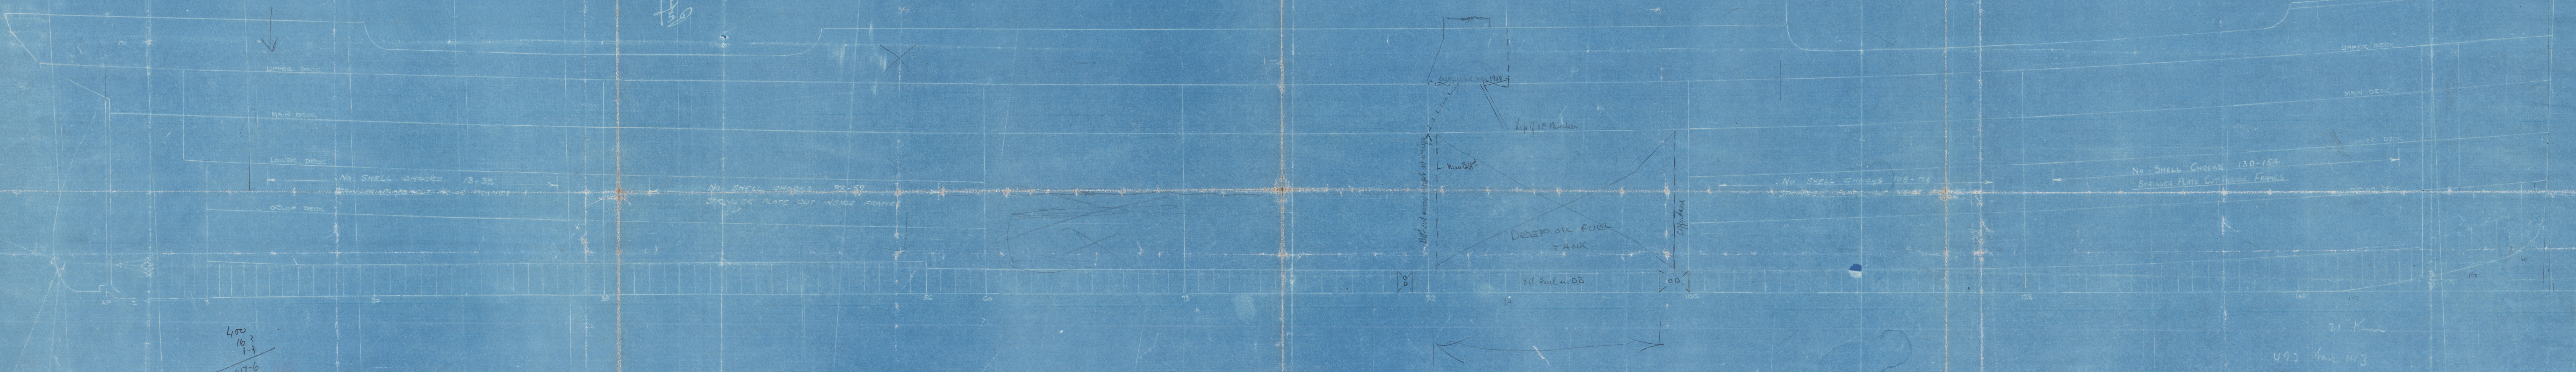

13 JUN 1929

Approved
6
29

*400
163
1-3
417-6*


*21 Km
493 km 143
510 513 523 150*

004194-004199-0003

Profile
Stephens 528

Gray

004194-004199-0003

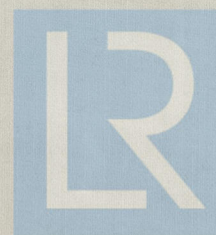

© 2020

Lloyd's Register
Foundation

2

Profile. (SHELL
CHOCKS
ONLY)

A. Stephen Sons.

Nº 528.

S. L. H. - Q - 29.

18.6-29.

$\frac{3}{8}$ " CORRALES



© 2020

Lloyd's Register
Foundation

004194-004199-0003