

S.S. No. 1289  
· PROFILE · & DECK · PLANS ·  
DIMENSIONS 430' BP x 56' x 33' 8"

SCALE 1/8" = ONE FOOT


TO CLASS B.S. AT THE BRITISH CORPORATION

OWNERS' ADDITIONAL SCANTLING (not included in this plan)

- DECKS
- 02' ON POOP, BRIDGE & FORECASTLE PLATING WHERE EXPOSED TO THE WEATHER
  - 02' ON BRIDGE DECK STONGER
  - 04' ON UPPER DECK STONGER EXTENDING 15' 0" BEYOND BRIDGE END FORP & AET
  - 02' ON MAIN DECK PLATING INCLUDING STONGER FROM AET END OF THE AFTER DEEP TANK TO THE FOREWARD END OF NO. 5 HATCH

FORECASTLE DECK  
DECK PLATING  
FLOORS TO BE INCREASED IN DEPTH  
FRAMES INCREASED 1/4" IN THICKNESS

SEE ALSO MIDSHIP SECTION

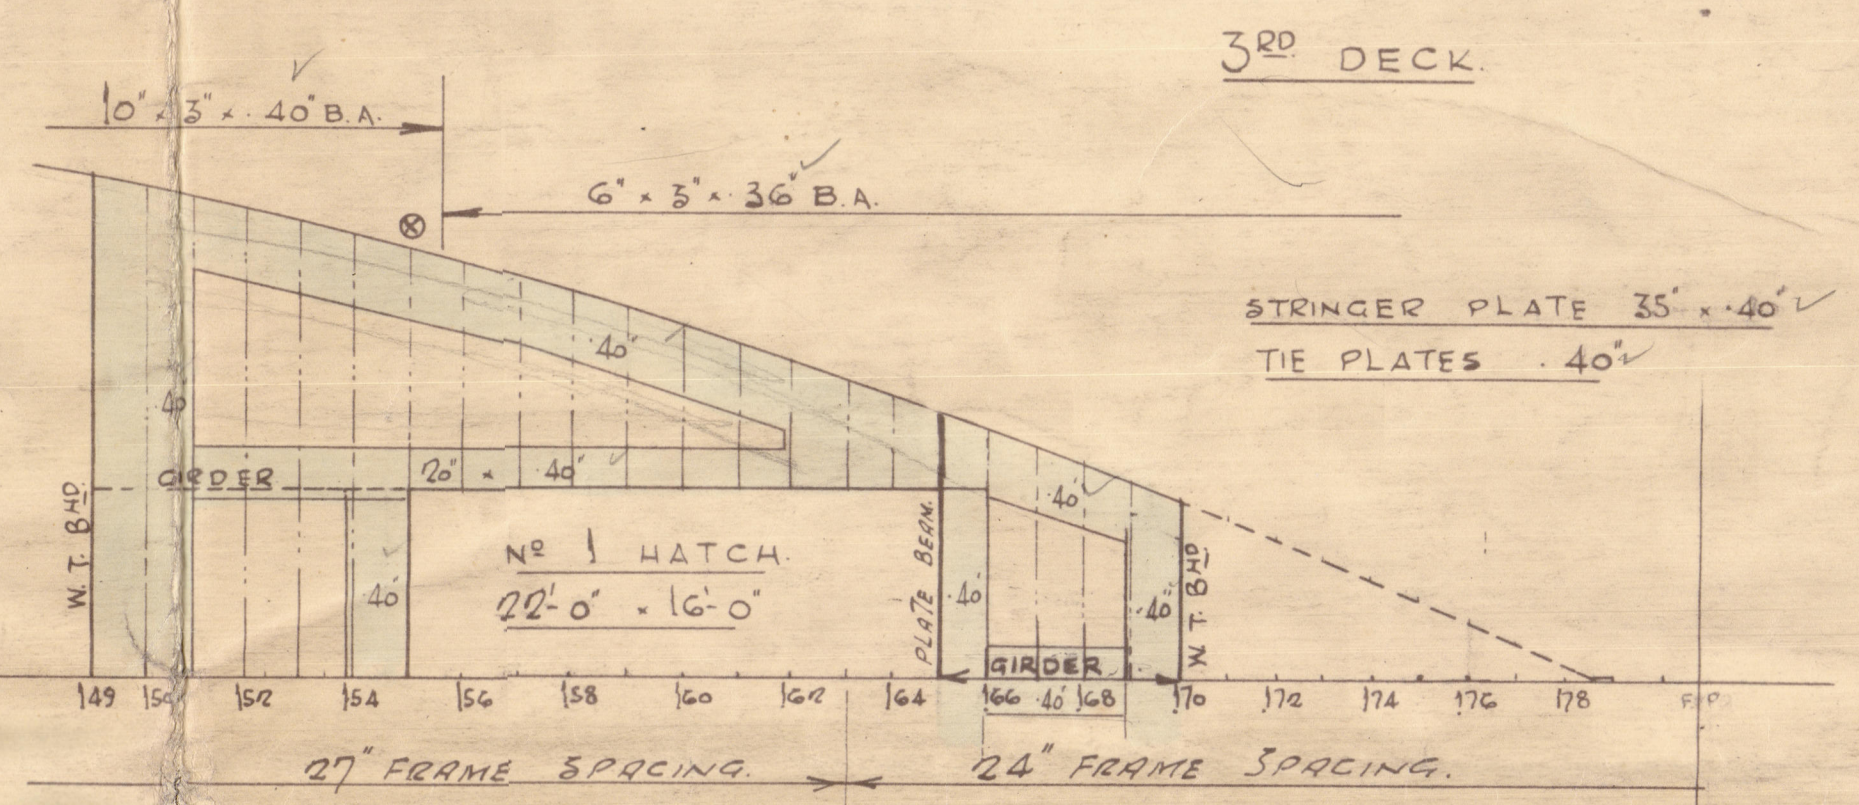

26 SEP 1935

Approved  
27/11/35



Profile & Deck.

Wm Denny & Bros.

N<sup>o</sup> 1289.

27 . 9 . 35.

CITY OF AGRA

T. C. 4 . 12 . 35.

RETAIN

Profile & Deck.

Denny & Bros.

Log