
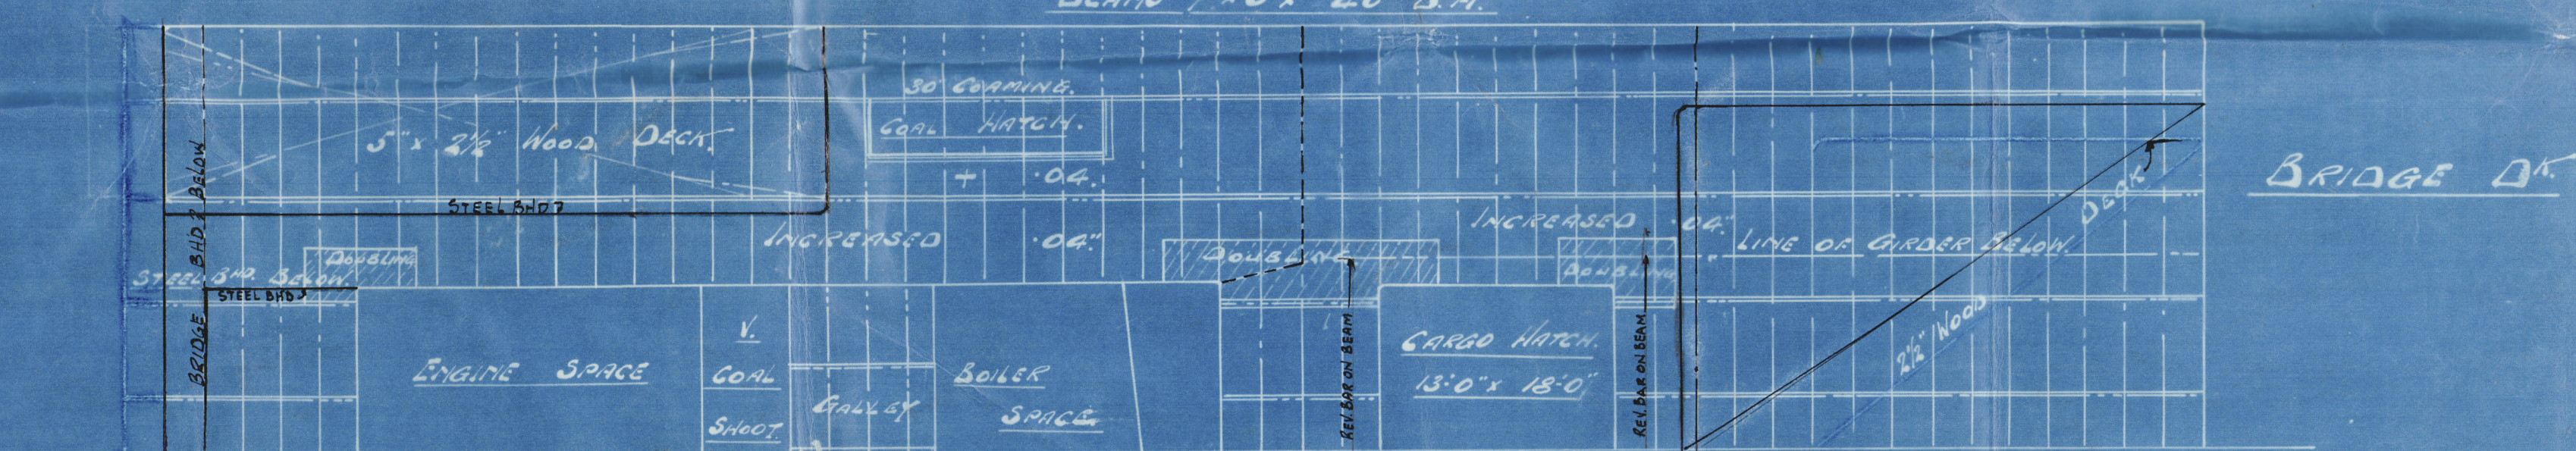


S. S. No. 737

BUTTS LAPPED & 3R ABOVE DECK

SEAMS LAPPED & SINGLE RIVETED

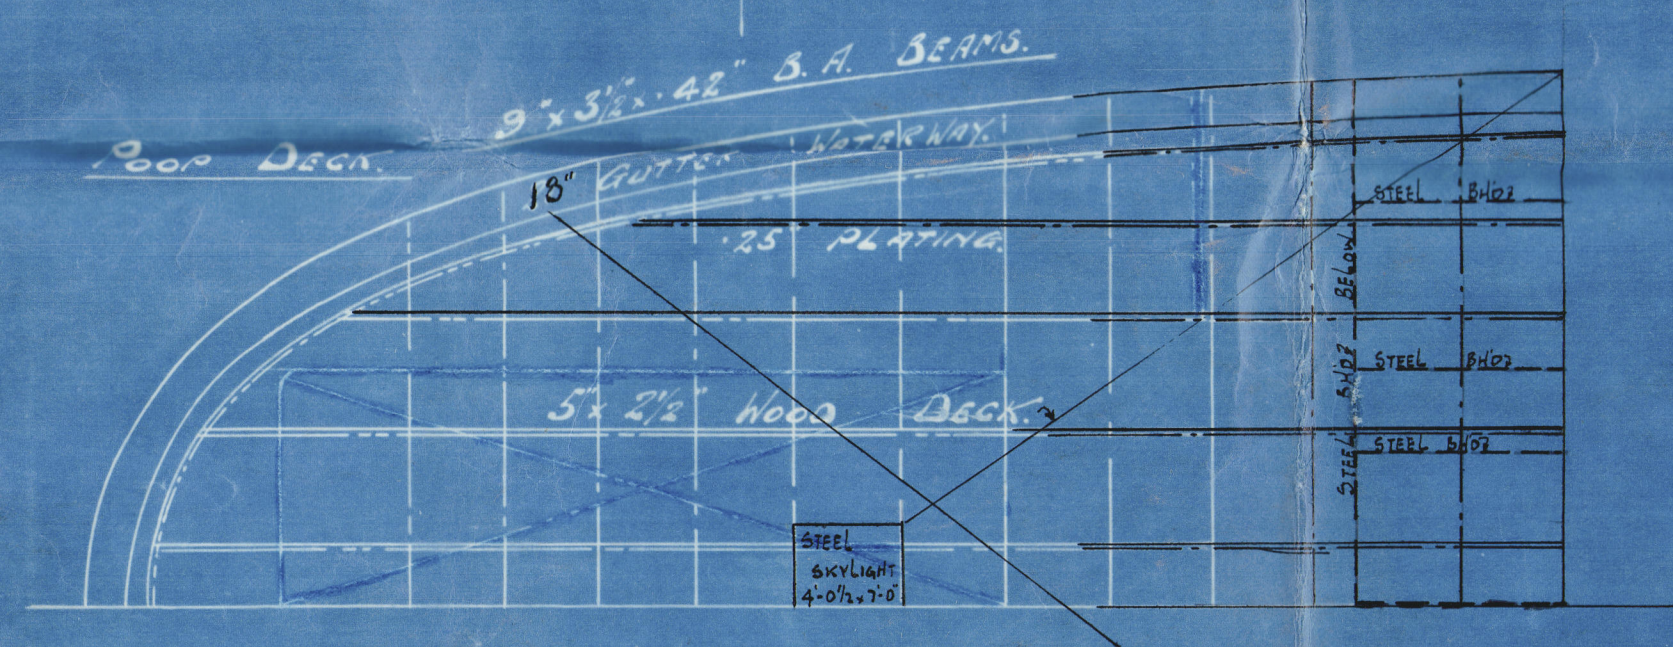

PROFILE & DECK PLANS.


S.S. "CLAN MACIVER"

LITHGOWS LD N^o 737.

4/11/1911 No 17838

barrena

RETAIN

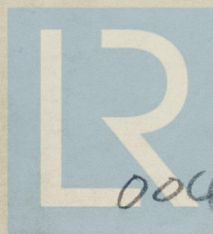

© 2020

Lloyd's Register

004206-004212-043

Foundation