

# T.S.S. "TUNG SONG"

## PROPOSED LENGTHENING BY 31' 2"

### SCANTLINGS OF NEW PART

1/2" = 1' FOOT

DIMS. AS LENGTHENED

LENGTH 68' ON 105 W.L.  
BREADTH M.L.D.  
DEPTH M.L.D. UPPER ON  
" " SHOT. D.K.


180' 0 1/2"

29' 0"


10' 6"

18' 0"

TO LOWEST POINT OF SHEER.

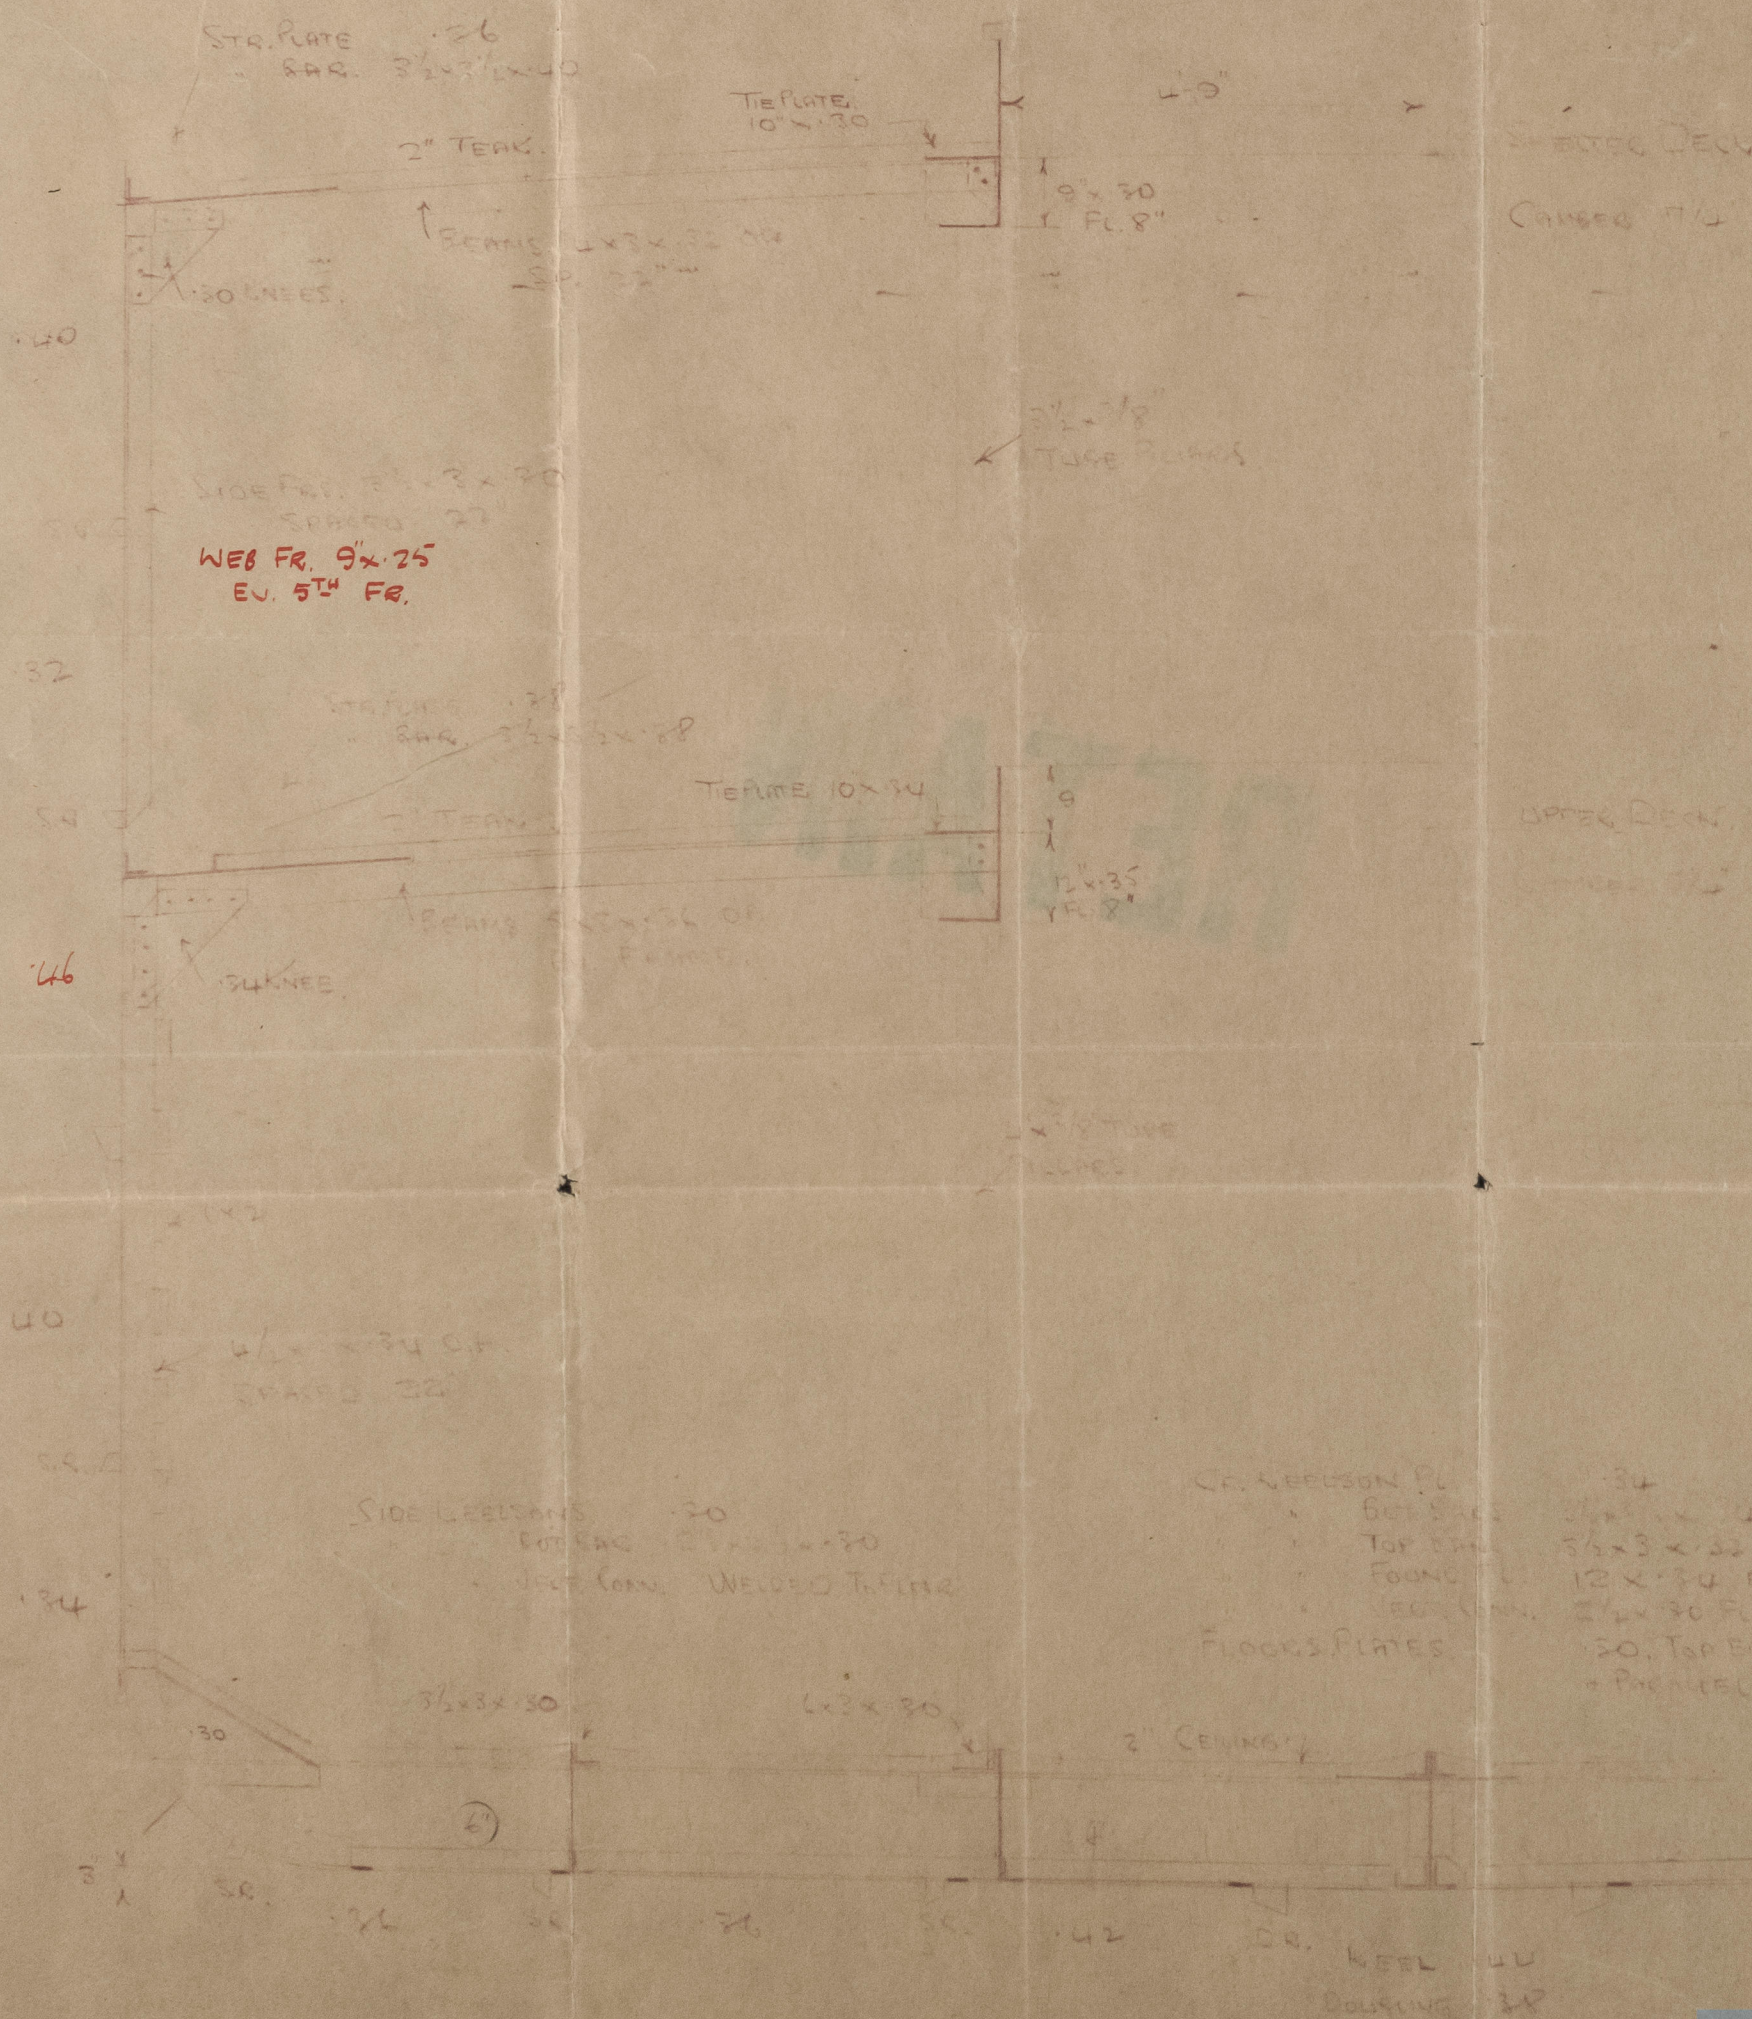

8 JAN 1936

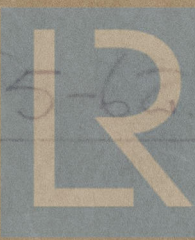

© 2021  
Lloyd's Register  
Foundation



1  
2 plan

Midship Section.

$\frac{1}{2}$  TUNG SONG.

Shanghai 1/36.

Proposed

See label 2110/36.

RETAIN  
TUNG SONG  
© 2021



Lloyd's Register  
Foundation