


to "FORT RANDOLPH"

SPEED NOT EXCEEDING 10 KNOTS

SPEED NOT EXCEEDING 10 KNOTS

- Scale: - 1" = ONE FOOT -

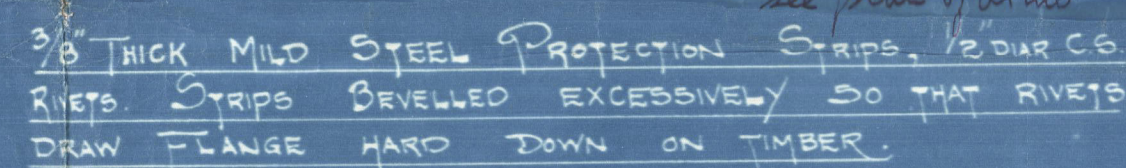

DETAIL SHOWING CURVATURE OF TIMBER

ALSO STEEL PROTECTION STRIPS



- Scale: - 3" = ONE FOOT -



Scale:- 3" = ONE FOOT.

APPROVED

H. Dickerson 12-7-38

DATE 2-2-88
APPROVED for 13

LLOYD'S REGISTER OF SHIPPING

DATE REPT. 12/30
15 FEB. 1935
13,210
ABERDEEN

S. I. №
Drawing № 3.
14th Feb 1935

Lloyd's Register
Foundation

N^o. 134. -134.

Stein Trama & Rudder
Mess^{rs}. J. Lewis & Sons L^d.

S. S. "WHITE PIONEER" = 134
abn. Report. 18213.

S. K. "MOUNT KEEN" = 137
abn. Report. 18570.

Sister would be
Fort RANMOCH
Yard no 136

—
LUFFNESS*



© 2021

Lloyd's Register
Foundation

004213-004221-0245