


S.T. No 136 134 - 134. E FORT RANNOCK

PROFILE & DECK

To Class Lloyds 100. A.I. "STEAM TRAWLER"

DIMENSIONS.
 LENGTH D.P. 125'-7"
 BREADTH M.P. 23'-0"
 DEPTH M.P. 13'-6"
 Scale - 1/4" = ONE FOOT

FRAME SPACING
 FRAMES 0 TO 12 SPACED 21" APART
 " 12 TO 68 " 21 1/2" "

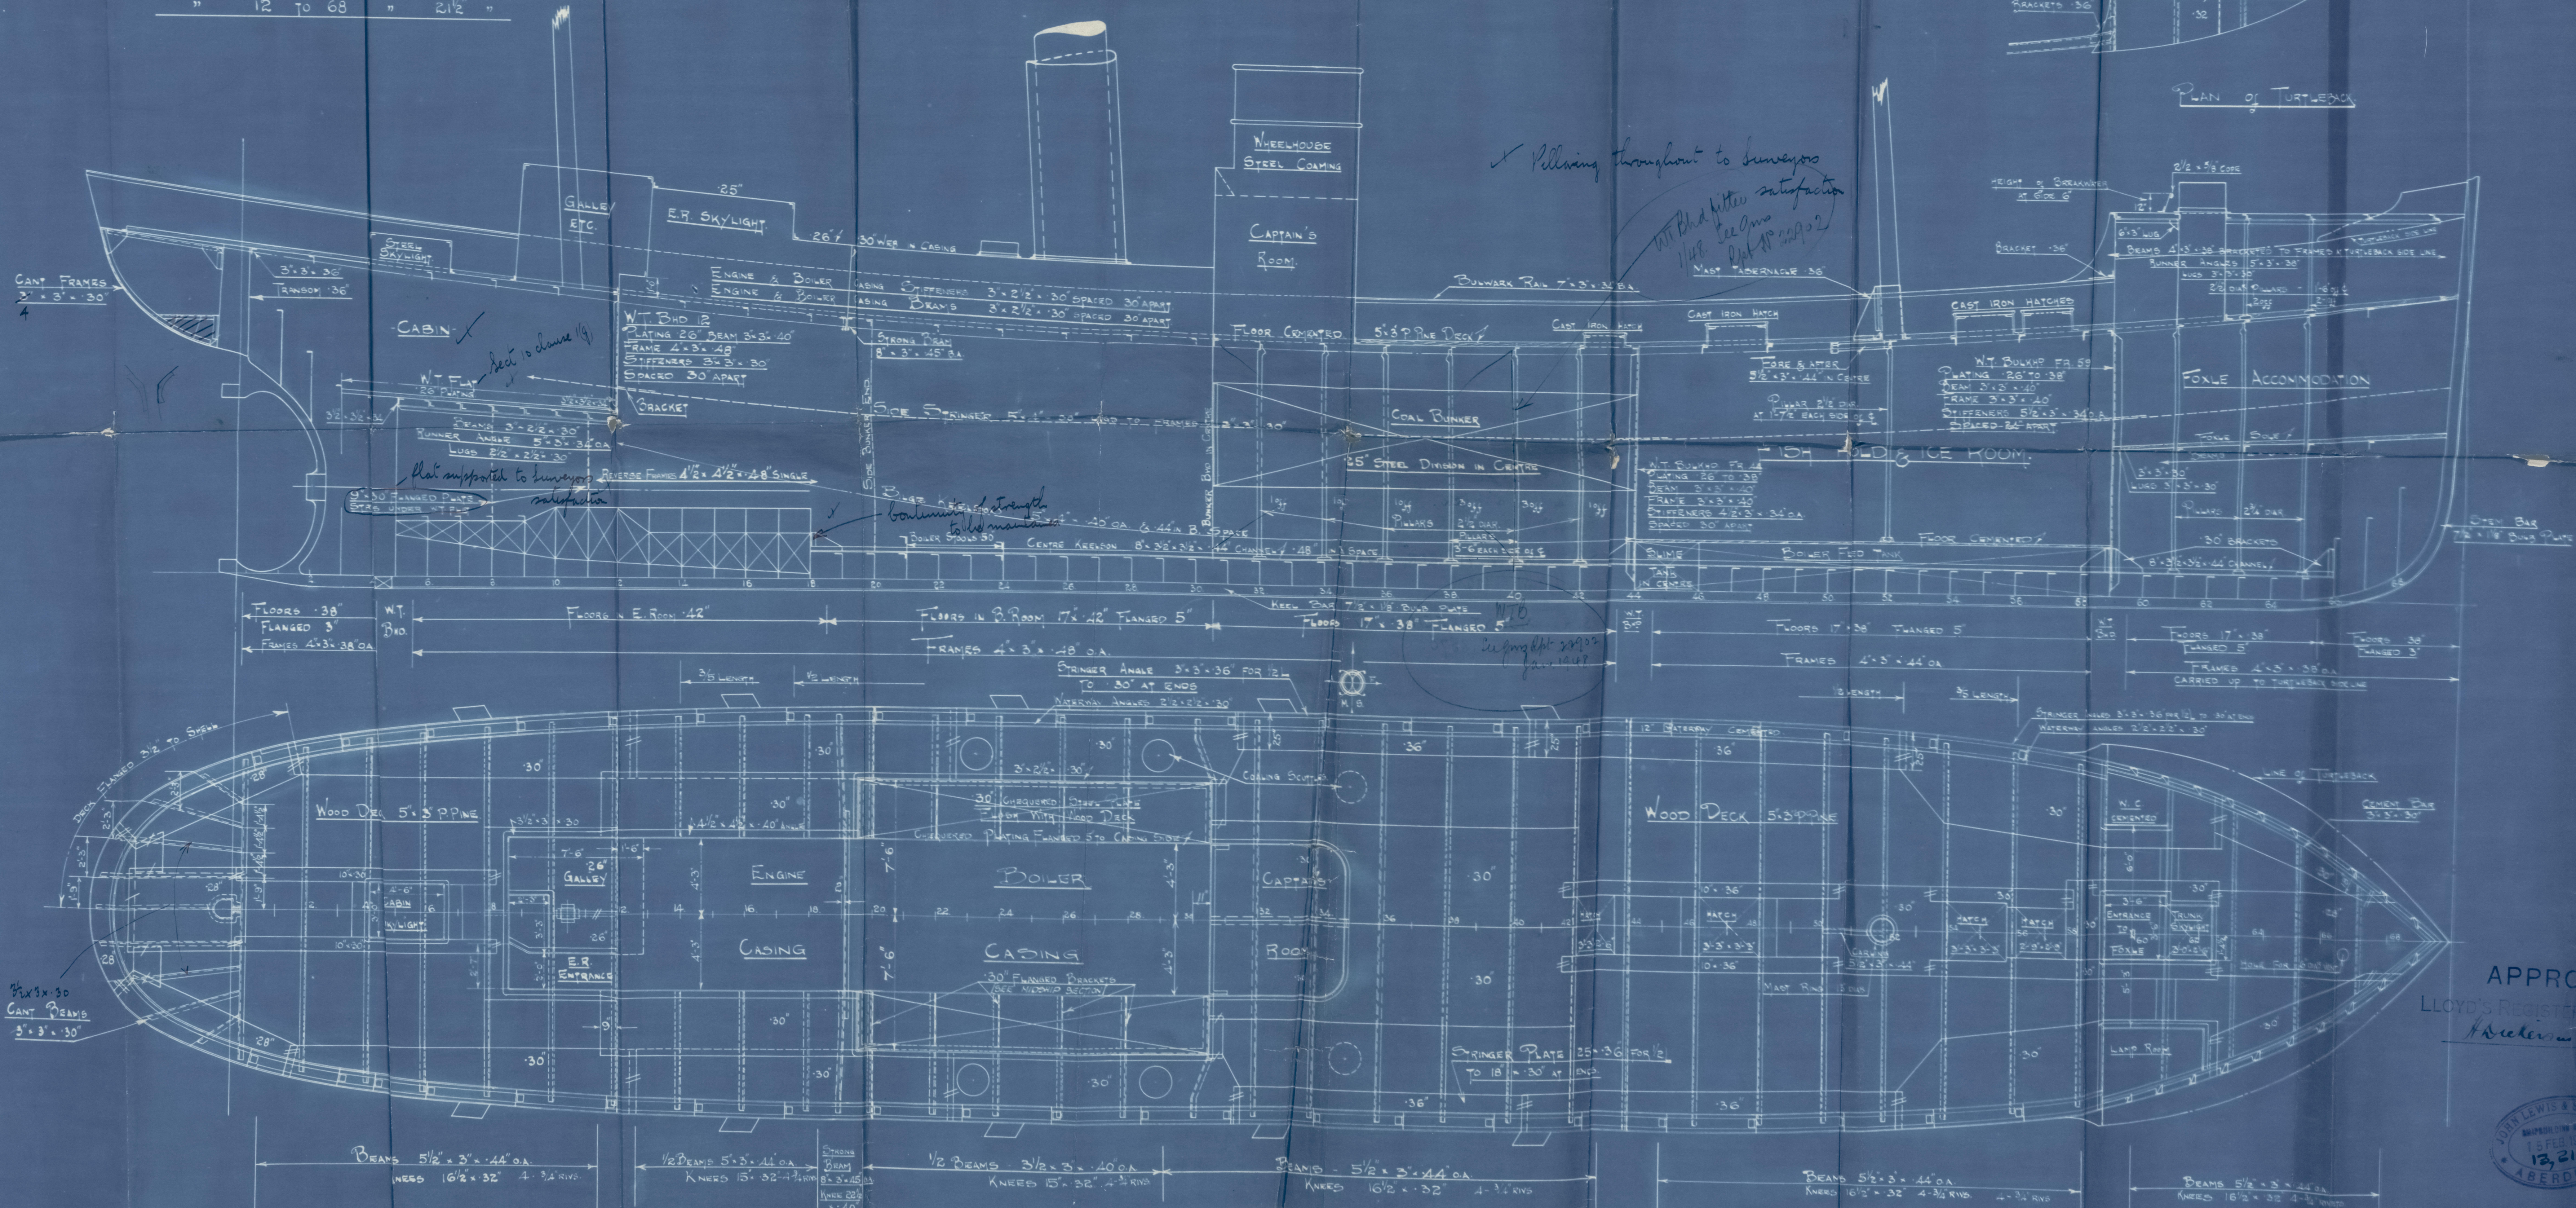

APPROVED
 LLOYD'S REGISTER OF SHIPPING
 H. H. H. H.
 DATE 22.2.35

JOHN LEWIS & SONS LTD
 13, 21, 23
 ABERDEEN

APPROVED for 11/13/35
 LLOYD'S REGISTER OF SHIPPING
 H. H. H. H.
 DATE 11/12/35

N^o. 134 - 134.

Profile & Deck.

Messrs. J. Lewis & Sons Ltd.

S.S. "WHITE PIONEER" = 134.
abu. Report. 18213.


S.K. "MOUNT KEEN" = 137
abu. Report. 18570.
" "

Mary White
n.a. "LUFFNESS" X.X

Listed vessel
to

FORT RANNOCH
Yard No 136.

RECORDS DEPT.
LONDON.

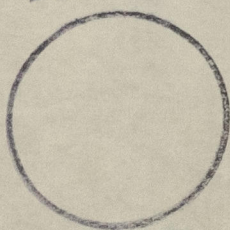

RETAIN

© 2021



Lloyd's Register
Foundation

004213-004221-0247