


PLAN No 85

SHIP No 274

MIDSHIP SECTION

SCALE $\frac{1}{2} = 1-0$

CLASS 100 A.I. LLOYDS

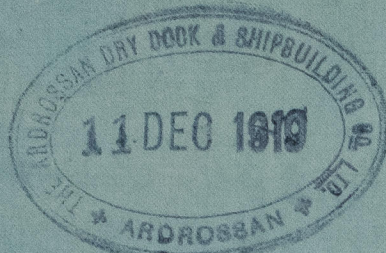

LLOYDS DIMENSIONS & NUMERALS

Length 125' 6" Breadth (Mid) 23' 6" Depth Main D^o 11' 1" D^o to 14' 1"

BREADTH M ^o	23' 6"
DEPTH M ^o	11' 1"
TRANSVERSE N ^o	34 58
LENGTH B.P.	125' 6"
LONGITUDINAL N ^o	4270 63
d. to MAIN DECK	10' 08"
d. to QUARTER DECK	13' 25"
L/D to MAIN DECK	1145
L/D to QUARTER DECK	167

EQUIPMENT N^o

LETTER'S

LONGITUDINAL N ^o	4270 63
Q ^o DECK 46' 0" x 3' 16"	175 36
BRIDGE DECK 87' 5" x 7' 0" x 1/2"	45 93
FOYLE DECK 23' 25" x 6' 75" x 1/2"	117 70
E & B CASING 41' 13" x 7' 0" x 1/2"	145 95
EQUIPMENT N ^o	4283 57

EQUIPMENT (LETTER'S)

2 BOWERS	8 1/2 CWT.	(STOCKLESS) COLLECTIVE WEIGHTS 1/2 CWT'S
1 STREAM	2 1/4	(EX STOCK)
1 KEDGE	1/2	()
165 FTMS	1 1/2	STUD CHAIN CABLE (MIN WT 6 1/2 CWT'S, FOR 11 LBS)
45	2 1/4	STEEL WIRE
75	2 1/4	TOWLINE
90	4	HAWSER

RIVETING TABLE

BUTTS OF SHEER STRAKE AND SHIPS	T.R.
STRAKE BELOW SHEER STRAKE AND SHIPS	D.R.
STRINGER PLATES THRO'OUT VESSEL	D.R.
OUTSIDE PLATING FROM UPPER TURN OF BILGE TO STRAKE BELOW SHEER STRAKE	D.R.
OUTSIDE PLATING FROM KEEL TO UPPER TURN OF BILGE AT ENDS OF VESSEL	D.R.
SHEER STRAKE, AT ENDS OF VESSEL	T.R.
STRAKE BELOW SHEER STRAKE AT ENDS OF VESSEL	D.R.
DECK PLATES FOR 1/2 LENGTH MIDSHIPS	D.R.
EDGES OF OUTSIDE PLATING FROM KEEL TO UPPER TURN OF BILGE	D.R.
UPPER TURN OF BILGE TO STRAKE BELOW SHEER STRAKE	D.R.
SHEER STRAKE	D.R.
DECK PLATES	S.R.



Am built with 3 strakes and 1/2" plating

Am built with 2 strakes of bottom plating maintained from 1/2" thick bottom & 1/2" thick side



Ardrossan D.D. M.B. Colh
No 274

Midship Section

Graham F
-est

GLASGOW REPORT No. 39909
S/Lady Thomas


n. n

"
WARREN

COURT "

RETAIN

004222-004229-20381

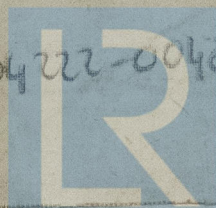

Lloyd's Register
Foundation