


Lloyd's Register of Shipping.

Ship's Name TEAKWOOD


Official No. 149878

Memorandum of alterations reported since ship was surveyed for assignment of Load Lines
in JANUARY, 1932.

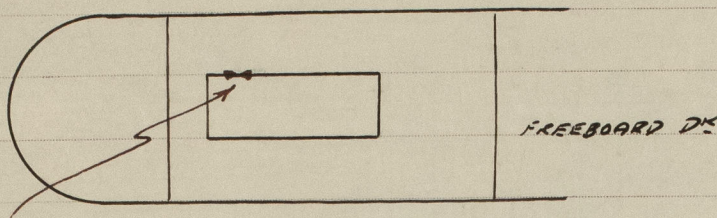

New steel door in machinery casing (port side) with lock, 2 hinges
and 2 clips workable from both sides. Height 2'6", breadth 2", sill 1'6".
Wooden storm boards in forecastle bulkhead in addition to 4 steel doors.

S.T.B. 3.6.37.

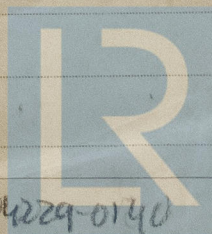

© 2021

Lloyd's Register
Foundation

004222-004229-0140