


Lloyd's Register of Shipping.

Ship's Name *TEAKWOOD*

Official No.

Memorandum of alterations reported since ship was surveyed for assignment of Load Lines
in

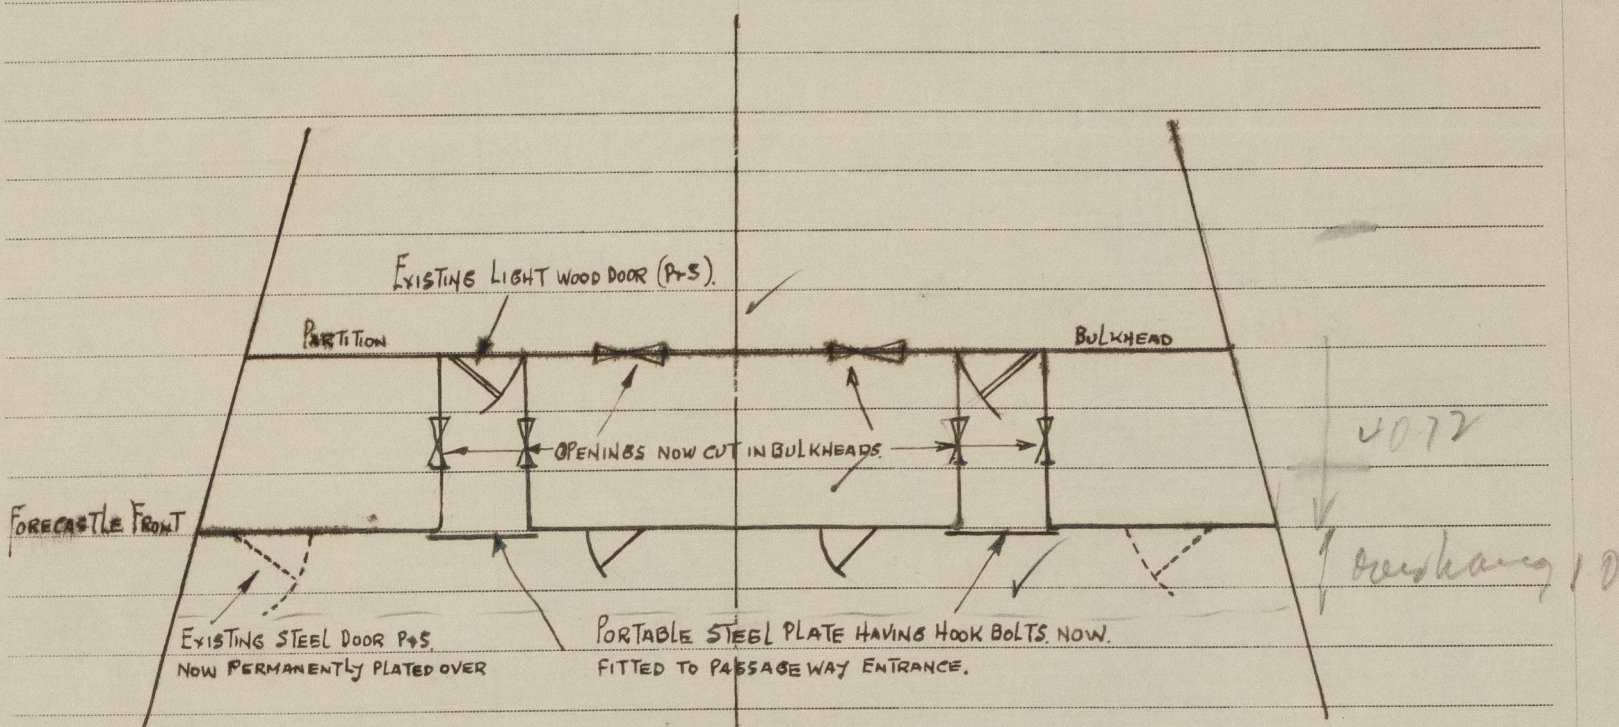

ALTERATIONS NOW CARRIED OUT TO FORECASTLE FRONT BULKHEAD.

A COPY OF THE ABOVE PLACED ON BOARD SHIP.

S. Little

14-11-47.

Newcastle-on-Tyne.

The above makes no difference to the computation
and pressures assigned

A.R.

18-11-47.