

11.7.13.

PROFIL & DECK PLAN



N^o 576-80-85-6

SCALE 1/4 INCH

DIMS. 136'8" x 23'3" EXT. x 13'0" MLD.

PLAN No. 357B
DATE 10/11/13

how WT. Bld
WT Bld
deepened with

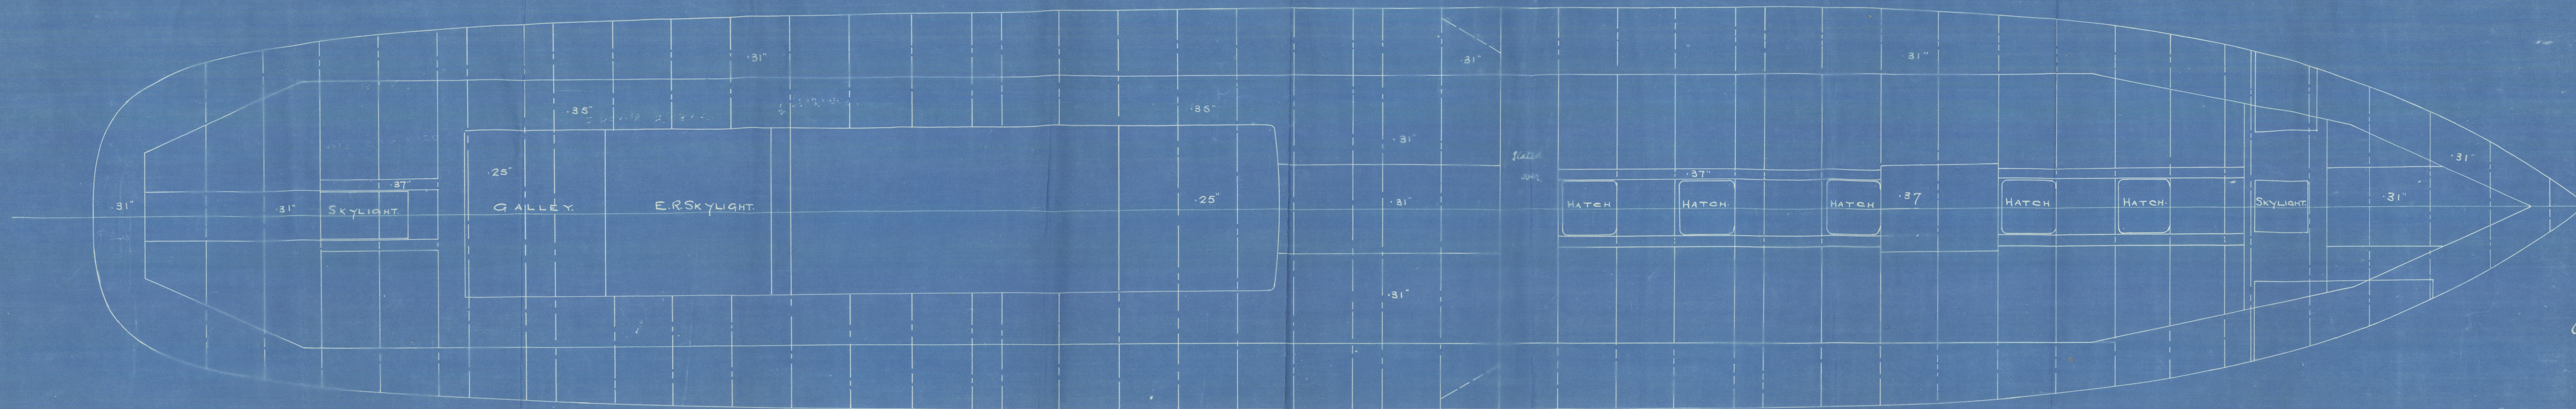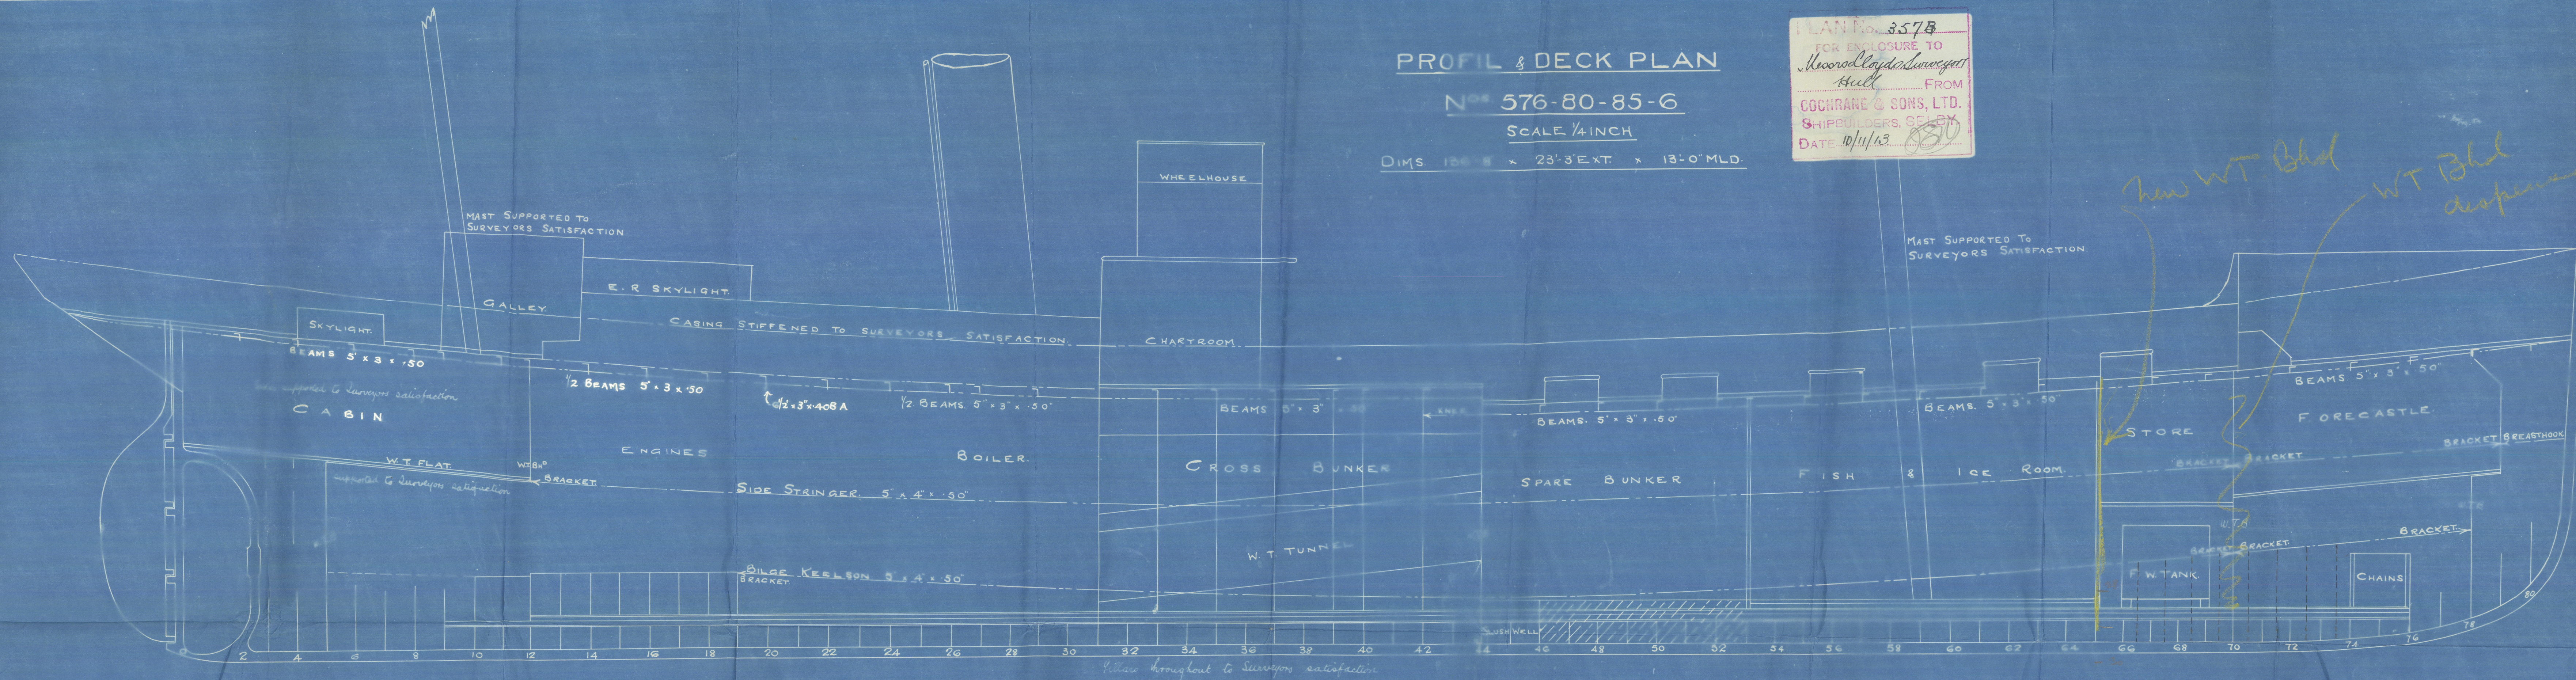

Jan 11.7.13

Lloyd's Register Foundation

Cochrane & Sons, Ltd.
Nos 576, 580, 585, 586.

Duplicate

Profile & Deck Plan.

1/2 Lord Rundlesborough

Steel Rpt No: 26953.

1/2 J. R. Herens

Steel Rpt No: 26994



RETAIN



© 2020

Lloyd's Register
Foundation

004238-004248-0163