

11.7.13


PLAN No. 3574
FOR ENCLOSURE TO
Messrs Lloyd's Surveyors
Hull FROM
COCHRANE & SONS, LTD.
10/11/13

MIDSHIP SECTION STEEL SCREW TRAWLERS

Nos 576-80-5-6

DIMENSIONS: 136'-8" B.P. x 23'-3" EXT. 13'-0" MLD.
SCALE 1/2" INCH.

TO CLASS 100 A.1 STEAM TRAWLER.
DECK PLATED OVER IN WAY OF MACHINERY
CASING AS PREVIOUSLY APPROVED.

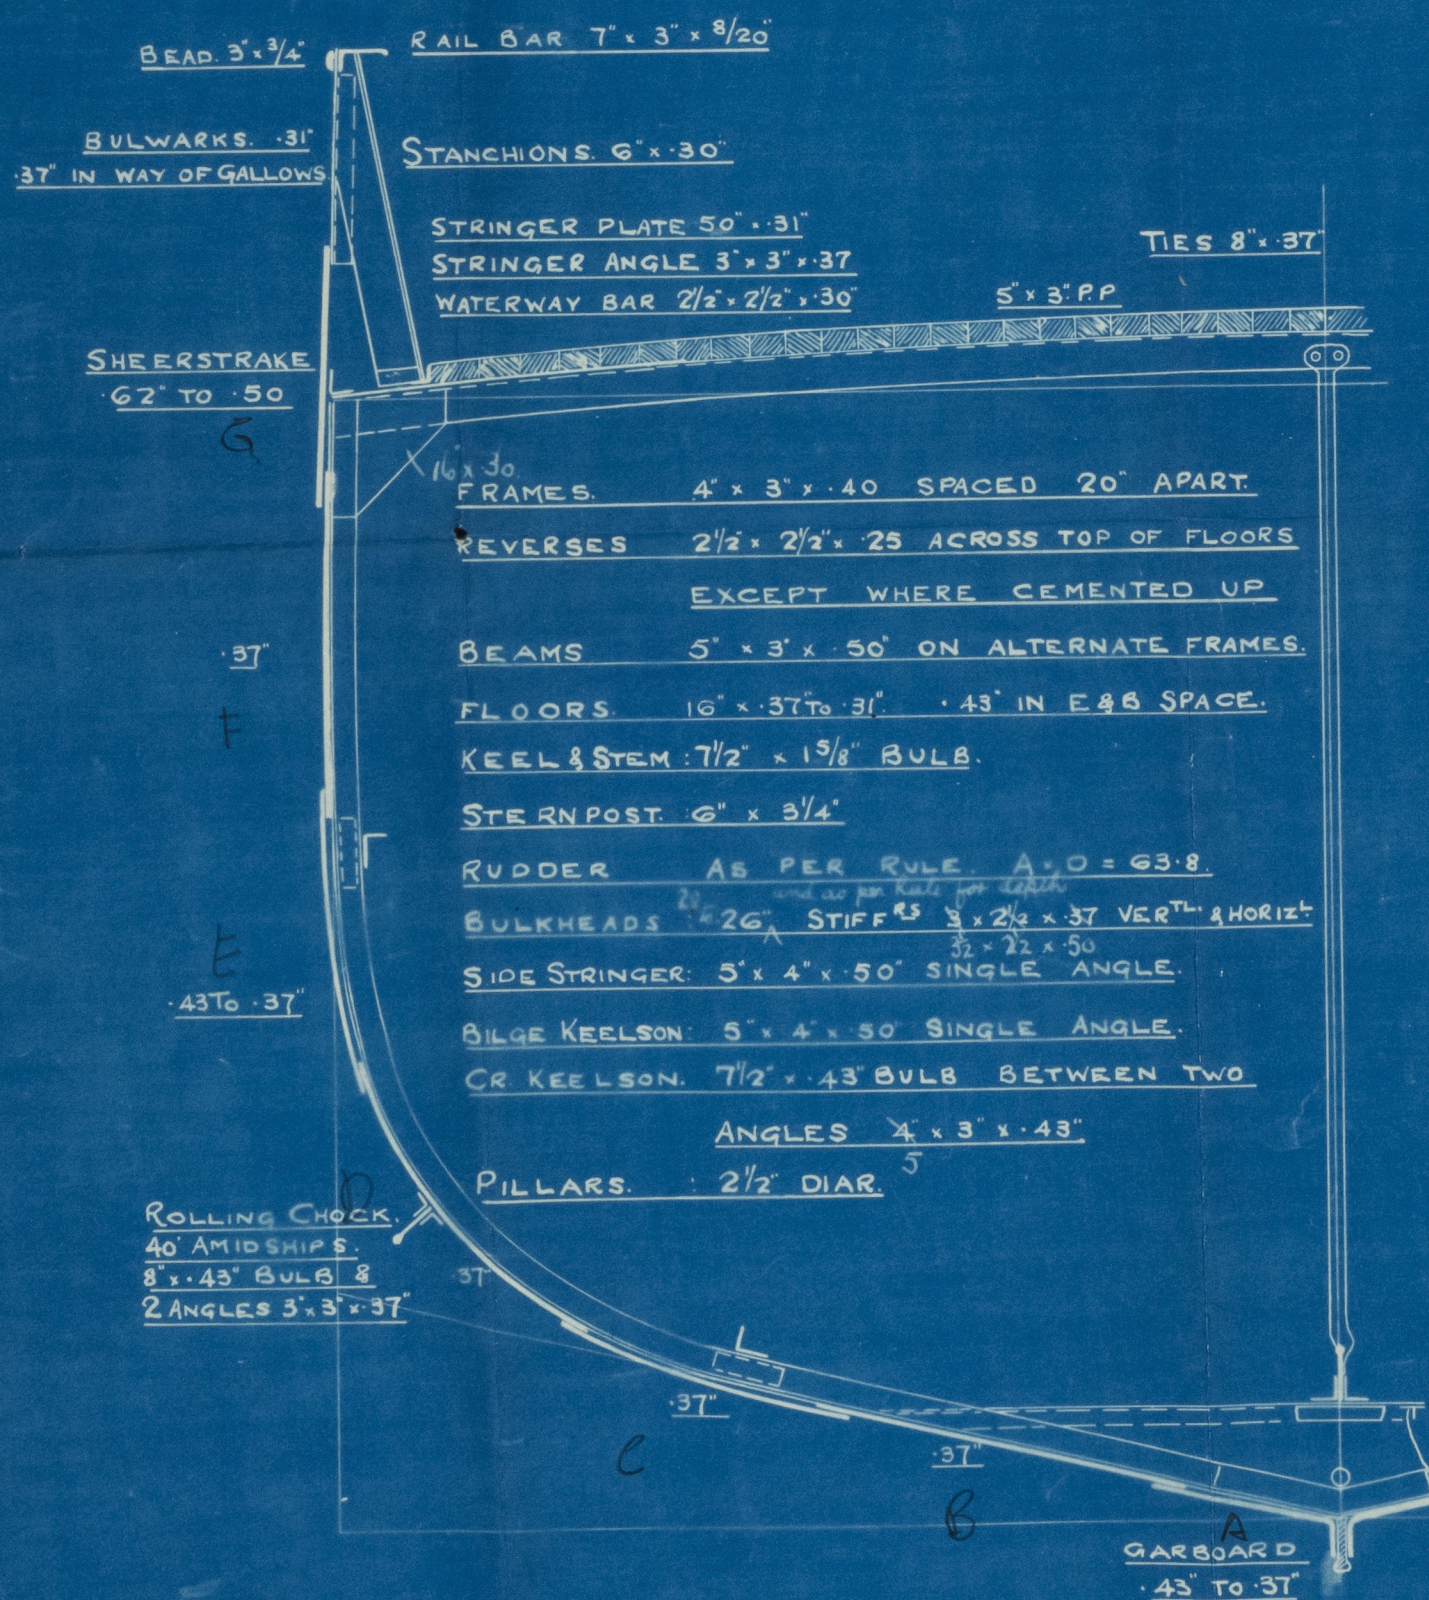

NUMERALS.

B + D ----- = 36.12
L x (B + D) ----- = 4936.15

PROPORTIONS.

L ----- 10.51
D -----
L ----- 5.91
B -----

EQUIPMENT.

1 ANCHOR ----- 6 CWTs EX STOCK.
1 " ----- 5 1/2 " " "
1 " ----- 3 " " "
120 FATHOMS. ----- 1 1/16 STUDLINK CABLE
60 " ----- 6" HAWSER.
60 " ----- 5" WARP.

RIVETING.

BUTTS OF SHELL PLATING OVERLAPPED AND
DOUBLE RIVETED. EXCEPT GARBOARD & SHEERSTRAKE
WHICH ARE TO BE STRAPPED & DOUBLE RIVETED.
LANDINGS DOUBLE RIVETED.
BULWARKS STRAPPED & SINGLE RIVETED.

Jul
11.7.13

004238-004248-0164



Lloyd's Register
Foundation

Cochran & Sons.
Nos 576. 580. 585. 586

Duplicate

Midship Section

1/2 Lord Londesborough

Hull Rpt No: 26953

1/2 J. R. Fenn.

Hull Rpt No: 26994.



© 2020

Lloyd's Register
Foundation

004238-004248-0164