
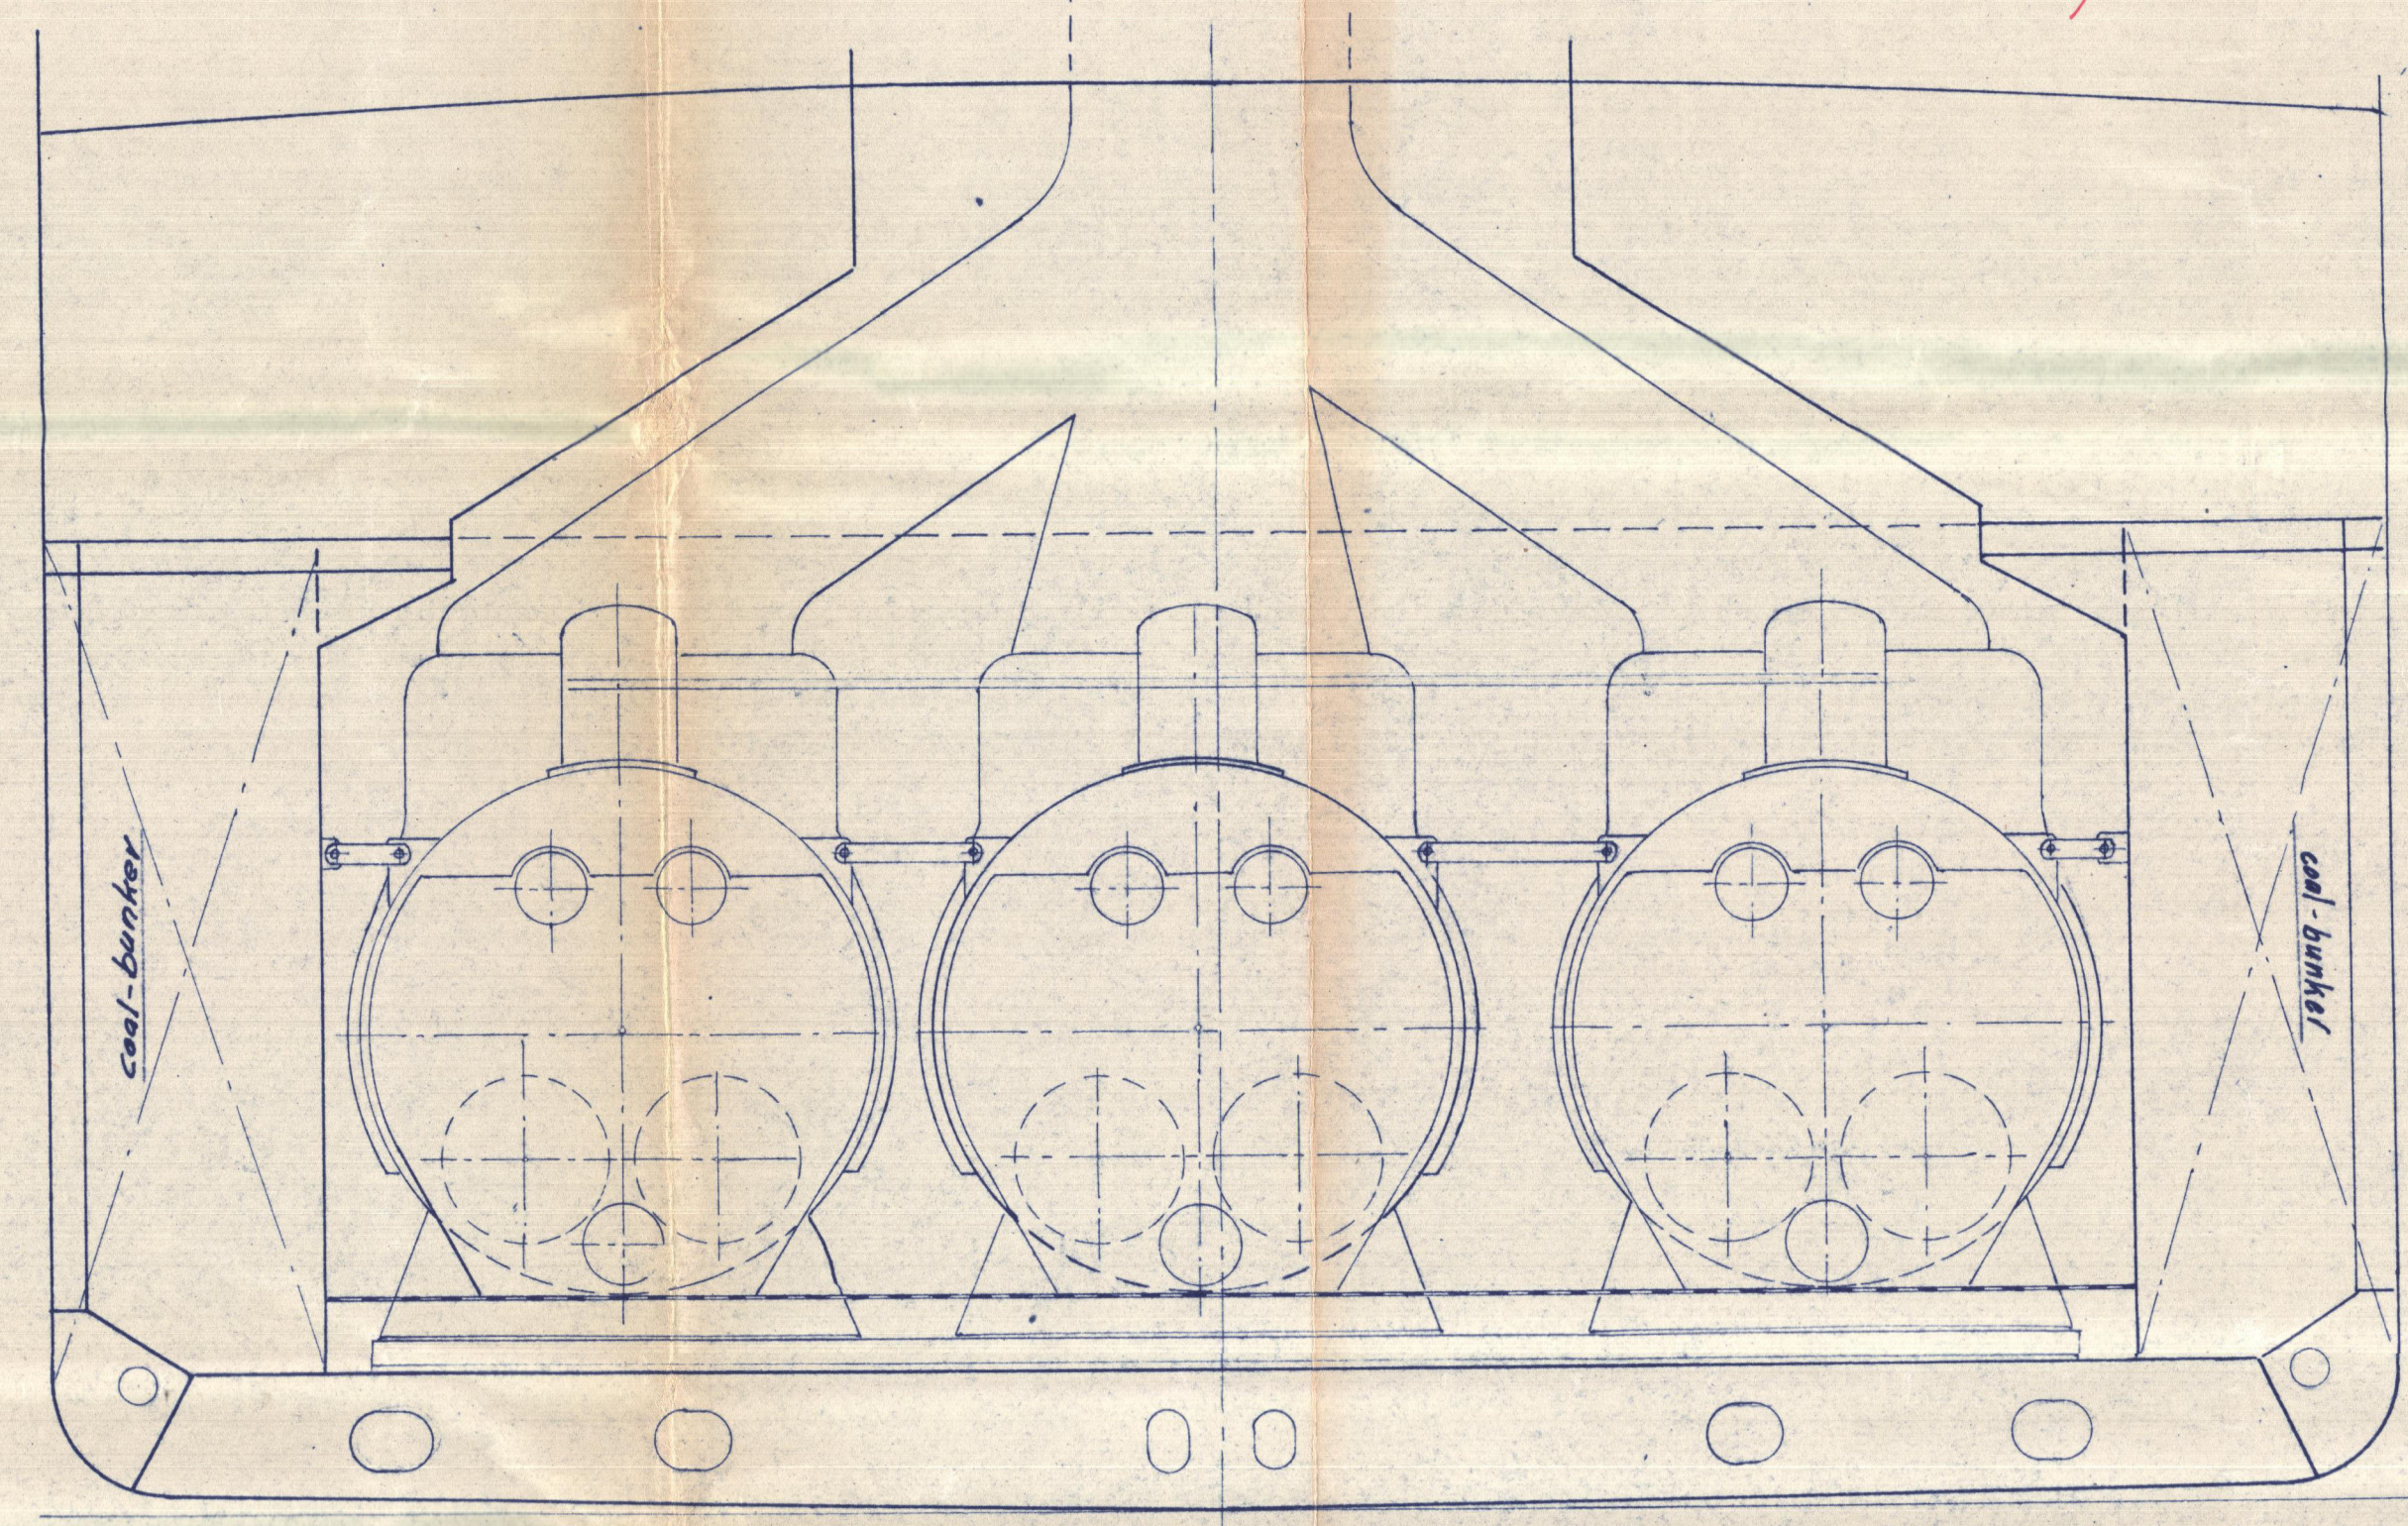


Siyktisten udførsel					Lystryk				
Ant.	Bygn. Nr.	Grp. Nr.	Grp. Nr.	Dato	Ant.	Sendt til	La. Nr.	La. Nr.	Dato
1	#80			1946	2	Bureau Dy. 14	14	14	1946



24 SEP 1946

AC.

Approved by  
Group No.

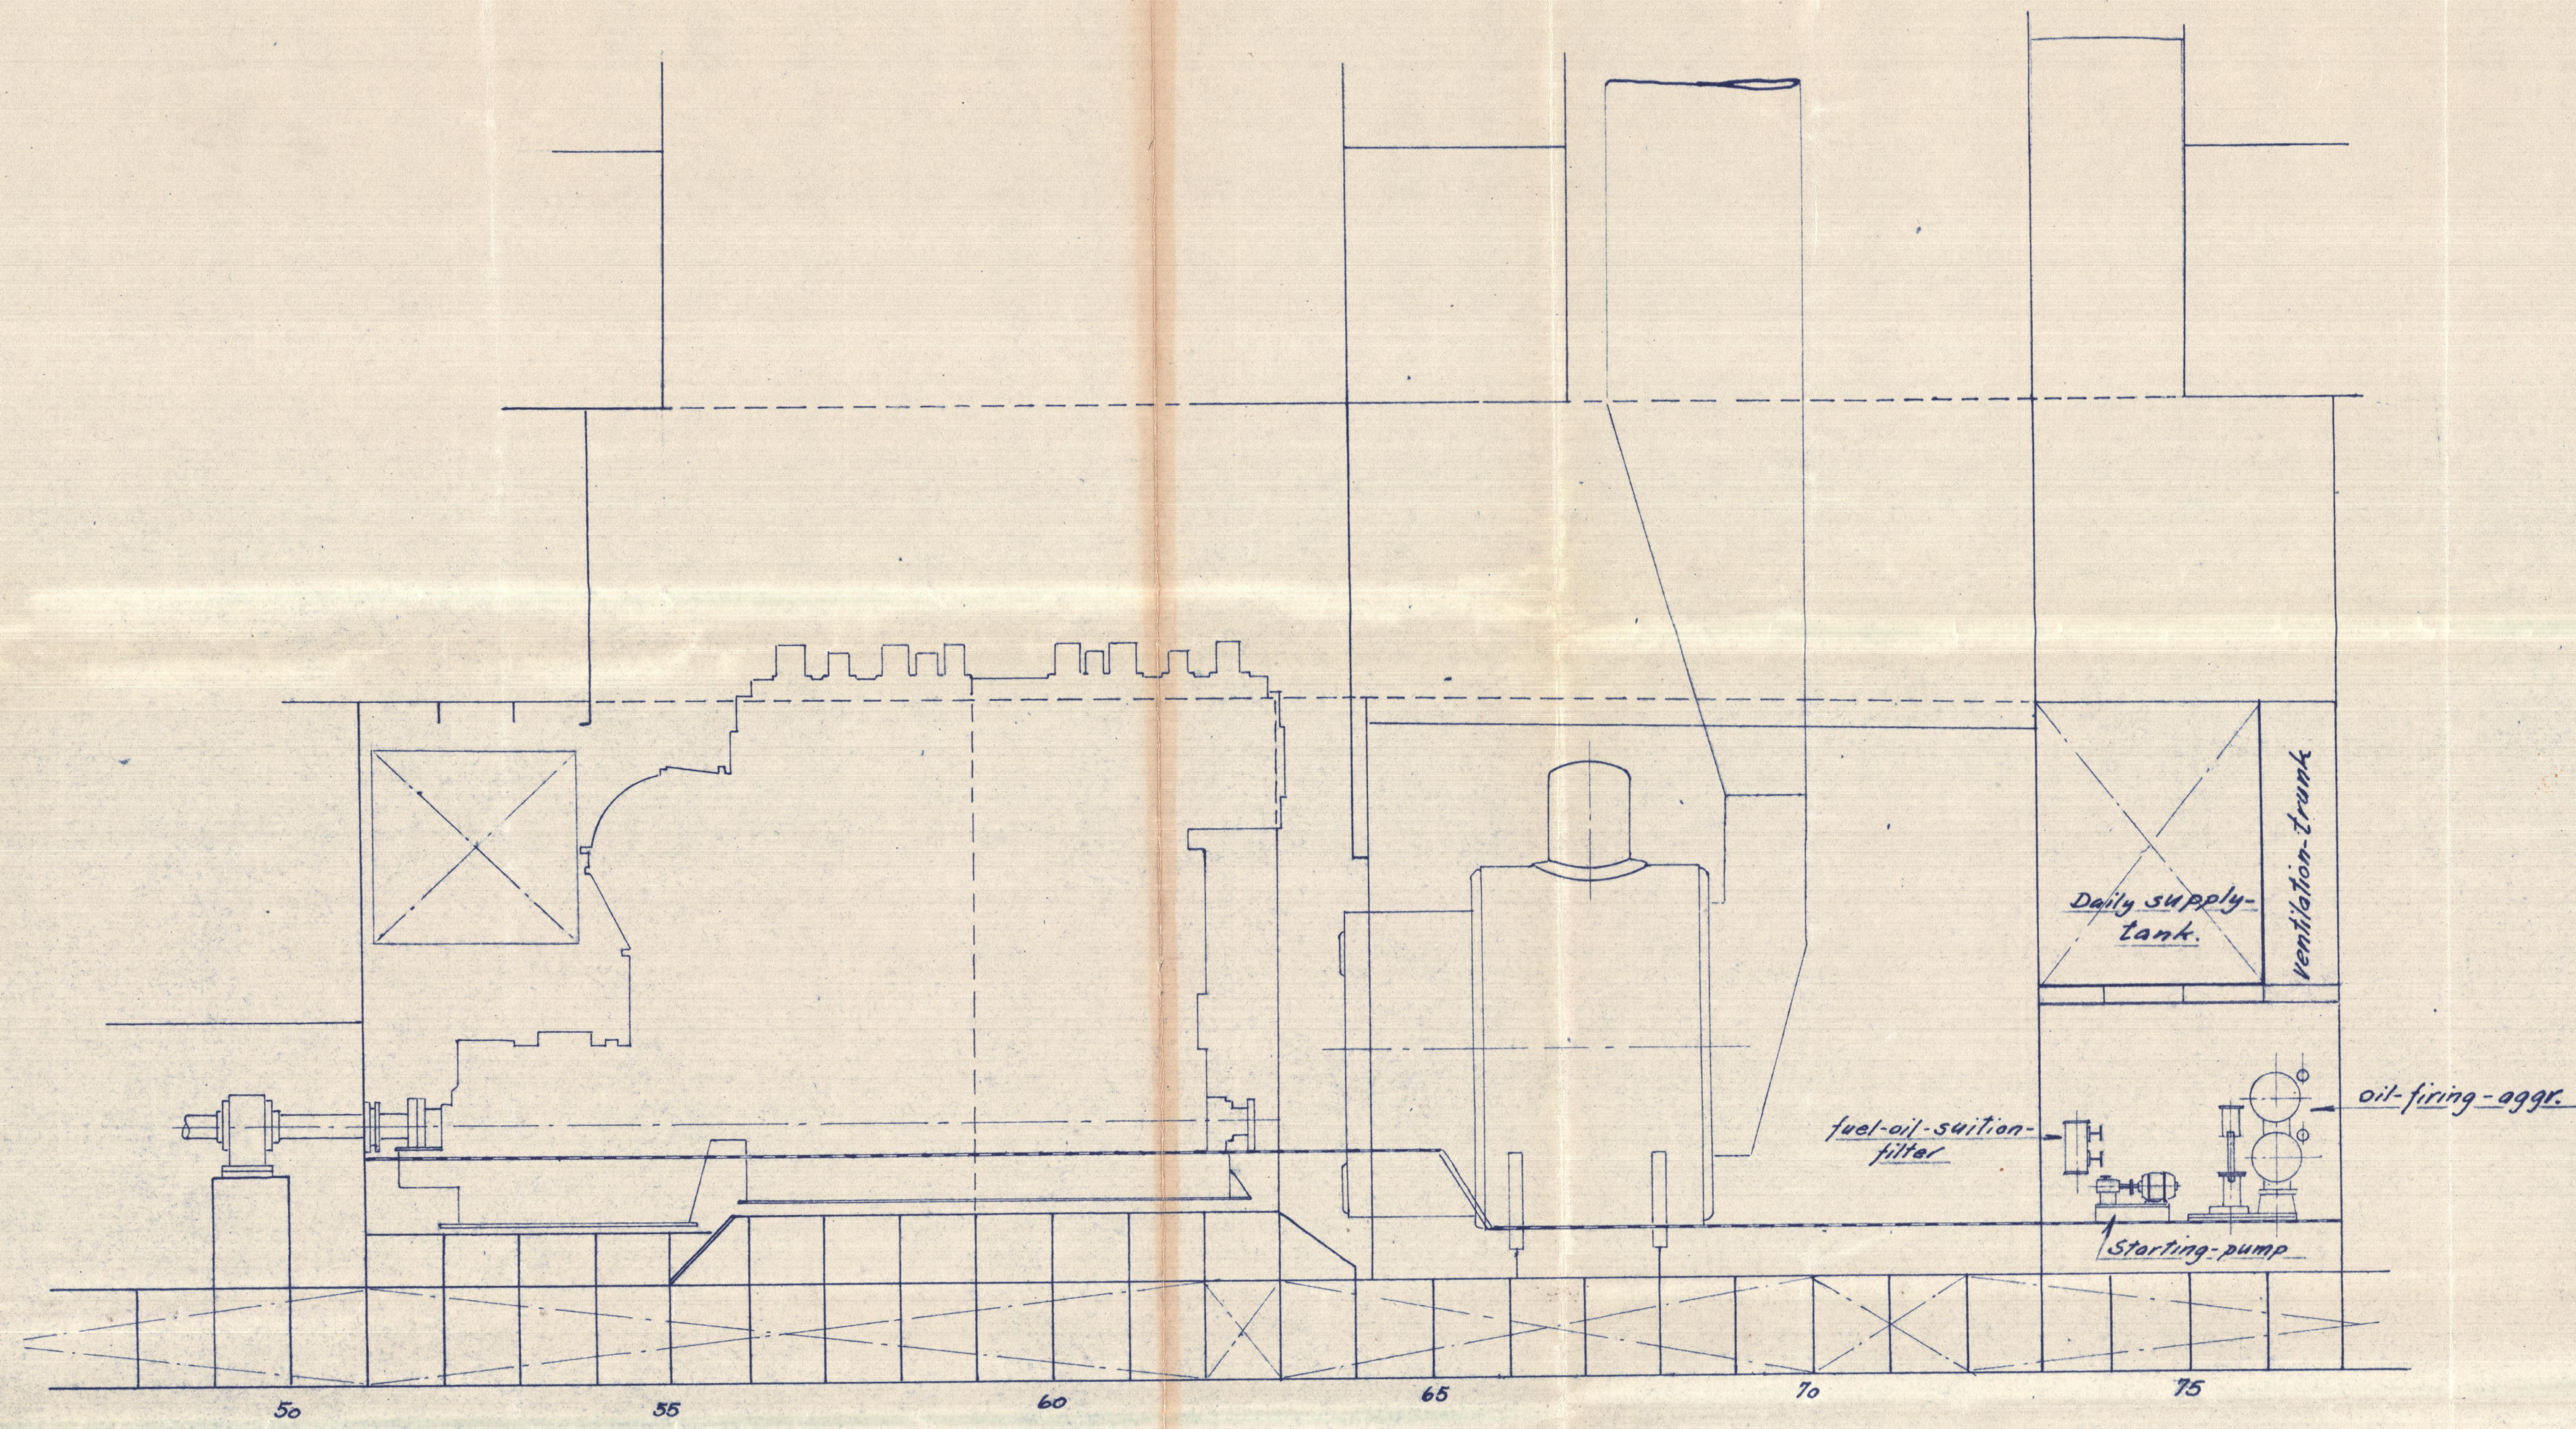

frame 65 - looking - from

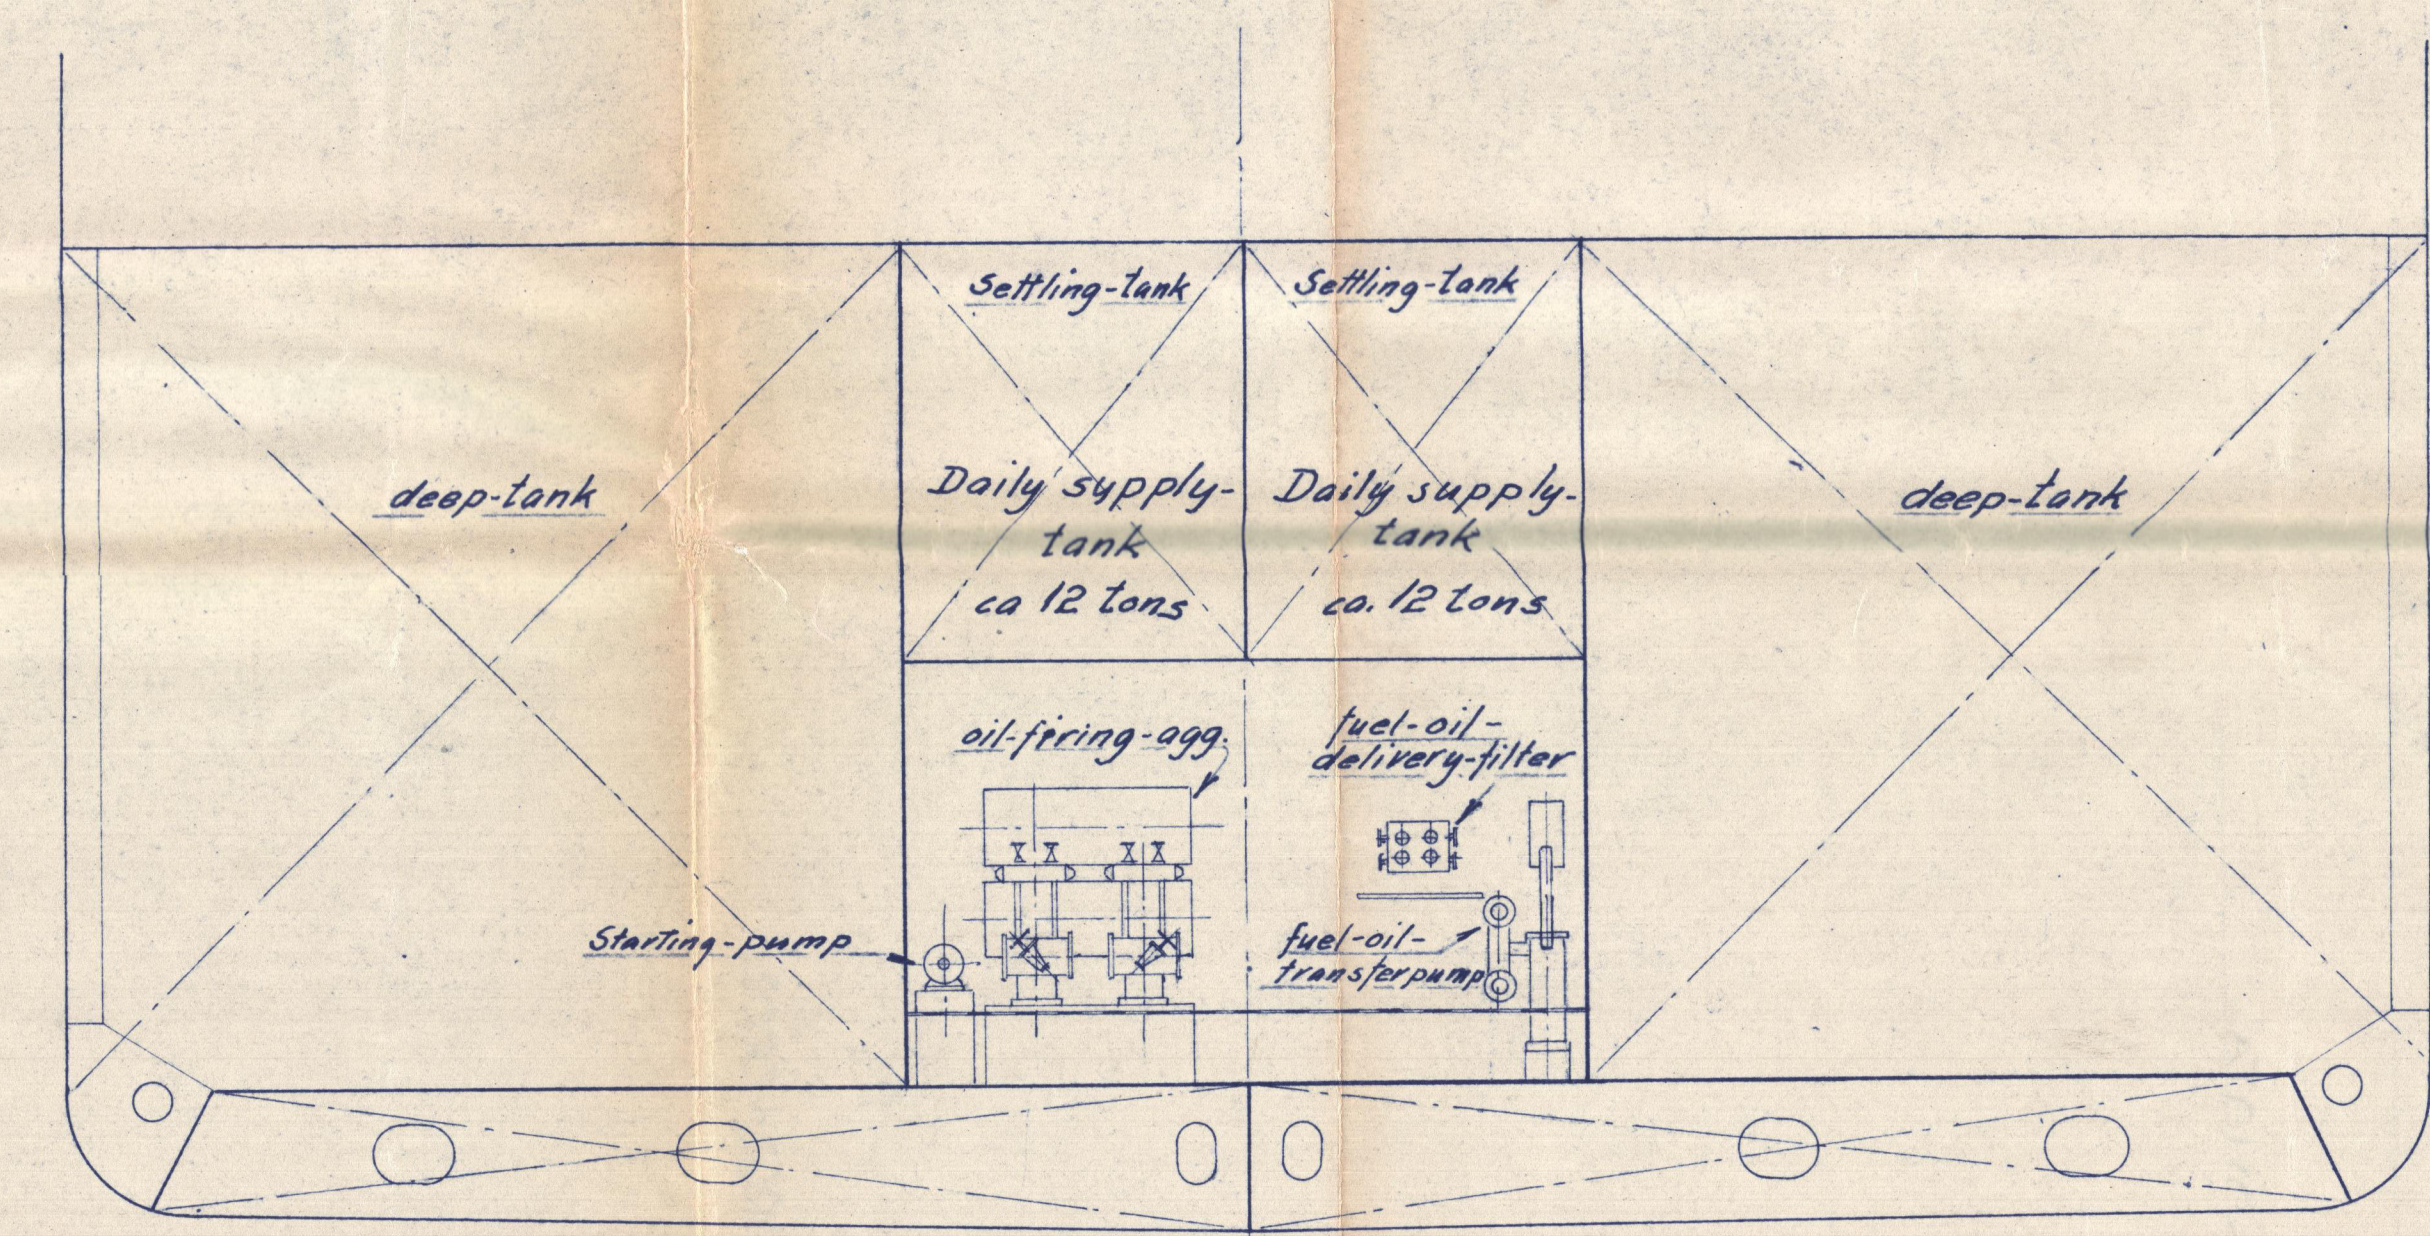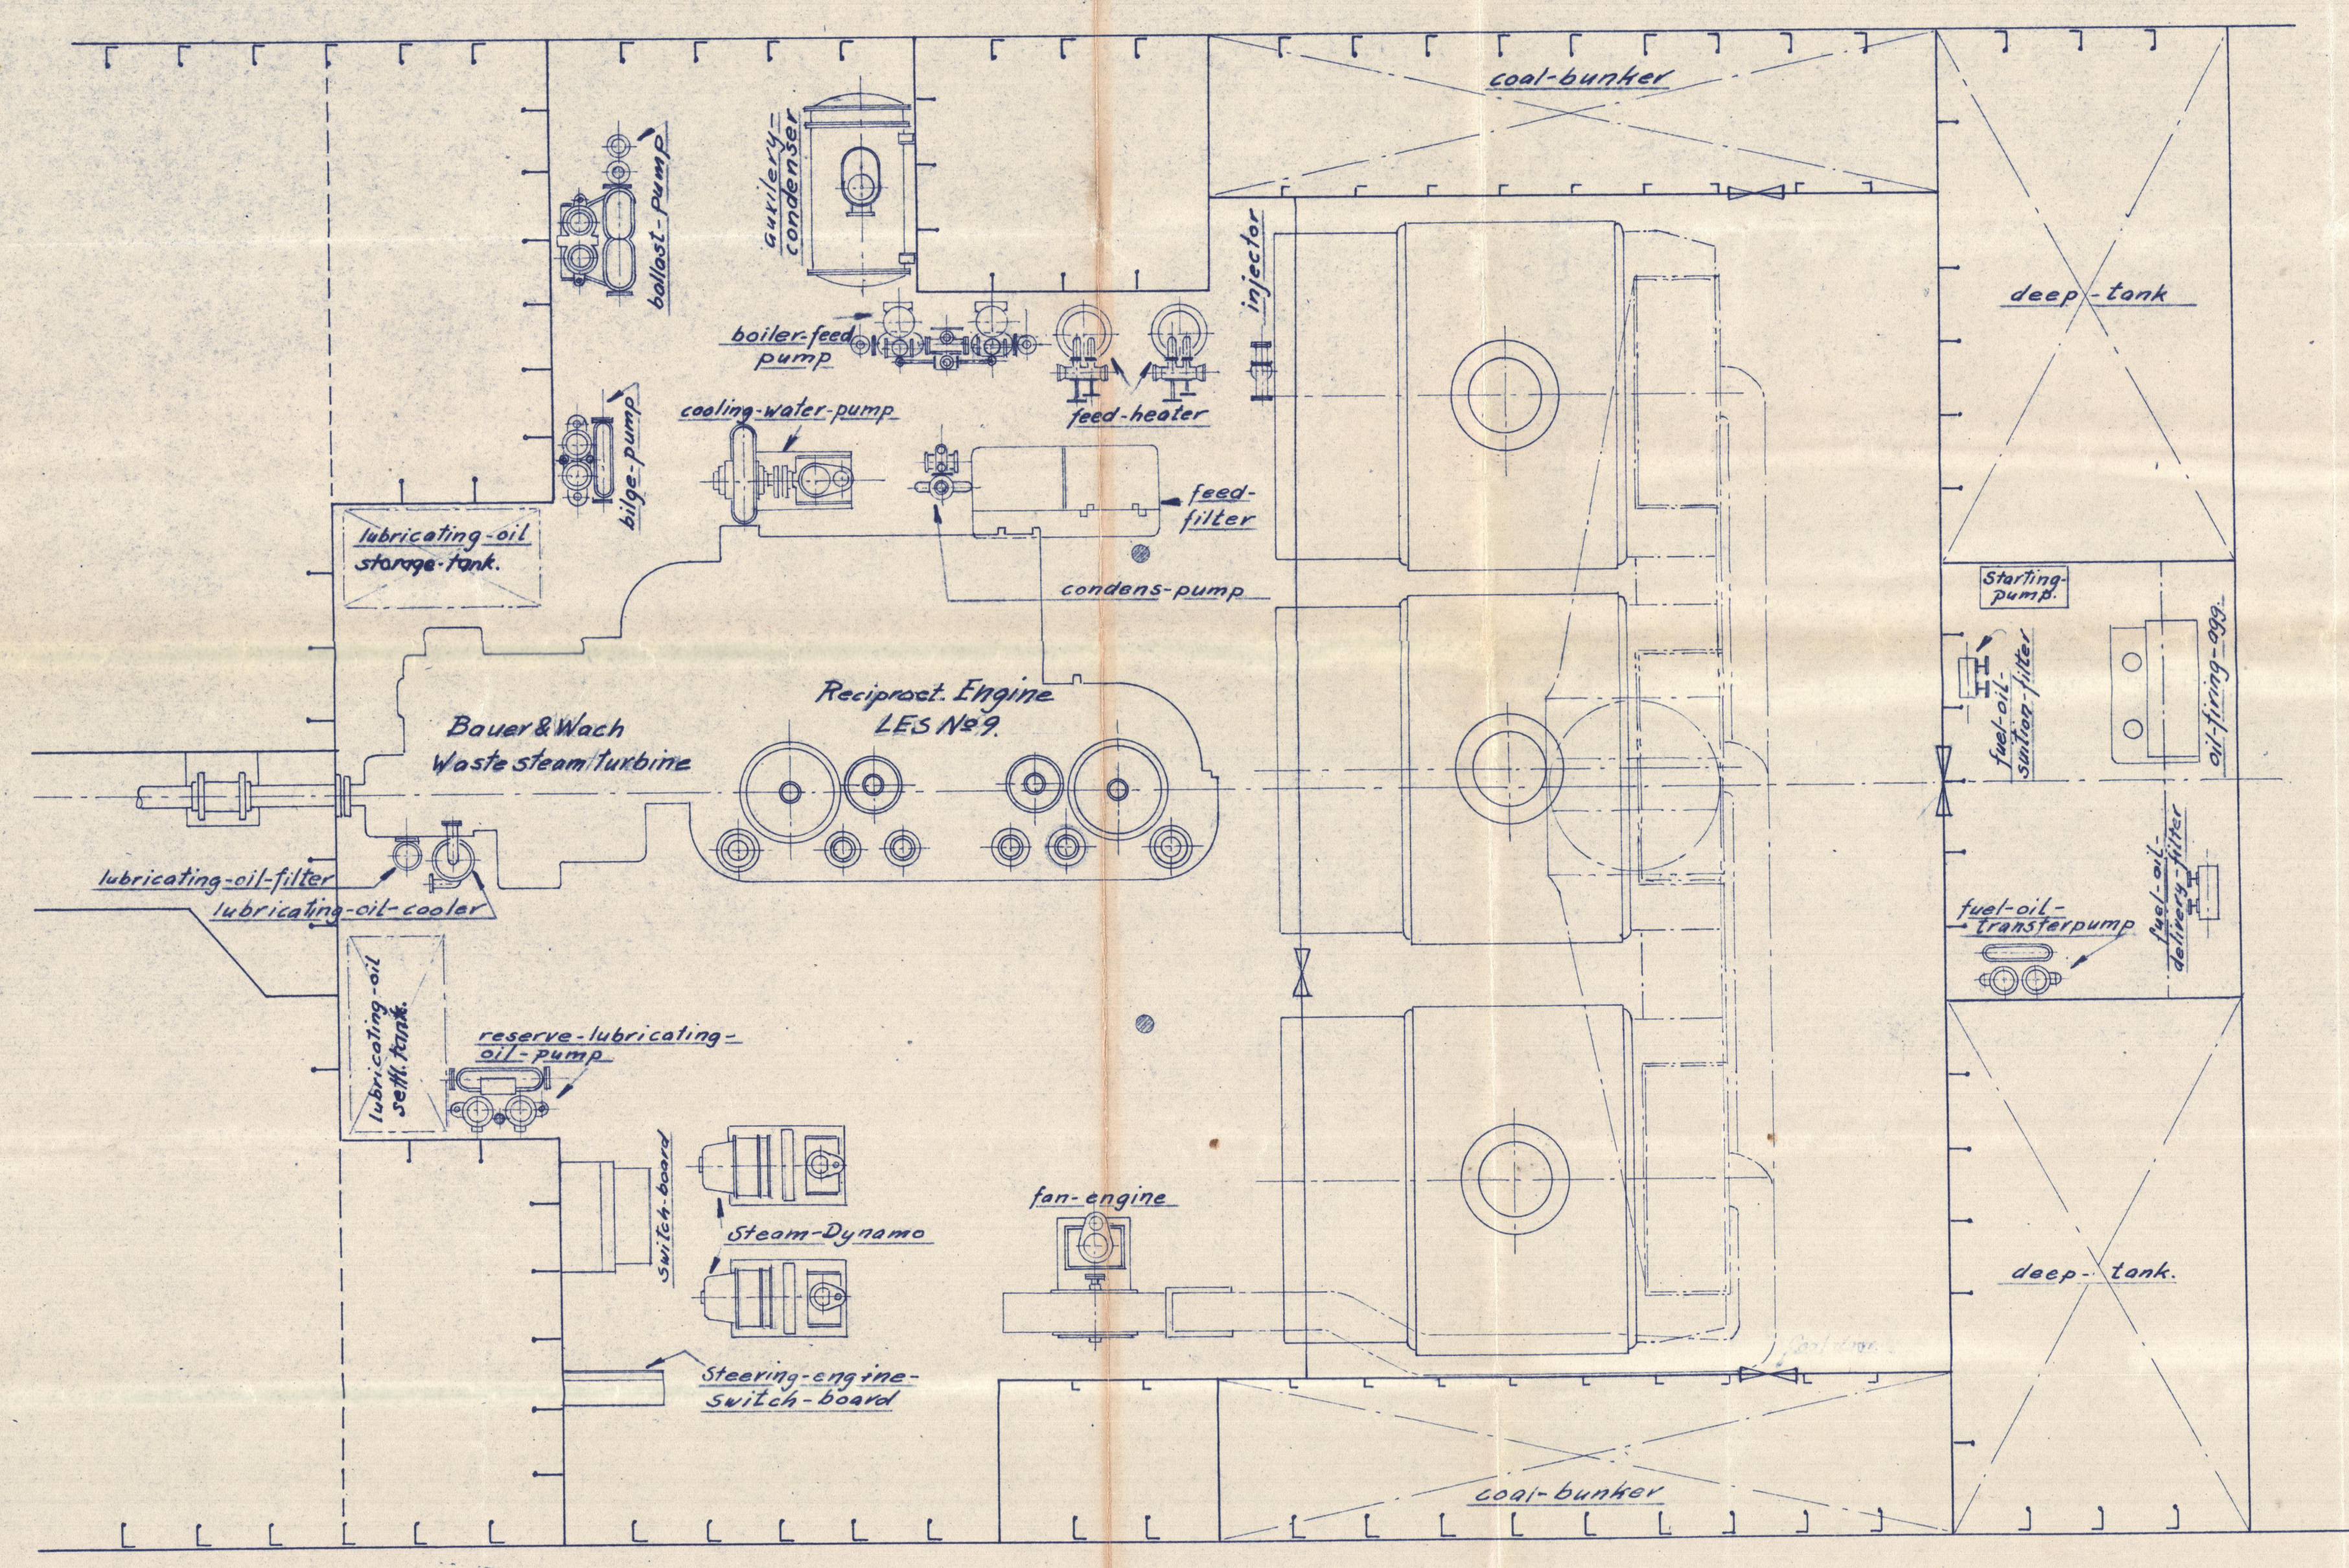

frame 74 - looking - from

TRAVATA

AALBORG VÆRFT  
 MASKINARRANGEMENT  
 Engine-arrangement  
 Oil-firing-installation  
 1:50  
 25. 8. 46  
 5924  
 Foundation

001251-001262-0002

5924  
#80



5

TRANSFERRED TO  
L. R. SYSTEM

Machinery Arrgt (Sheet 2)

Aalborg Vaerft.

N<sup>o</sup> 81.

26.10.16.

Bokefors ex. TRAVIATA



© 2020

Lloyd's Register  
Foundation

004257-004262-0002



Engine Argt. Oil-Firing  
Installation.

Aalborg Vaerft  
(S/S. Traviata)

24 SEP 1946

Retain

004257-004262-0002



© 2020

Lloyd's Register  
Foundation