


9.12.48

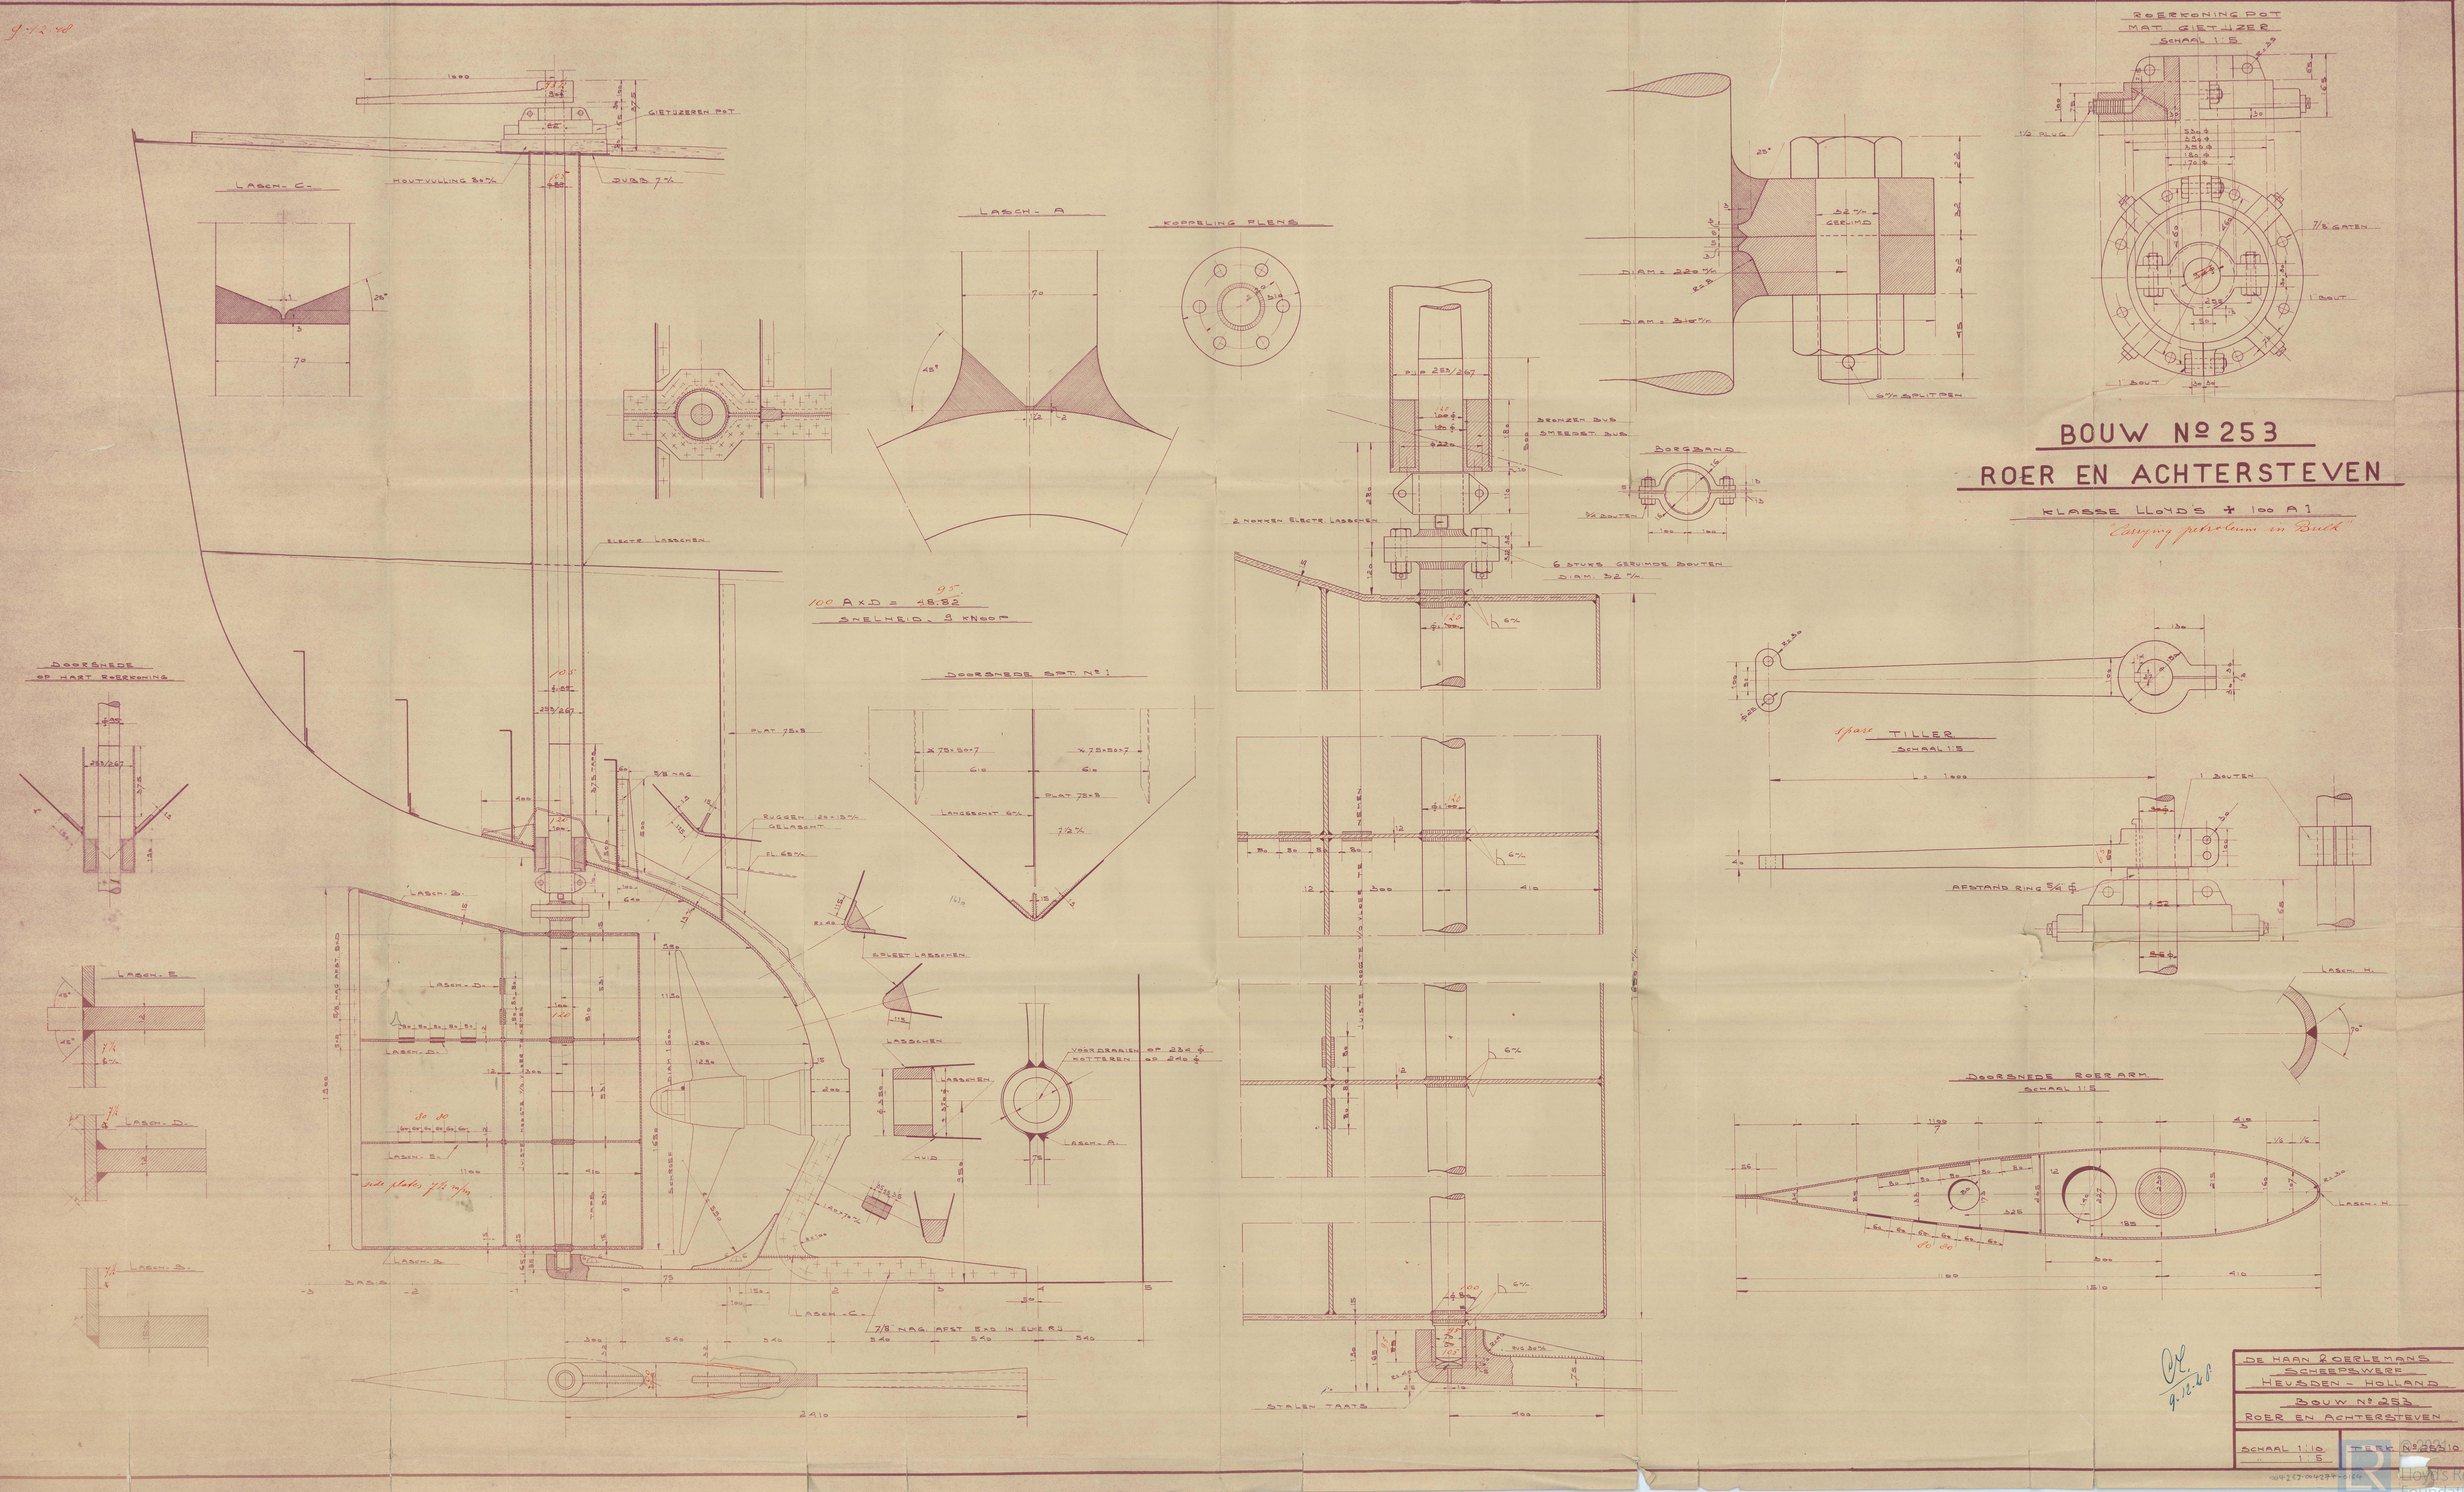

OK.
9-12-48


SCHAAL 1:10
TEEK. N° 25310

TEEK. N° 25310

304-253-004274-0164

Lloyd's Register
Foundation

RECORDS DEPT.
LONDON

"ELIZABETH B." ★

3

DE HAAN & DERLEMANS
YARD NO. 253

STERN FRAME & RUDDER

Lloyd's Register
Foundation

7.

DE HAAN & OERLEMANS

YARD No 253

STERNFRAME & RUDDER,

004263-004274-0164

IR
ANS
AND
© 2021
SEVEN
No 25310