

26 FEB 1945

Lloyd's Register of Shipping. MDB. 17744.

Ship's Name *s/s. "WAYE EMPEROR"*

Official No. *180034*

REPORT N^o MIDDLESBROUGH. *17744.*

Memorandum of alterations reported since ship was surveyed for assignment of Load Lines in WHILE BUILDING AT MIDDLESBROUGH.

ALTERATIONS MADE BEFORE VESSEL COMPLETED.

BRIDGE, AFTER BULKHEAD :- ONE HINGED W.T. STEEL DOOR ON STARB^d SIDE DELETED. ✓

POOP DECK, AFT END :- HATCH TO STEWARDS STORE FITTED WITH HINGED STEEL COVER .40". IN LIEU OF WOOD COVERS ✓


VENTILATORS:-

FORECASTLE DECK. (STARB^d SIDE) ONE 10" DIA VENT: DELETED AND REPLACED BY ONE 15" DIA. VENT:, COAMING 36" x 36" CLOSED WITH WOOD PLUGS & CANVAS COVER ✓

POOP DECK (P&S). TWO ADDITIONAL VENTS FITTED OVER

STEERING GEAR COMPARTMENT.

16" DIA: x 39 1/2" x .38" COAMING, MUSHROOM TYPE. ✓

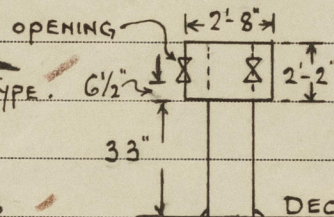

POOP DECK. TWO 16" DIA. VENTS TO POOP PASSAGEWAYS ✓

AT AFTER END P&S, COAMINGS INCREASED

IN HEIGHT TO 8'-9" x .38", STAYED TO BOAT DECK. ✓

CLOSED WITH WOOD PLUGS AND CANVAS COVERS. ✓

H.C. Young

Noted
17 FEB 1945
J.P.S.