

Nº 356-7 & 8-9-360

Nº 357

# MIDSHIP SECTION.

DIMENSIONS:- 465'-0" B.P. x 64'-0" MLD. x 35'-6" MLD. TO UPPER DECK.  
SCALE:- 1/2" = 1 FOOT.

DRAWING Nº 1

## LLOYD'S NUMERALS:

1st Longitudinal Nº 16100  
2nd " 45660  
3rd to Upper Deck 13-10


To class 100 A1 at Lloyd's carrying petroleum in bulk  
Longitudinal Framing at bottom & at deck

Equipment  
465 (64 x 35.5) 46267  
Poop 121 x 7.5 x 7.5 664  
Bridge 44 x 7.5 x 7.5 250  
Forecastle 66 x 7.5 x 7.5 374  
Houses 217 x 7.5 x 50 614  
46369

2 Bower Anchors 8 1/2 cwt each stockless.  
1 Stream Anchor 23 1/2 " ex stock  
200 Fathoms 2 3/4 Layed Stud Link Chain  
120 " 4 1/2 Flexible steel wire 6 x 24  
130 " 5 1/2 " 6 x 24  
2 Hawseers 100 Fathoms 2 3/4 " Steel wire 6 x 12  
2 Warps 100 " 2 3/4 " 6 x 12

NOTE:- SHELL BUTTS WELDED IN Nºs 359-360  
UPPER + POOP-BRIDGE + FOLE DECK BUTTS WELDED } IN Nºs 356-7-8-9-360.  
BRIDGE DECK SEAMS WELDED.


NOTE:- ALL SECTIONS ARE N.B.S.

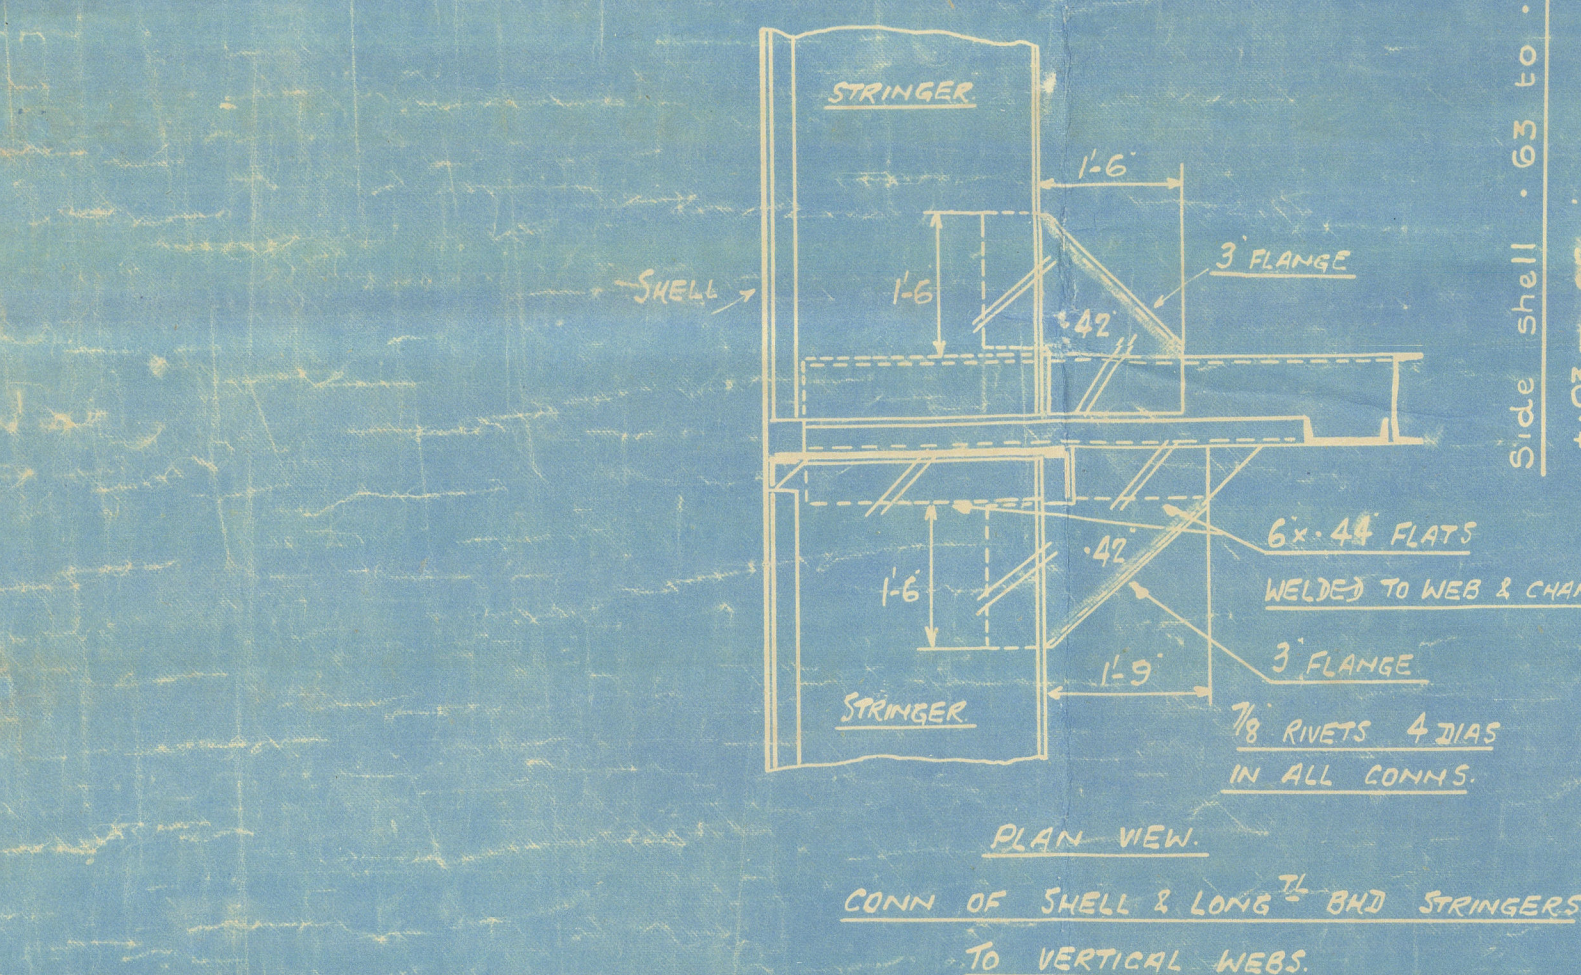

PLAN VIEW.  
CONN. OF SHELL & LONG. BOW STRINGERS TO VERTICAL WEBS





T. Nº 5372

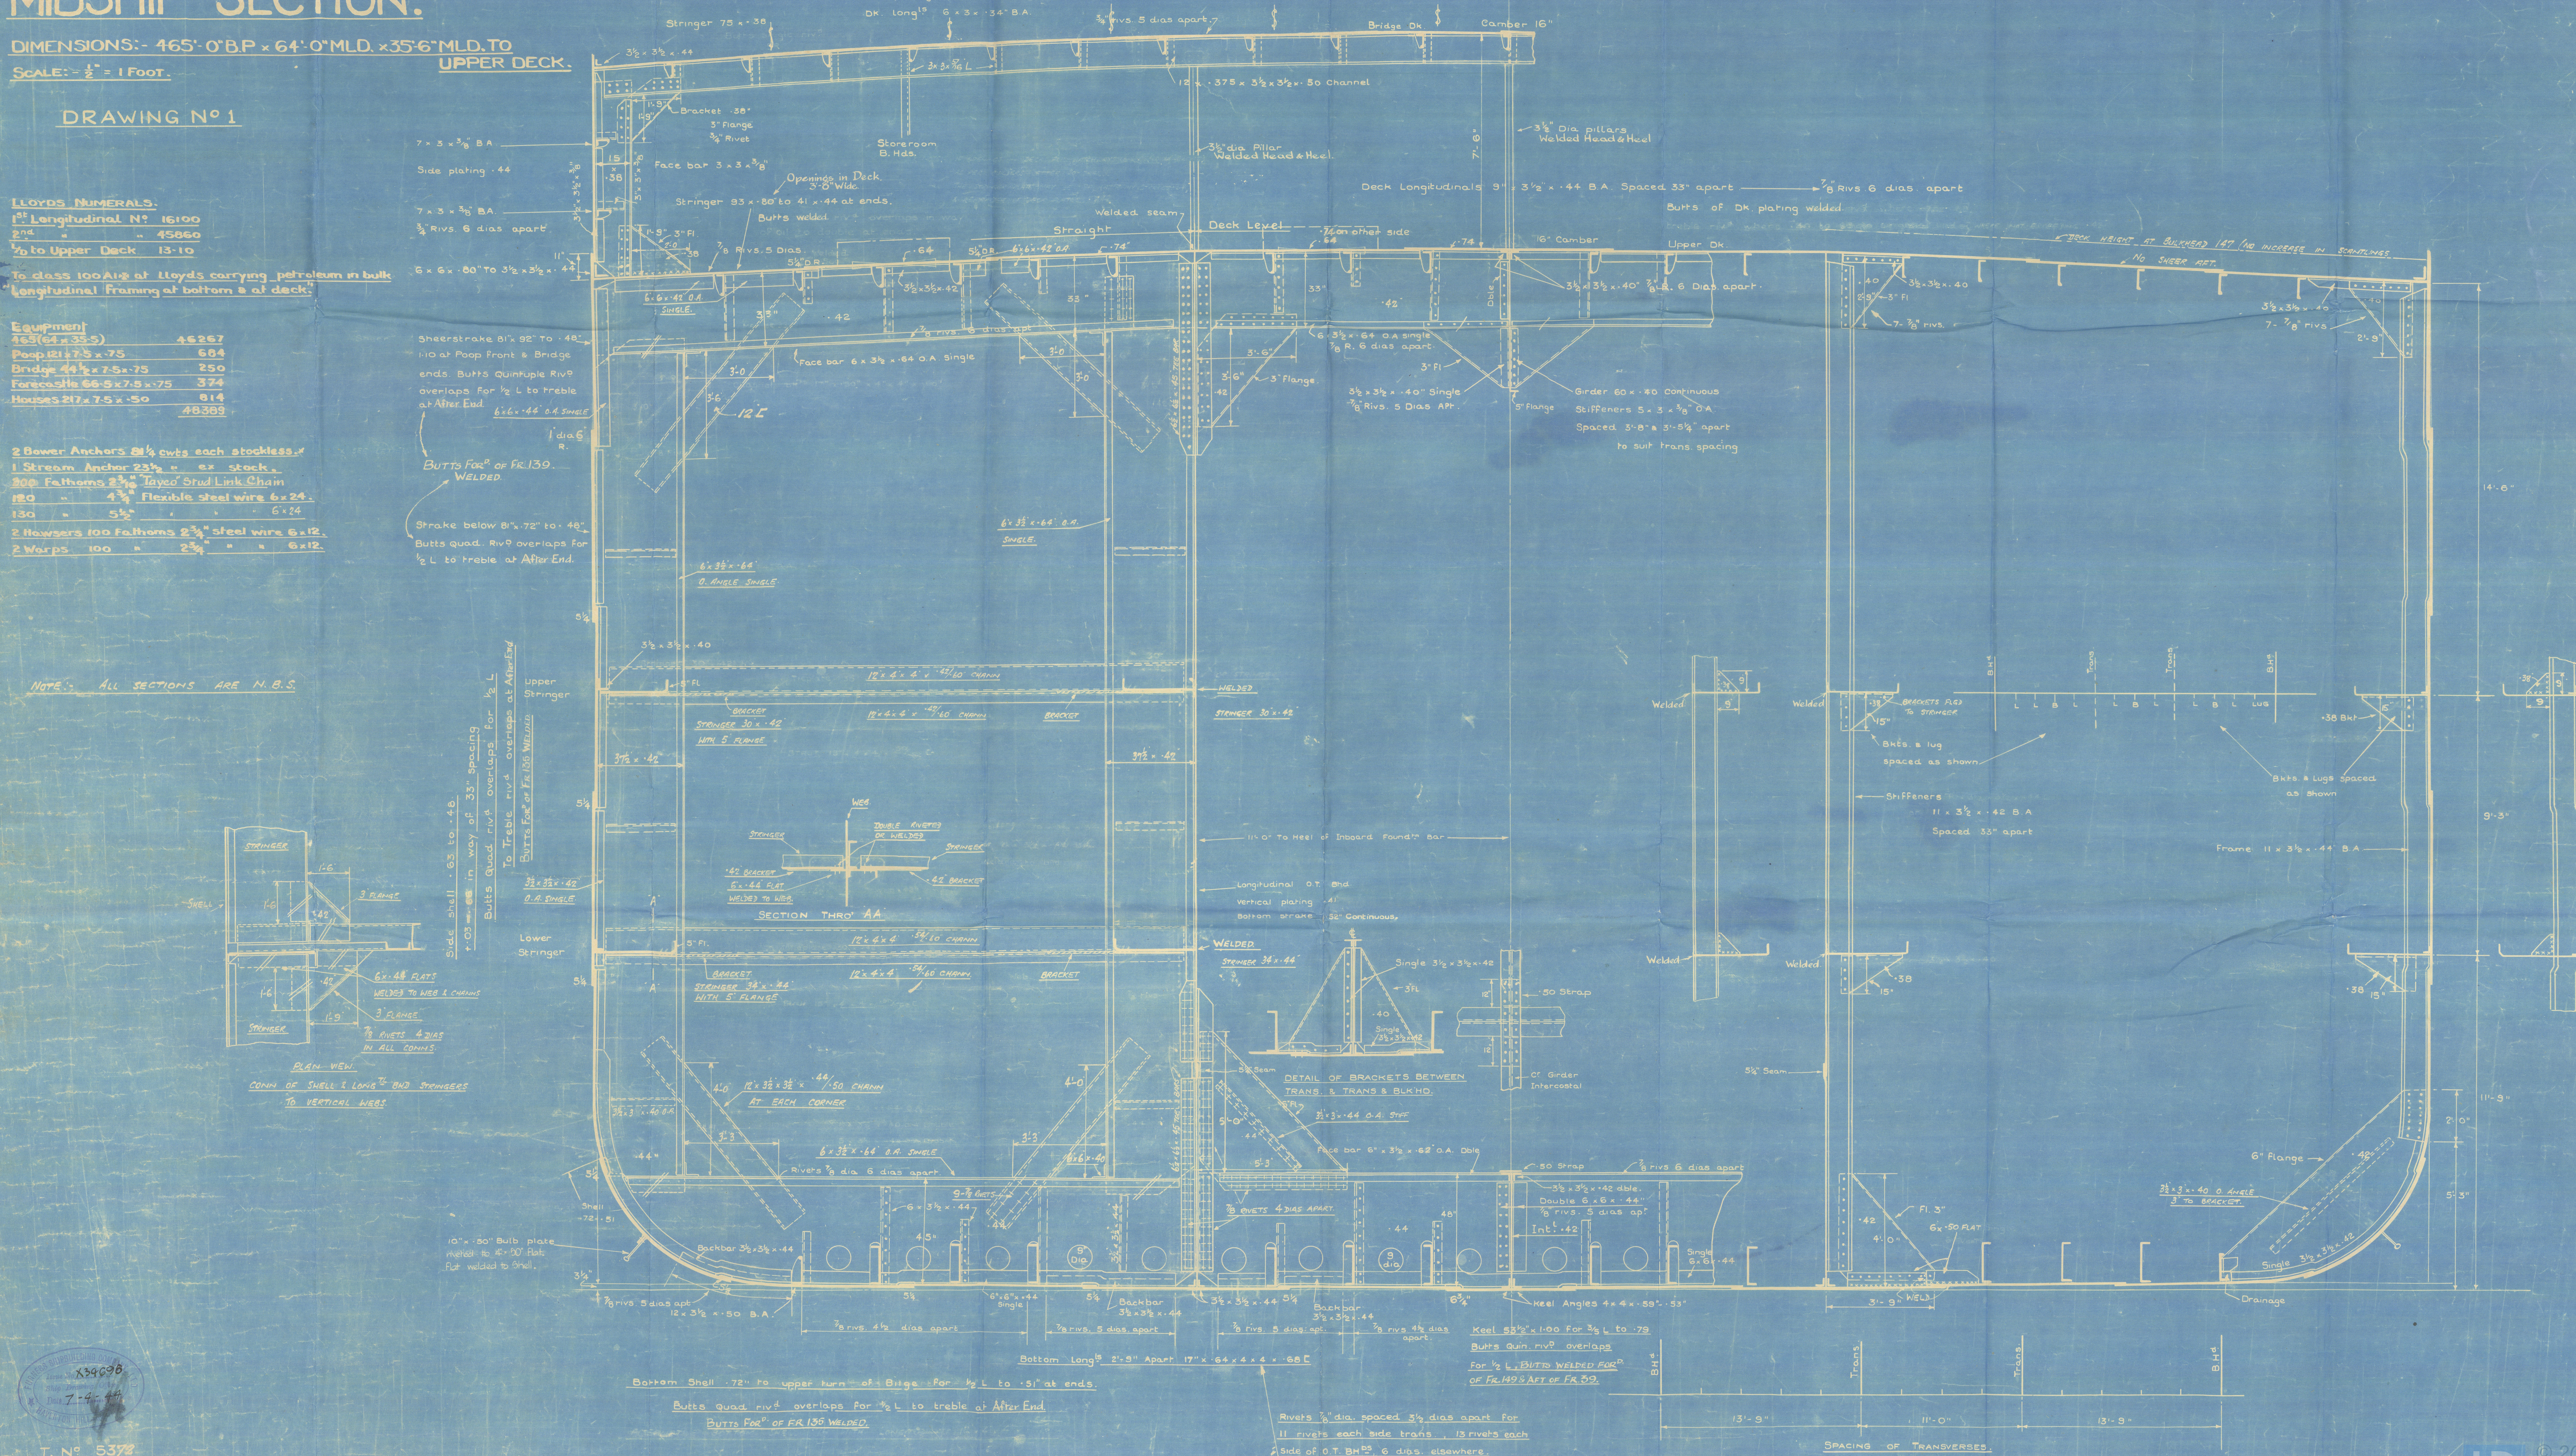

Rivets 3/8 dia spaced 3 1/2 dia apart for 11 rivets each side trans, 13 rivets each side of O.T. BH 25, 6 dia. elsewhere.



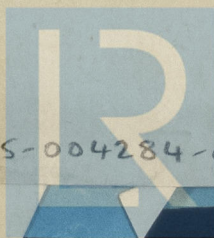 

© 2020

004275-004284-0208

Lloyd's Register  
Foundation



Messrs. Furness Shipbuilding Co

Yard No. 357.

Ship Section (as built)

S.S. "Empire Law"  
MDB. RPT. No. 17621

REMAIN © 2020  
Lloyd's Register  
Foundation

004275-004284-0208