

Office

Class: Lloyds Register of Shipping * 100A1
Scantling Numerals.

S, 65-66.

Cargo Steamer 3400 ts. dw.

Longitudinal Section

Scale 1:100

Principal Dimensions





Length.....(L) = 88,240m ✓
Breadth....moulded(B) = 13,870" ✓
Depth U.D. " (D) = 6,250" ✓
Depth Br.D. " = 8,535" ✓

Fore Castle Deck

Poop-Deck.

D.....6,250 ✓
L-D.....551,500 ✓
L(B+D).....1775,388 ✓
L/D.....14,12 ✓
L/D Br.D.....10,35 ✓
d.....5,36 ✓

Bridge-Deck

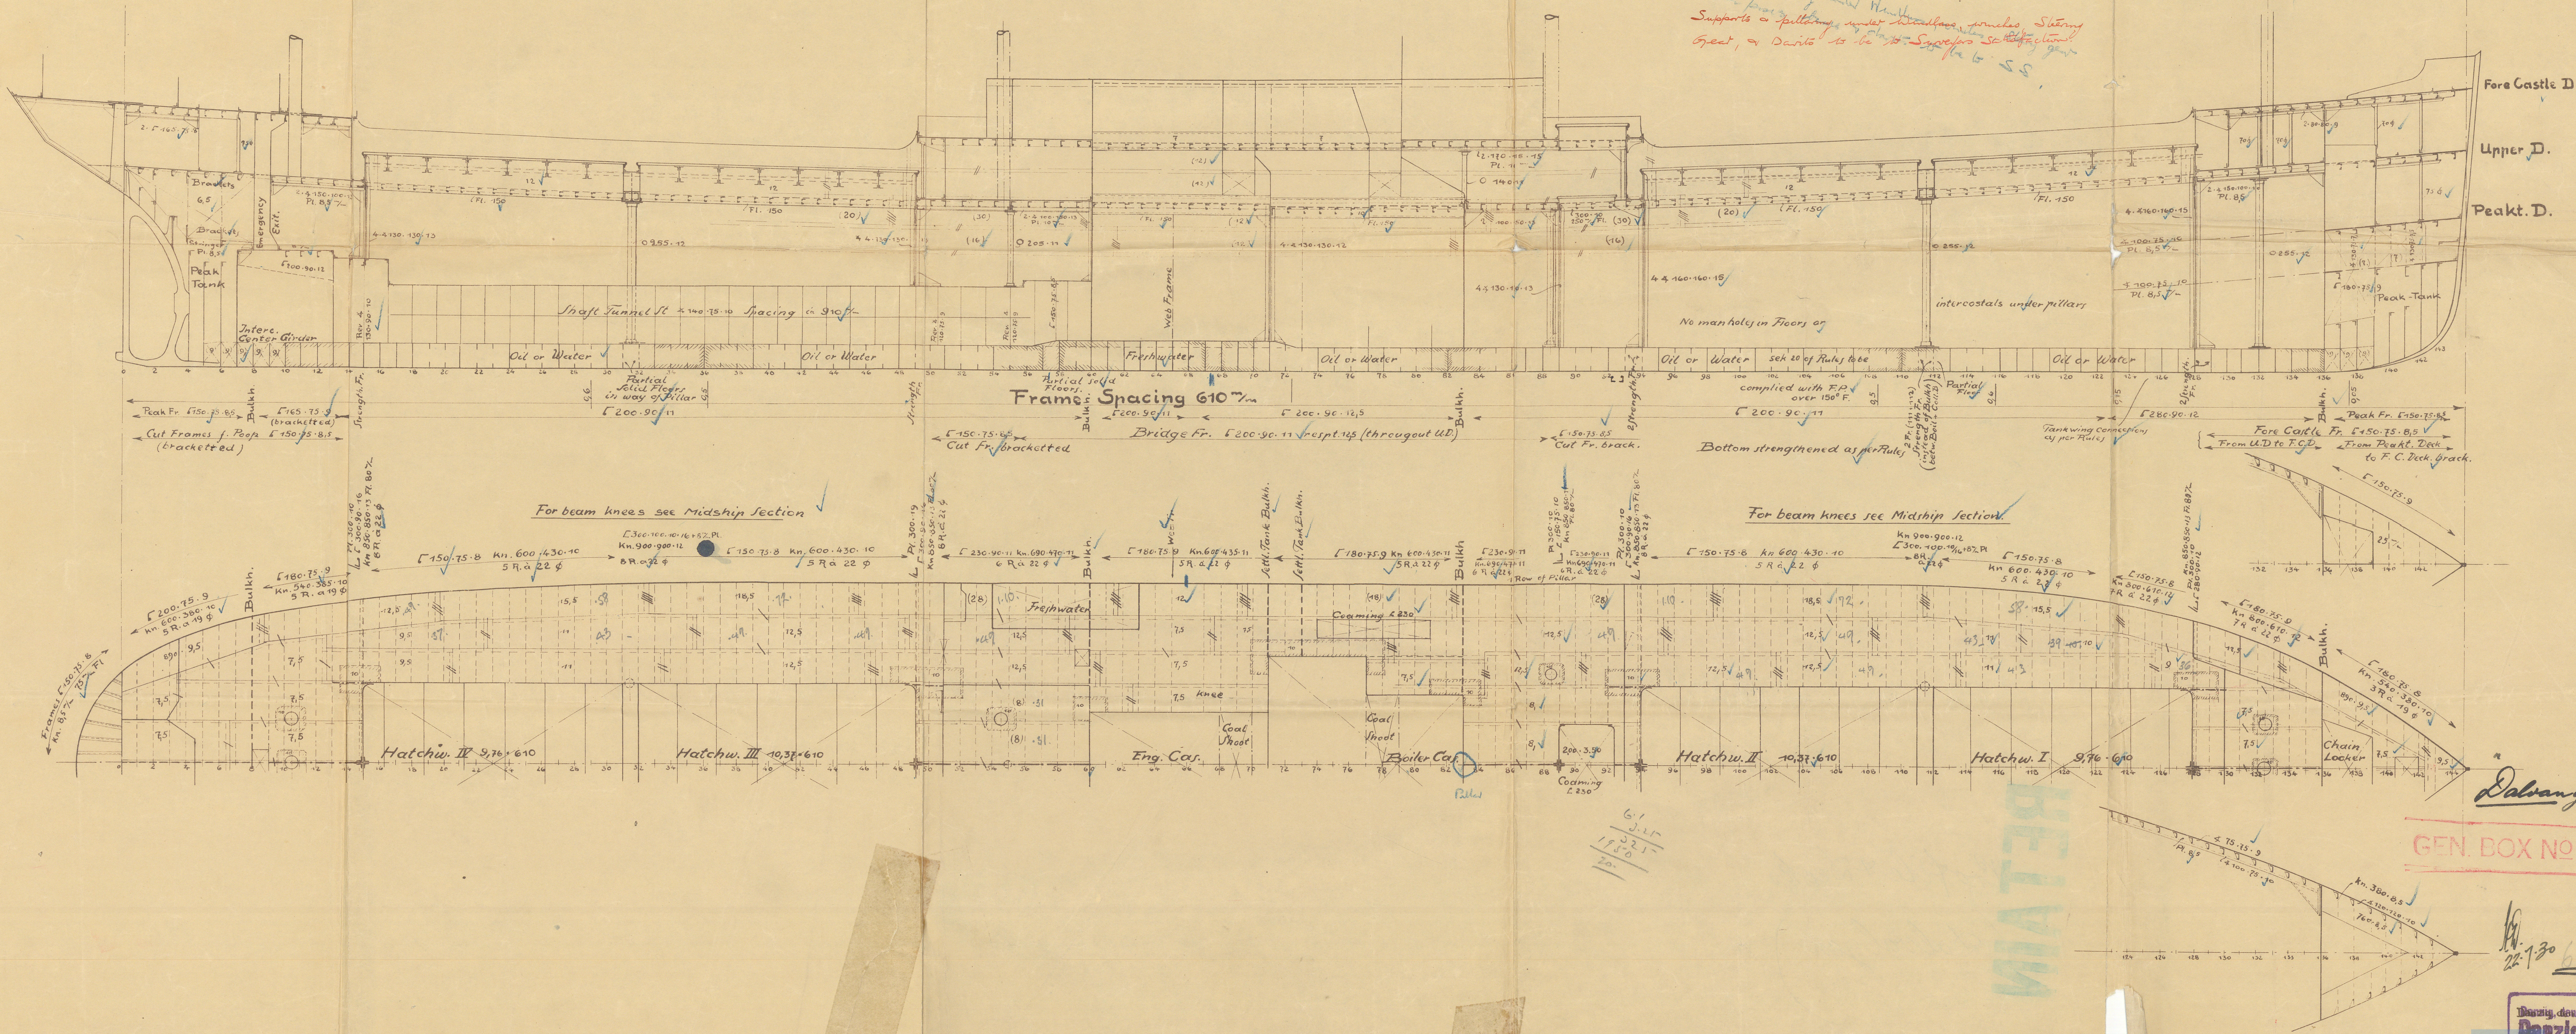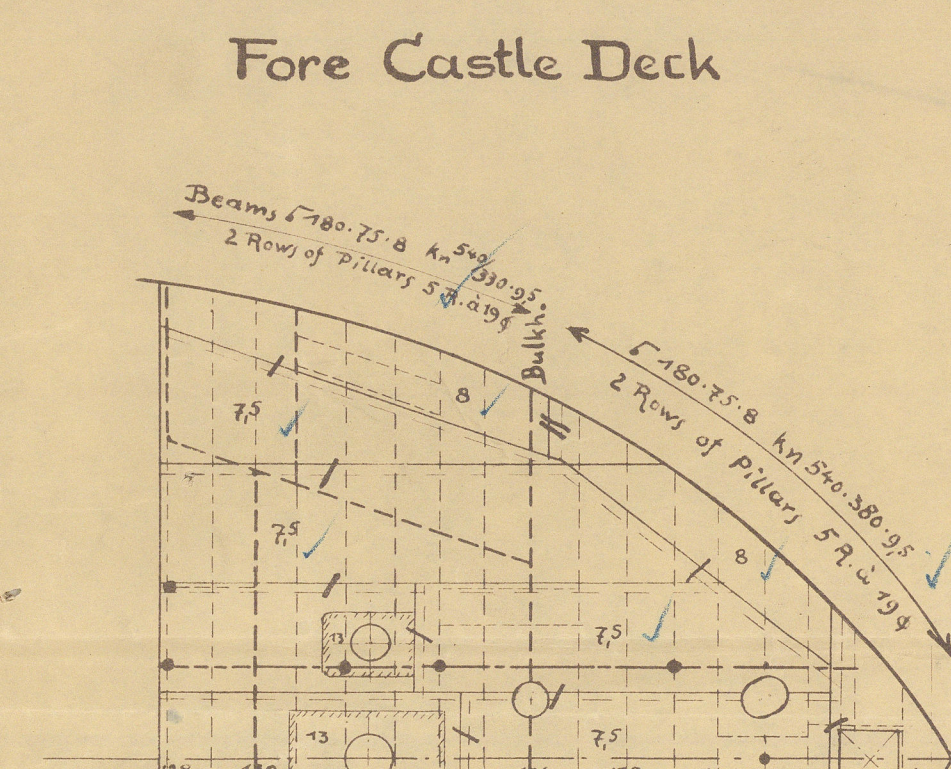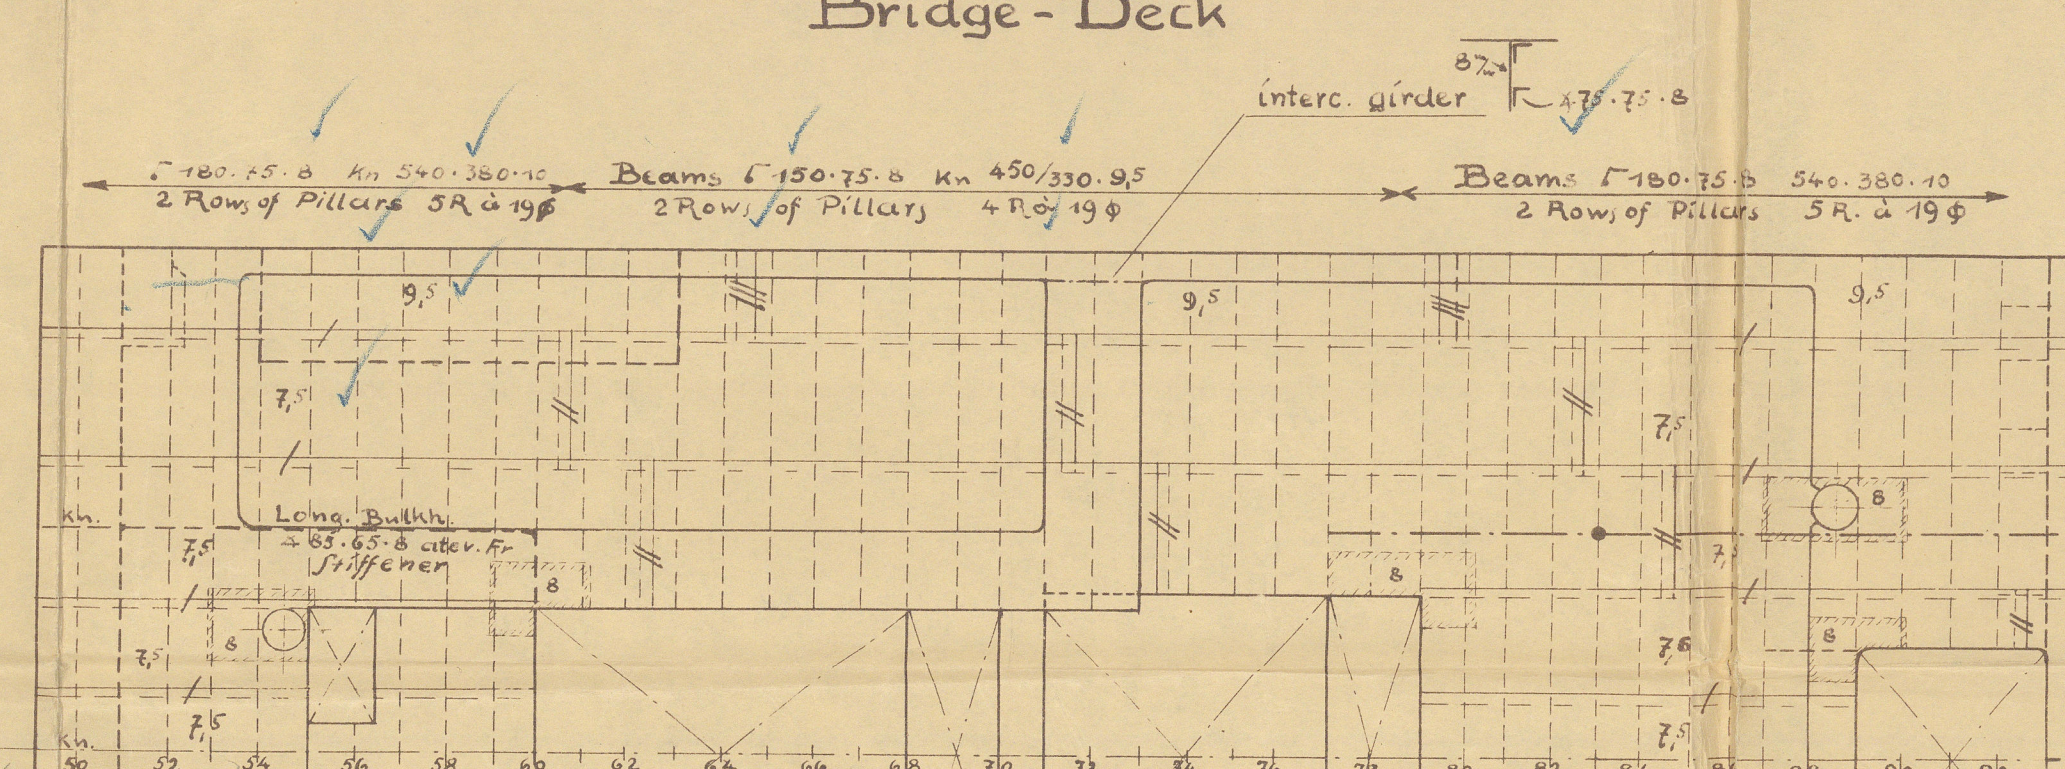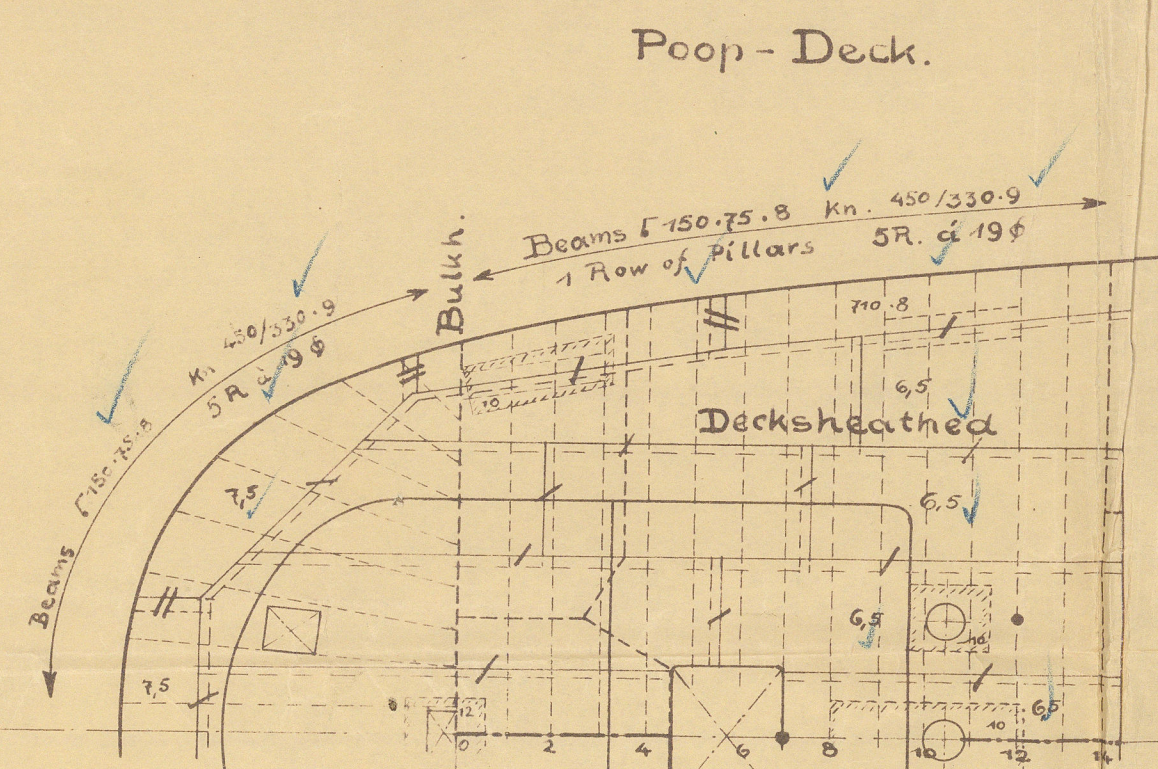

S, 65/66
Pl. 4.

Dalangen

GEN. BOX NO

22.7.30 65466

Boeing, dec 12 VII 1930
Danziger Werft
Schiffbau-Abteilung
Register
Printed

285-004291-0228

RETAIN

Profile & Decks

(Dalvalgen)

004285 - 004291 - 0228



© 2020

Lloyd's Register
Foundation