


Nº 473 S.S.

PROFILE & DECK PLANS.

SCALE 1/8" = 1 FOOT.

DIMENSIONS 400'-0" B.P. 84'-0" MOLDED 27'-8" 1/2 UPPER DECK

 

004300-004307-0088

Workman Clark

L73

Profile & dks.

Bag

T.C. 28/5/24

Workman Clark

L73

Profile & dks

Y: 3:24

Nº 6

004300-004307-0088



© 2020

Lloyd's Register
Foundation

6

And. Profile & Deck.

Workman, Clark & Co.

H 173 - H.

I.C. 28-5-2H

10-3-2H.

~~Hammilton~~ *


Imperial Valley
Buchanness.

"Skegness"

* Memphis Town *

Hammilton

RETAIN

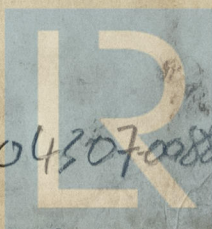

© 2020

004300-0043070088

Lloyd's Register
Foundation