

# Nº 1436<sup>6</sup>

## MIDSHIP SECTION.

DIM<sup>s</sup> 515' B.P. x 70'-0" MLD. x 37'-9" MLD.


HARLAND & WOLFF  
LIMITED  
12 JAN 1953  
Govan Shipbuilding Works  
GLASGOW

SCALE 1/2" = 1'-0"  
SCANTLINGS SUITABLE FOR A  
SUMMER DRAFT OF 30'-0 1/2"

TO CLASS 100 A.1. CARRYING PETROLEUM IN BULK  
LONGITUDINAL FRAMING AT BOTTOM & AT DECK  
SPECIAL NOTATION TO BE MADE REGARDING WELDING.  
BULB ANGLE FRAMES & DECK LONGITUDINALS ARE N.B.S.  
SCANTLINGS SHOWN APPLY TO X AND ARE TO BE INCREASED  
FOR SHEER.

L x (B + D)	515 x (70 + 36.8)	55002.20
POOP	127.5 x 8'-0" x 7.5	765.00
FORECASTLE	66' x 7.5 x 7.5	371.25
BRIDGES	38' x 7.5 x 7.5	213.75
HOUSE ON POOP DECK	117' x 8 x 50	468.00
HOUSE ON BRIDGE DECK	38' x 8 x 50	128.00
HOUSE ON UPPER BRIDGE	30' x 8 x 50	128.40
HOUSE ON NAV. BRIDGE	31.5 x 7.5 x 50	118.12
EQUIPMENT NUMERALS		57188.72

EQUIPMENT		
2 BOWER ANCHORS (STOCKLESS) EACH	95 CWTs	
1 BOWER ANCHOR (STOCKLESS) EACH	91 CWTs	
1 STREAM ANCHOR	28 CWTs	BY STOCK
330 FMS. 2 1/2" STUO LINK CHAIN CABLE OR 2 5/8" DIA. TAYCO		
120 FMS. 5/8" CIRC. STREAM WIRE 9/24		
130 FMS. 1/2" CIRC. WIRE 9/24 (TOWLINE)		
12 @ 100 FMS. HANSEK 2 3/4" 9/16		
12 @ 100 FMS. WARPS 2 3/4" 9/16		

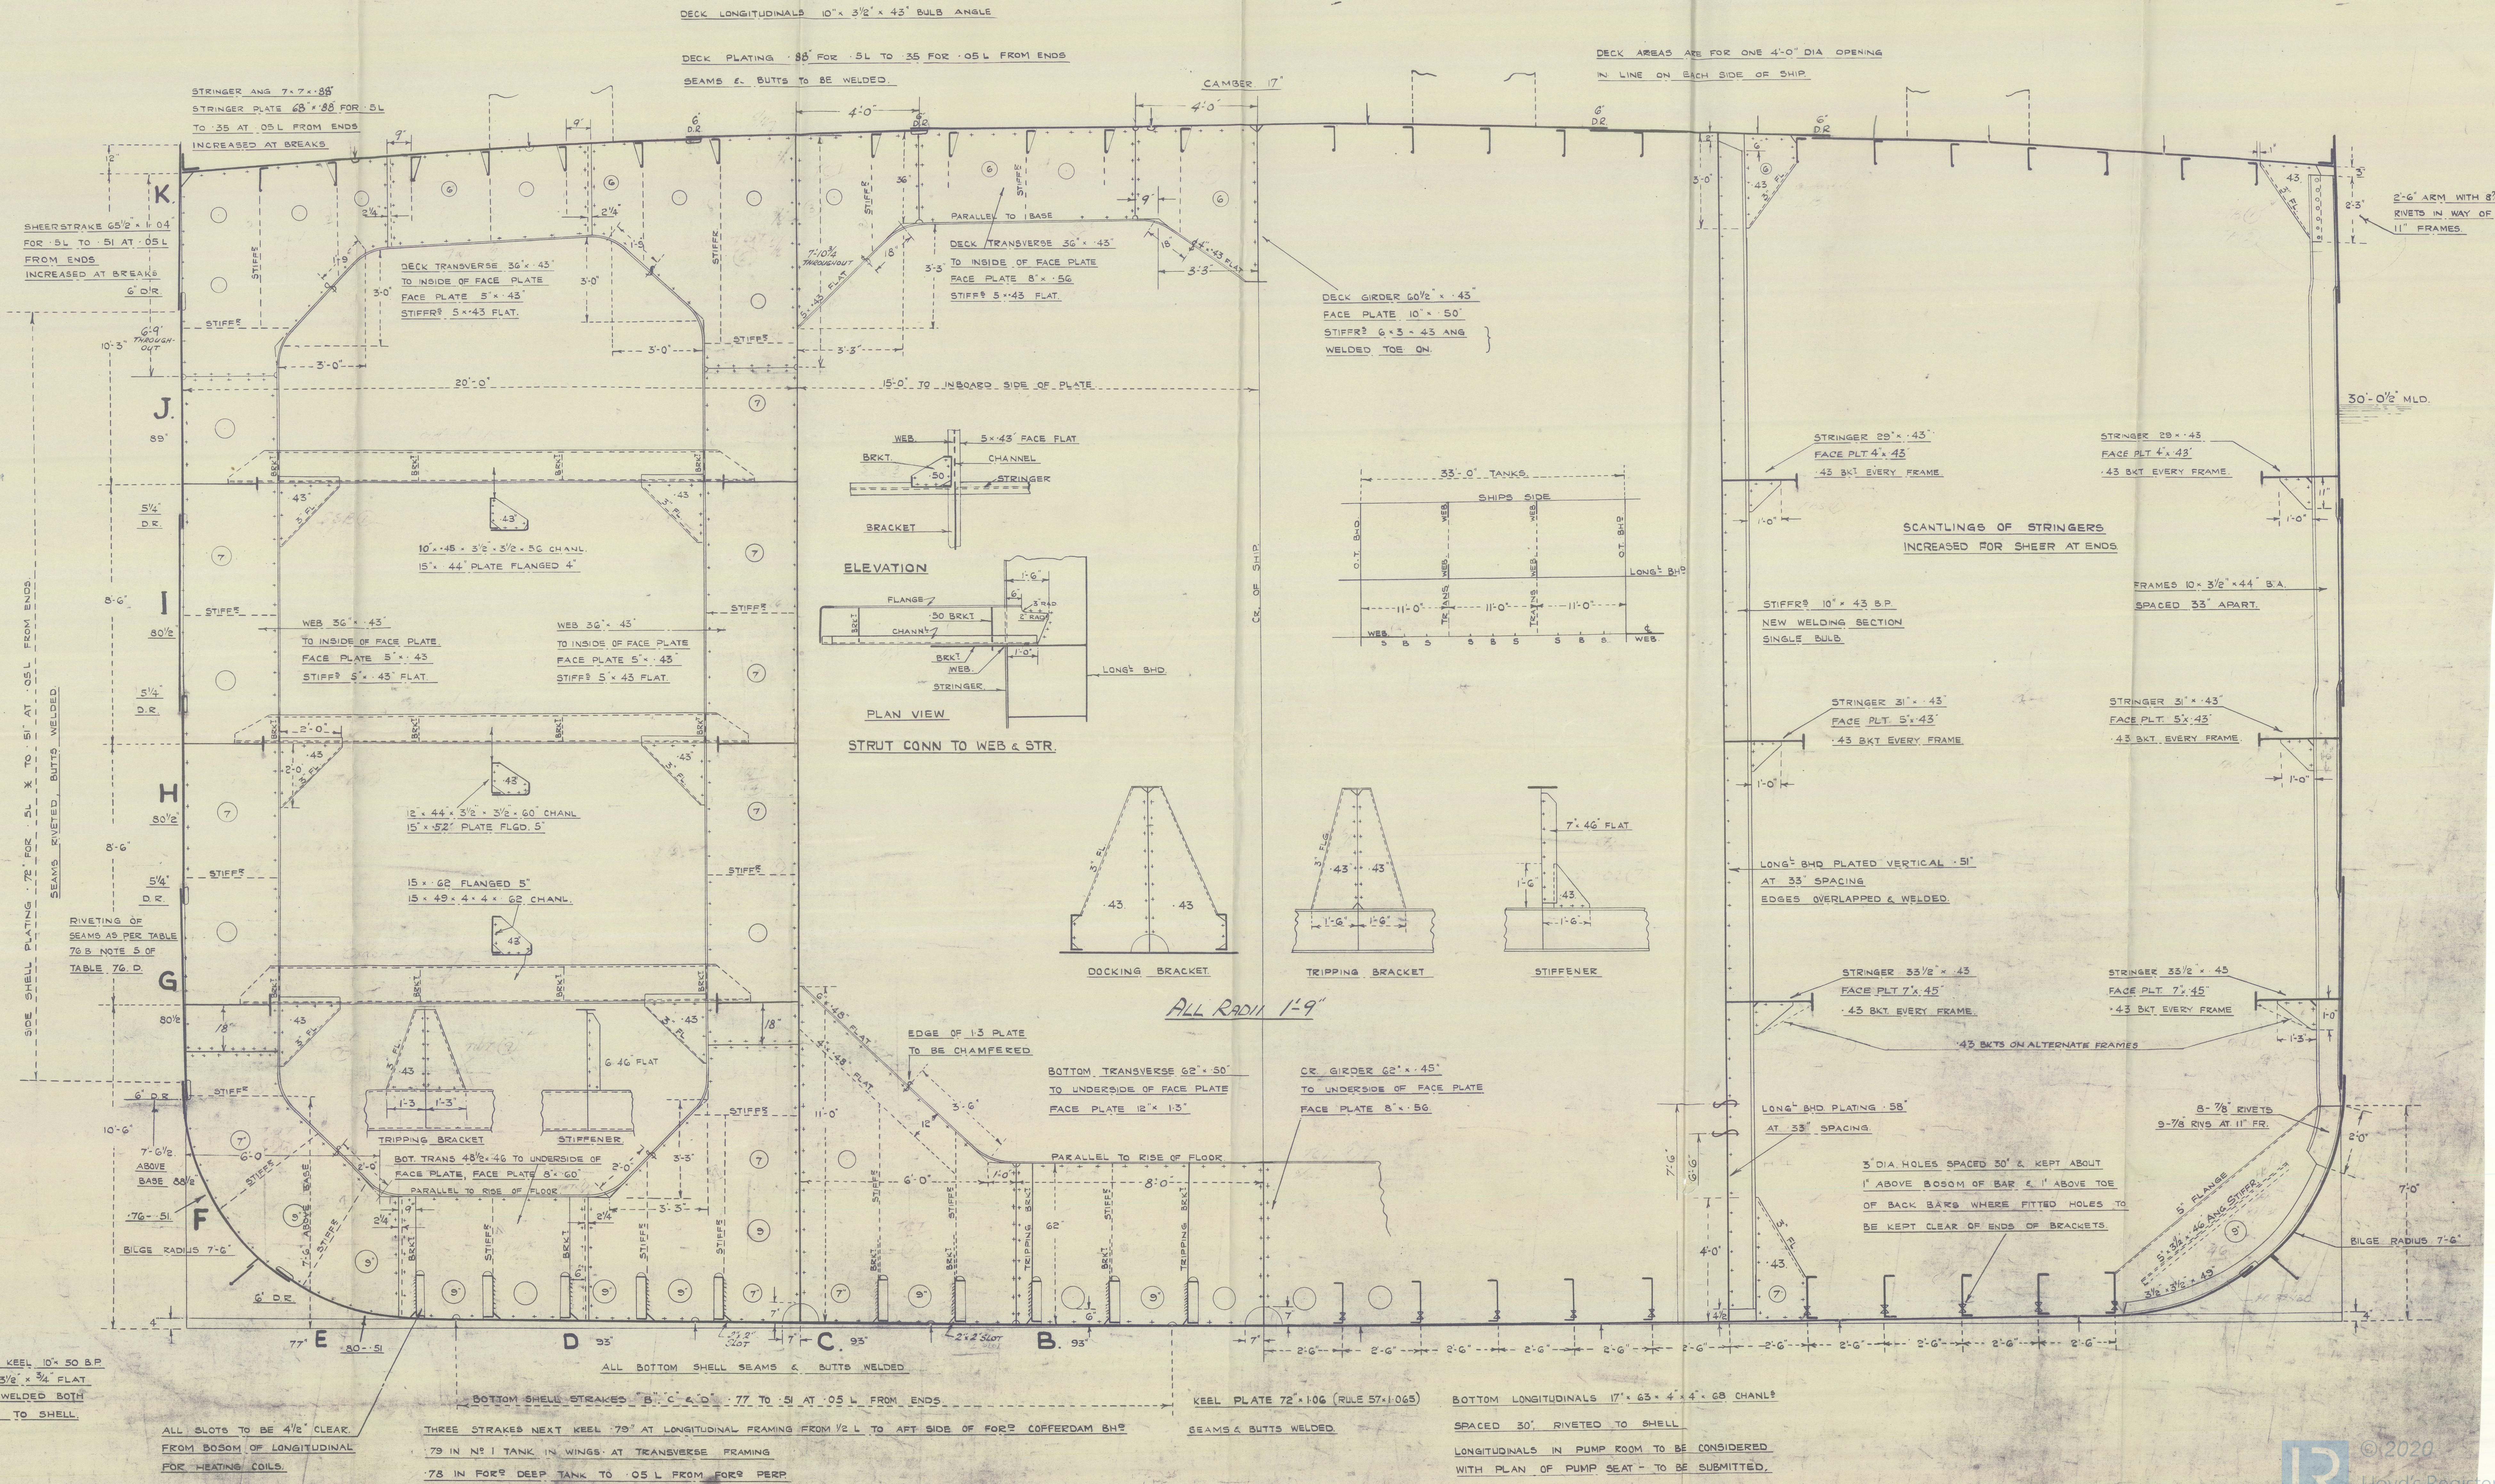



Harland & Wolff - Glasgow

Nº 11436 G

"blydefield" ★

midship section (as fitted)

GLASGOW REPORT No. 79456.

RECORDS DEPT.:  
LONDON

2

RETAIN

004308-004315-0083



© 2020

Lloyd's Register  
Foundation