

8/11/23  
(475) 1.5.22

# MIDSHIP SECTION.



DIMENSIONS: - LENGTH B.P. 245'-0", BREADTH MLD. 38'-6", DEPTH MLD. 17'-6" UPPER DK.  
SCALE 1/2" = 1 FOOT. 21'-9" RAISED QUARTER DK.

## MILLAR SYSTEM OF SHIP CONSTRUCTION (PATD). LTD.

LLOYD'S NUMERALS  
D = 17.50  
FIRST LONGITUDINAL NO.  
L x D = 4288  
SECOND LONGITUDINAL NO.  
L x (B+D) = 13720  
L/D (UPPER DK) = 14.00  
" (RAISED Q.R. DK) = 11.26  
"d" (UPPER DK) = 14.3  
" (RAISED Q.R. DK) = 18.55


FURNESS SHIPBUILDING Co. Nos. 59 & 60.  
TO CLASS 100 A1 LLOYD'S.  
EQUIPMENT AS PER RULE

RUDDER POST 6" x 5 1/4"  
PROPELLER POST 6 3/4" x 5 1/4"  
STEM BAR 7" x 1 1/8"

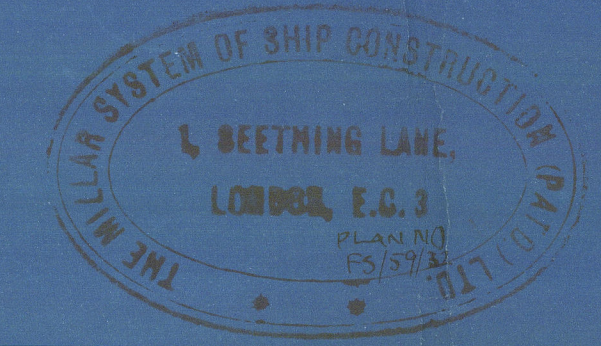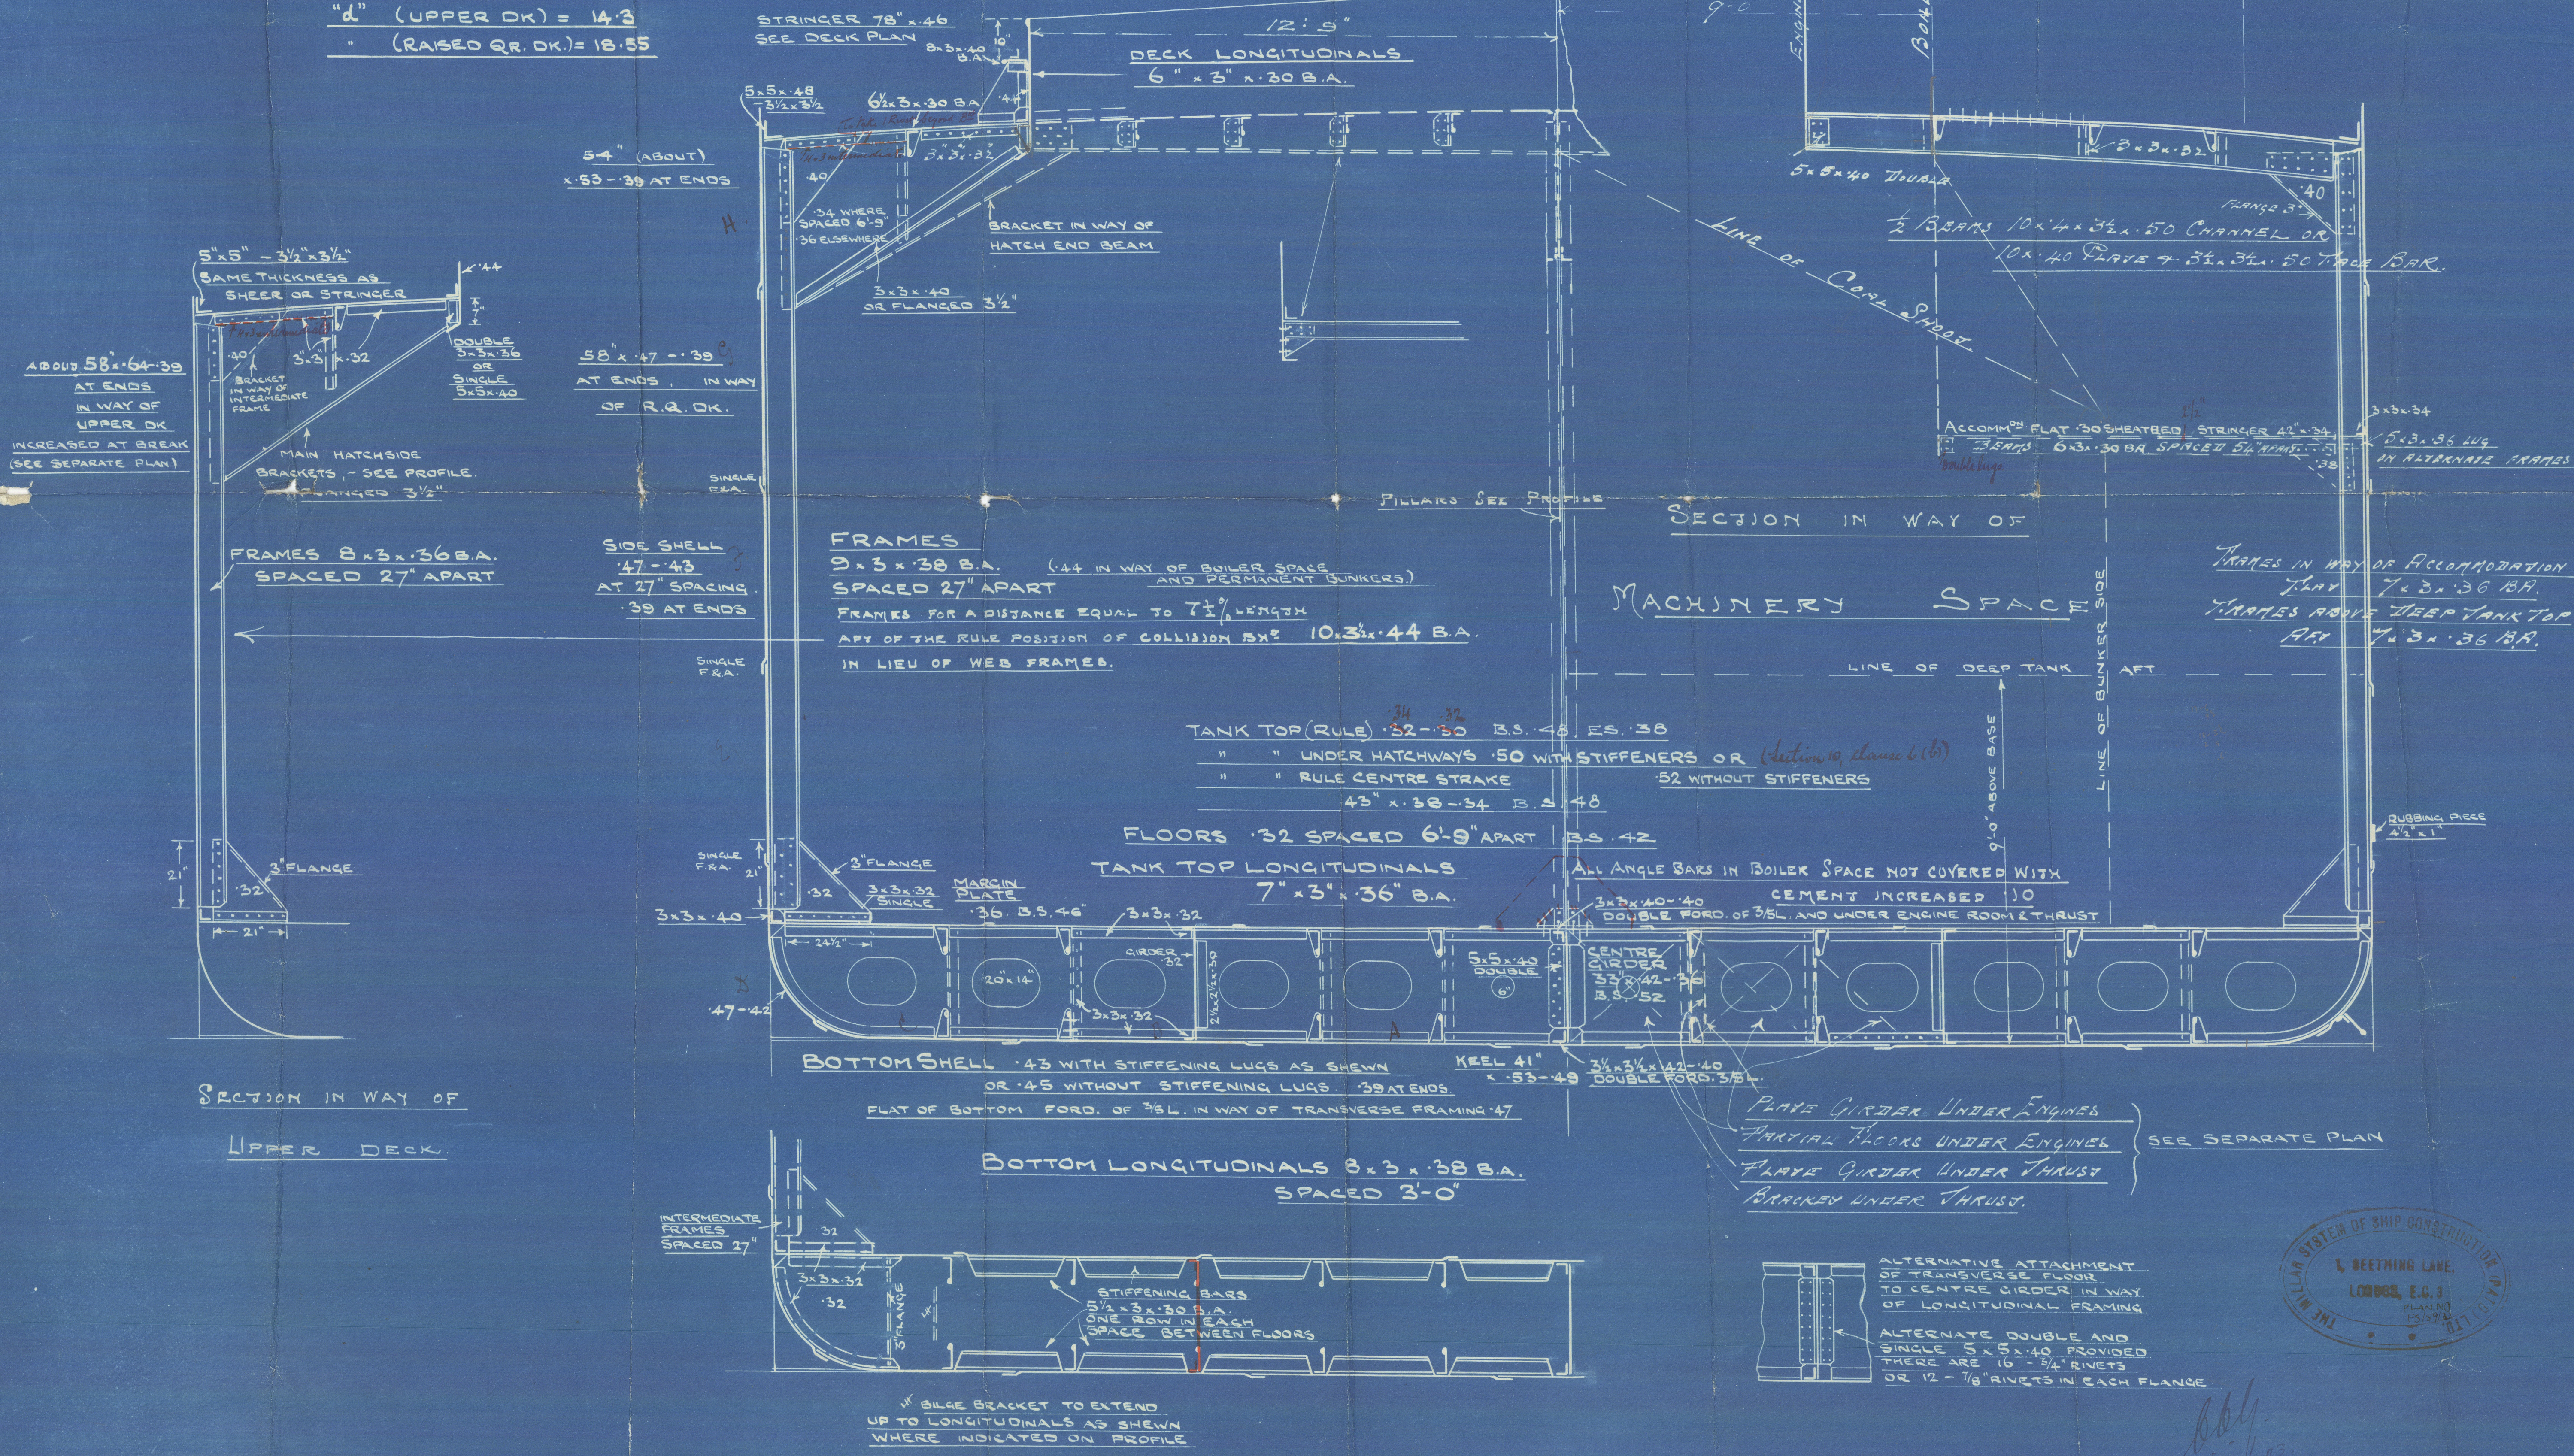



59/60

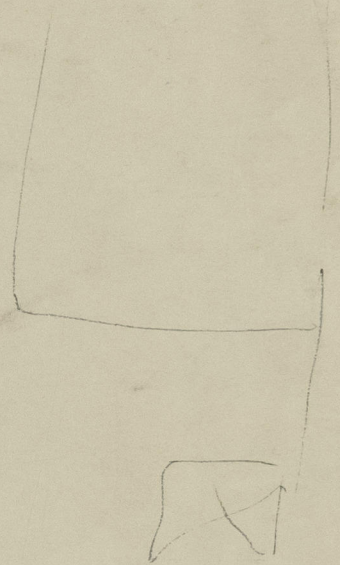

*From Dubro*



© 2020

Lloyd's Register  
Foundation



59/60 + 74/5-

Summen nos 59/60

Miss life Section

Sud

S.S. <sup>ex</sup> Martinhoe (No. 59.)  
MDB. RPT. No. 11910

11.0  
2.7

S.S. <sup>W</sup> Lamberthaus (No. 60)  
MDB. RPT. No. 11939

S.S. John Harrison (No. 46)  
MDB. RPT. No. 12128

5-1