


17/11/37.

? Height of overflow to
Fore Peak Tank.

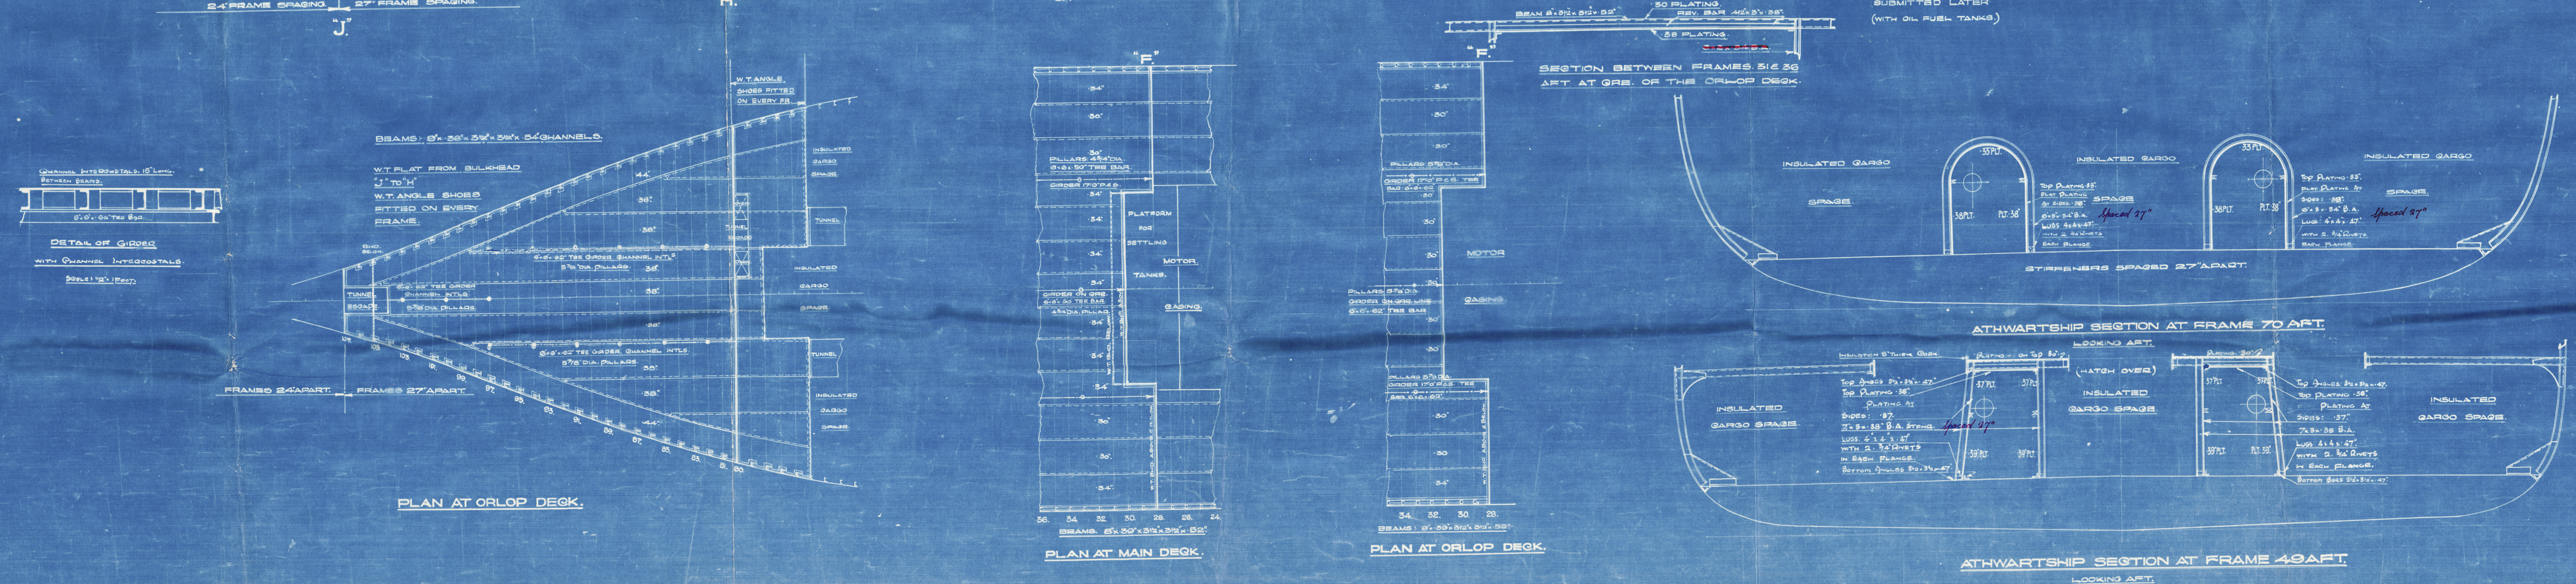

Nº 751, & 806. 813_G.
LONGITUDINAL ELEVATION.

SCALE : 1/8" = 1 FOOT.
SECTIONS : 1/4" = 1 FOOT.
LENGTH : 520'-0", BREADTH : 69'-0", DEPTH : 35'-9" MLD

NOTES :

PLATING IN WAY OF W.T DOORS INCREASED 4L;
STIFFENING IN WAY OF W.T DOORS TO BE CONSIDERED;
WEBS GENERALLY, FITTED AT SIDES, SAME DEPTH
AS STIFFENER AT TOP OF DOOR, AND SAME DEPTH
AS BRACKET AT BOTTOM OF DOOR. SURFLANGE ON FACE
STIFFENERS AT SIDES OF W.T DOORS, INCREASED AND
BRACKETED.

signed
R. G. L.
28.9.27

Messrs Harland & Wolff Ltd.

No 813C

Longitudinal Elevation

No 15

"Highland Hope"

GLASGOW REPORT No 48900

H.W. 751 etc

App Profile

004321-004325-0250



© 2020

Lloyd's Register
Foundation