

# MIDSHIP SECTION. N<sup>o</sup> 25. 813G.

DIMENSIONS 520'x69'x43-9' MLD. TO SHELTER DECK.


SCALE: 1/2" = ONE FOOT.

TO OBTAIN LLOYD'S CLASS + 100 A.I. (WITH FREEBOARD).  
28'-0" DRAFT MLD.

CAMBER OF ALL DECKS 6" IN 69 FEET.

*for hull*  
 $D = 28' - 0" \times 43' - 9" = 41' - 83"$   
 $L \times D = 520' \times 41' - 83" = 21752'$   
 $L \times (B+D) = 520' \times (69' + 41' - 83") = 57632'$   
 $W/D = 28' - 0" / 43' - 9" = 11.89'$  TO SHELTER DECK.  
 $W/D = 520' / 43' - 9" = 9.98'$  TO BRIDGE DECK.  
 DEPTH  $d = 8' - 3"$

*Support of Braces above hatchways  
on lower portion*

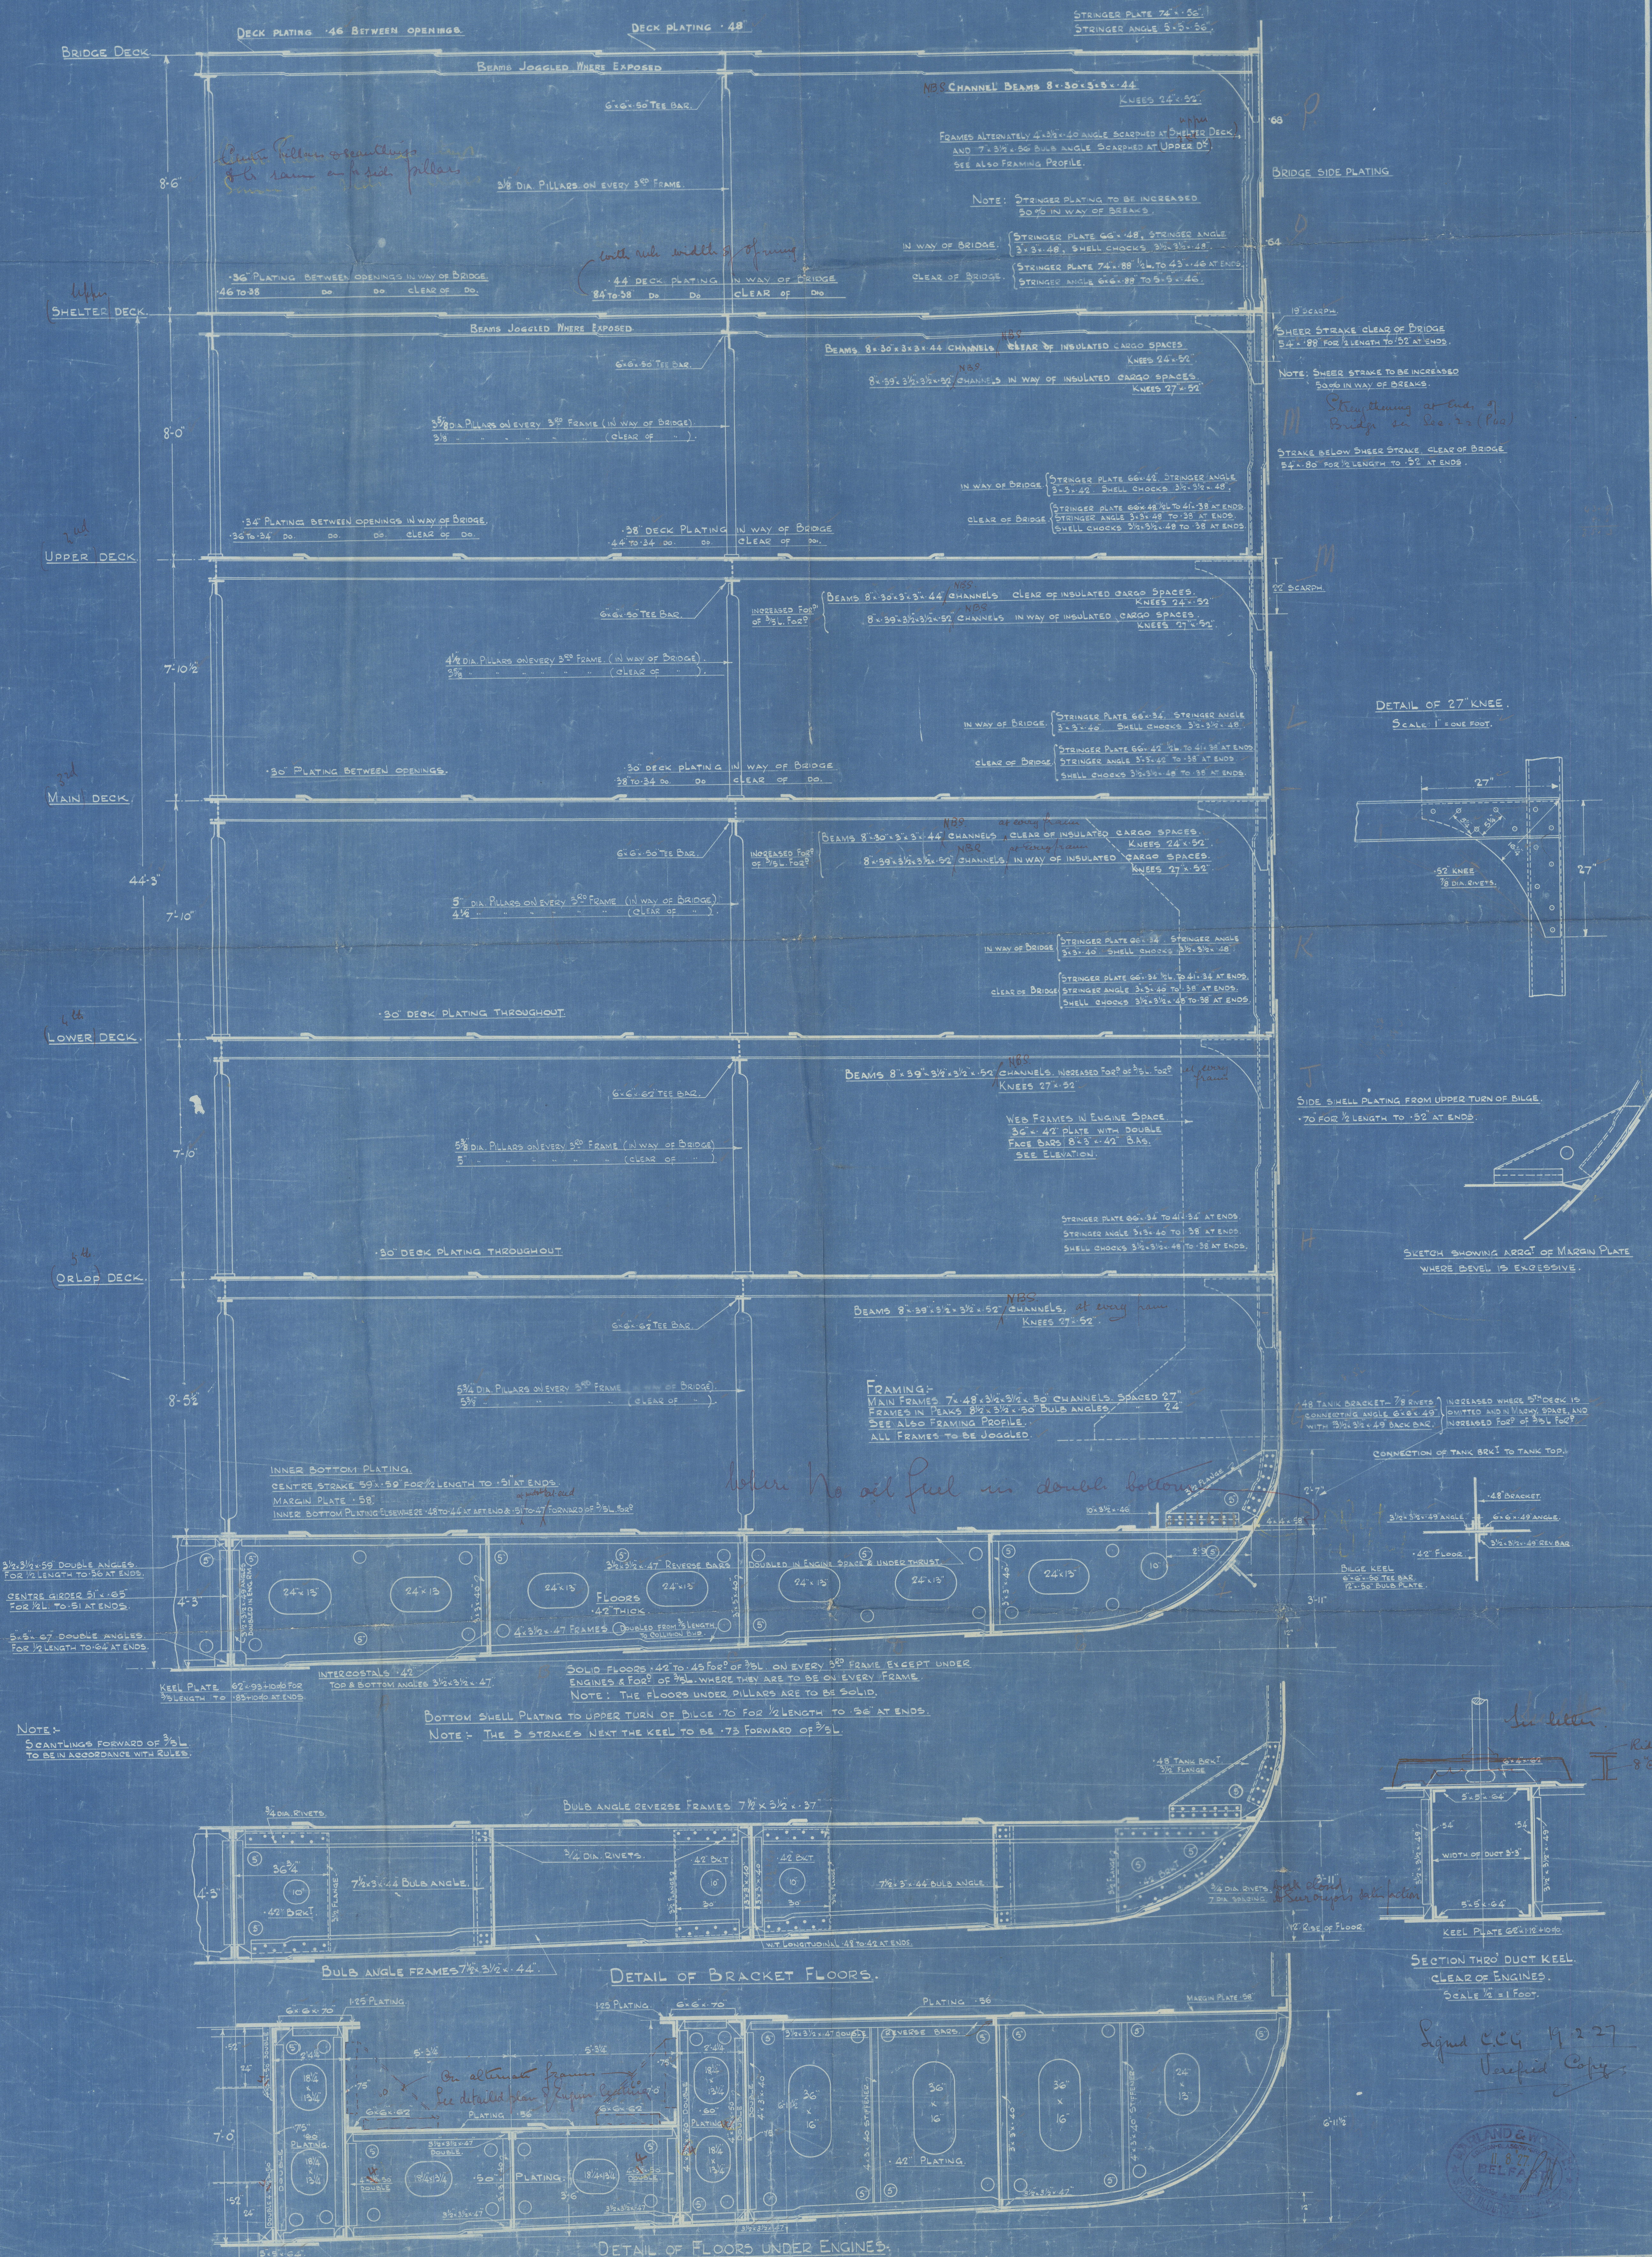

Signed C.C.G. 11.2.27  
 Verified Copy





Messrs Harland & Wolff Ltd  
N<sup>o</sup> 813 G  
Midship Section

N<sup>o</sup> 1

"Highland Hope"


GLASGOW REPORT No. 48900

①

813 G

Midship Section

004321-004325-0257

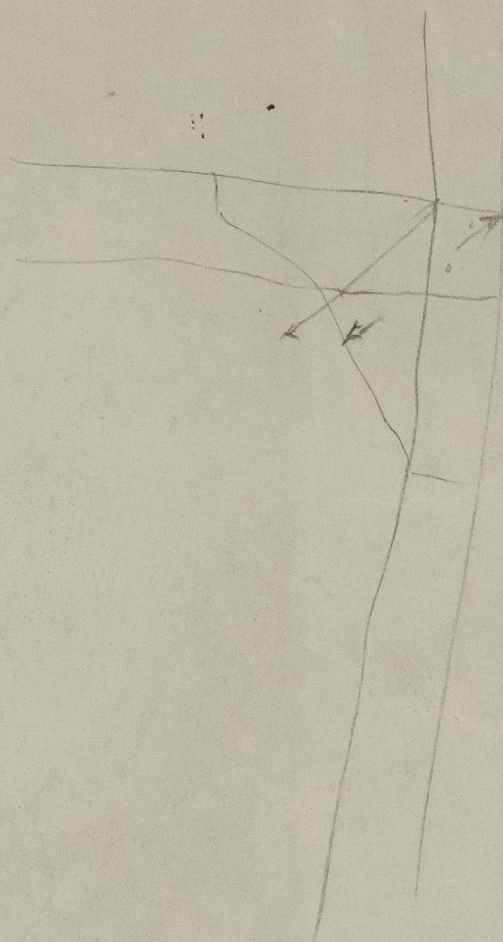

© 2020

Lloyd's Register  
Foundation