

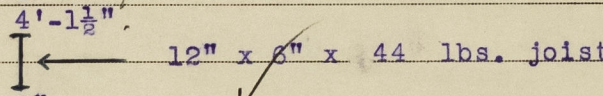
*HENRIETTA*  
*EX*  
**Lloyd's Register of Shipping.**

Ship's Name "HIGHLAND BRIGADE"

Official No. 148164

Memorandum of alterations reported since ship was surveyed for assignment of Load Lines in

New Hatchway to No. 2 Hold Built on Forecastle Deck Extension.

Description of Hatchway	No. 2
Dimensions of Hatchway	22'-6" x 16'-0"
Coamings	( Ht. above Deck 24" ( Thickness ( sides .44" ( ends .44" ( Stiffeners 7" x 3" x .38" BAS ( Brackets, stays 2 @ 1½" solid round stays each side.
Hatch Beams	( Number 5 ( Spacing 4'-1½" ( Scantling & Sketch  ( Bearing surface 3"
Fore and afters	None
Hatch Covers	( Material W.P. ( Thickness 3" ( How Fitted F & A ( Bearing surface 3"
Spacing of cleats	22" to 24"
Number of tarpaulins	3

Battens, wedges and tarpaulins have been supplied and are in good condition,  
and in accordance with Rule requirements. ✓  
Lashings are provided in accordance with Rule requirements. ✓

*T. R. McIlvenna*  
Surveyor to Lloyd's Register of Shipping.

LONDON.

January, 1948.

*Noted  
A.R.  
20.1.48*