

<u>EQUIPMENT</u>		8/20
QR. DECK	64 x 3.5	227
F/CLE	26.5 x 7 x .75	139
CARPING	59.5 x 7 x .50	208
		6894

No 141
OIL TANK STEAMER
MIDSHIP SECTION

DIMENS 160' x 26' x 12'-3" MLD
Scale 1/2" = 1'-0"


TO CLASS 100.A.I. AT LLOYDS
CARRYING PETROLEUM IN BULK.

OUTFIT

2 BOWER ANCHORS	10 1/4 CWT. TP STOCKLETON.
1 " "	8 3/4 " "
1 STREAM ANCHOR	3 1/2 " EX-STOCK.
1 KEDGE "	1 1/2 " " "
185 FATHOMS	1 1/8" STUD LINK CABLE.
60 "	2 3/4" STEEL WIRE ROPE.
75 "	2 1/2" " " "
90 "	5 1/2" MANILLA.

RIVETING

SEE SEPARATE SHEET.

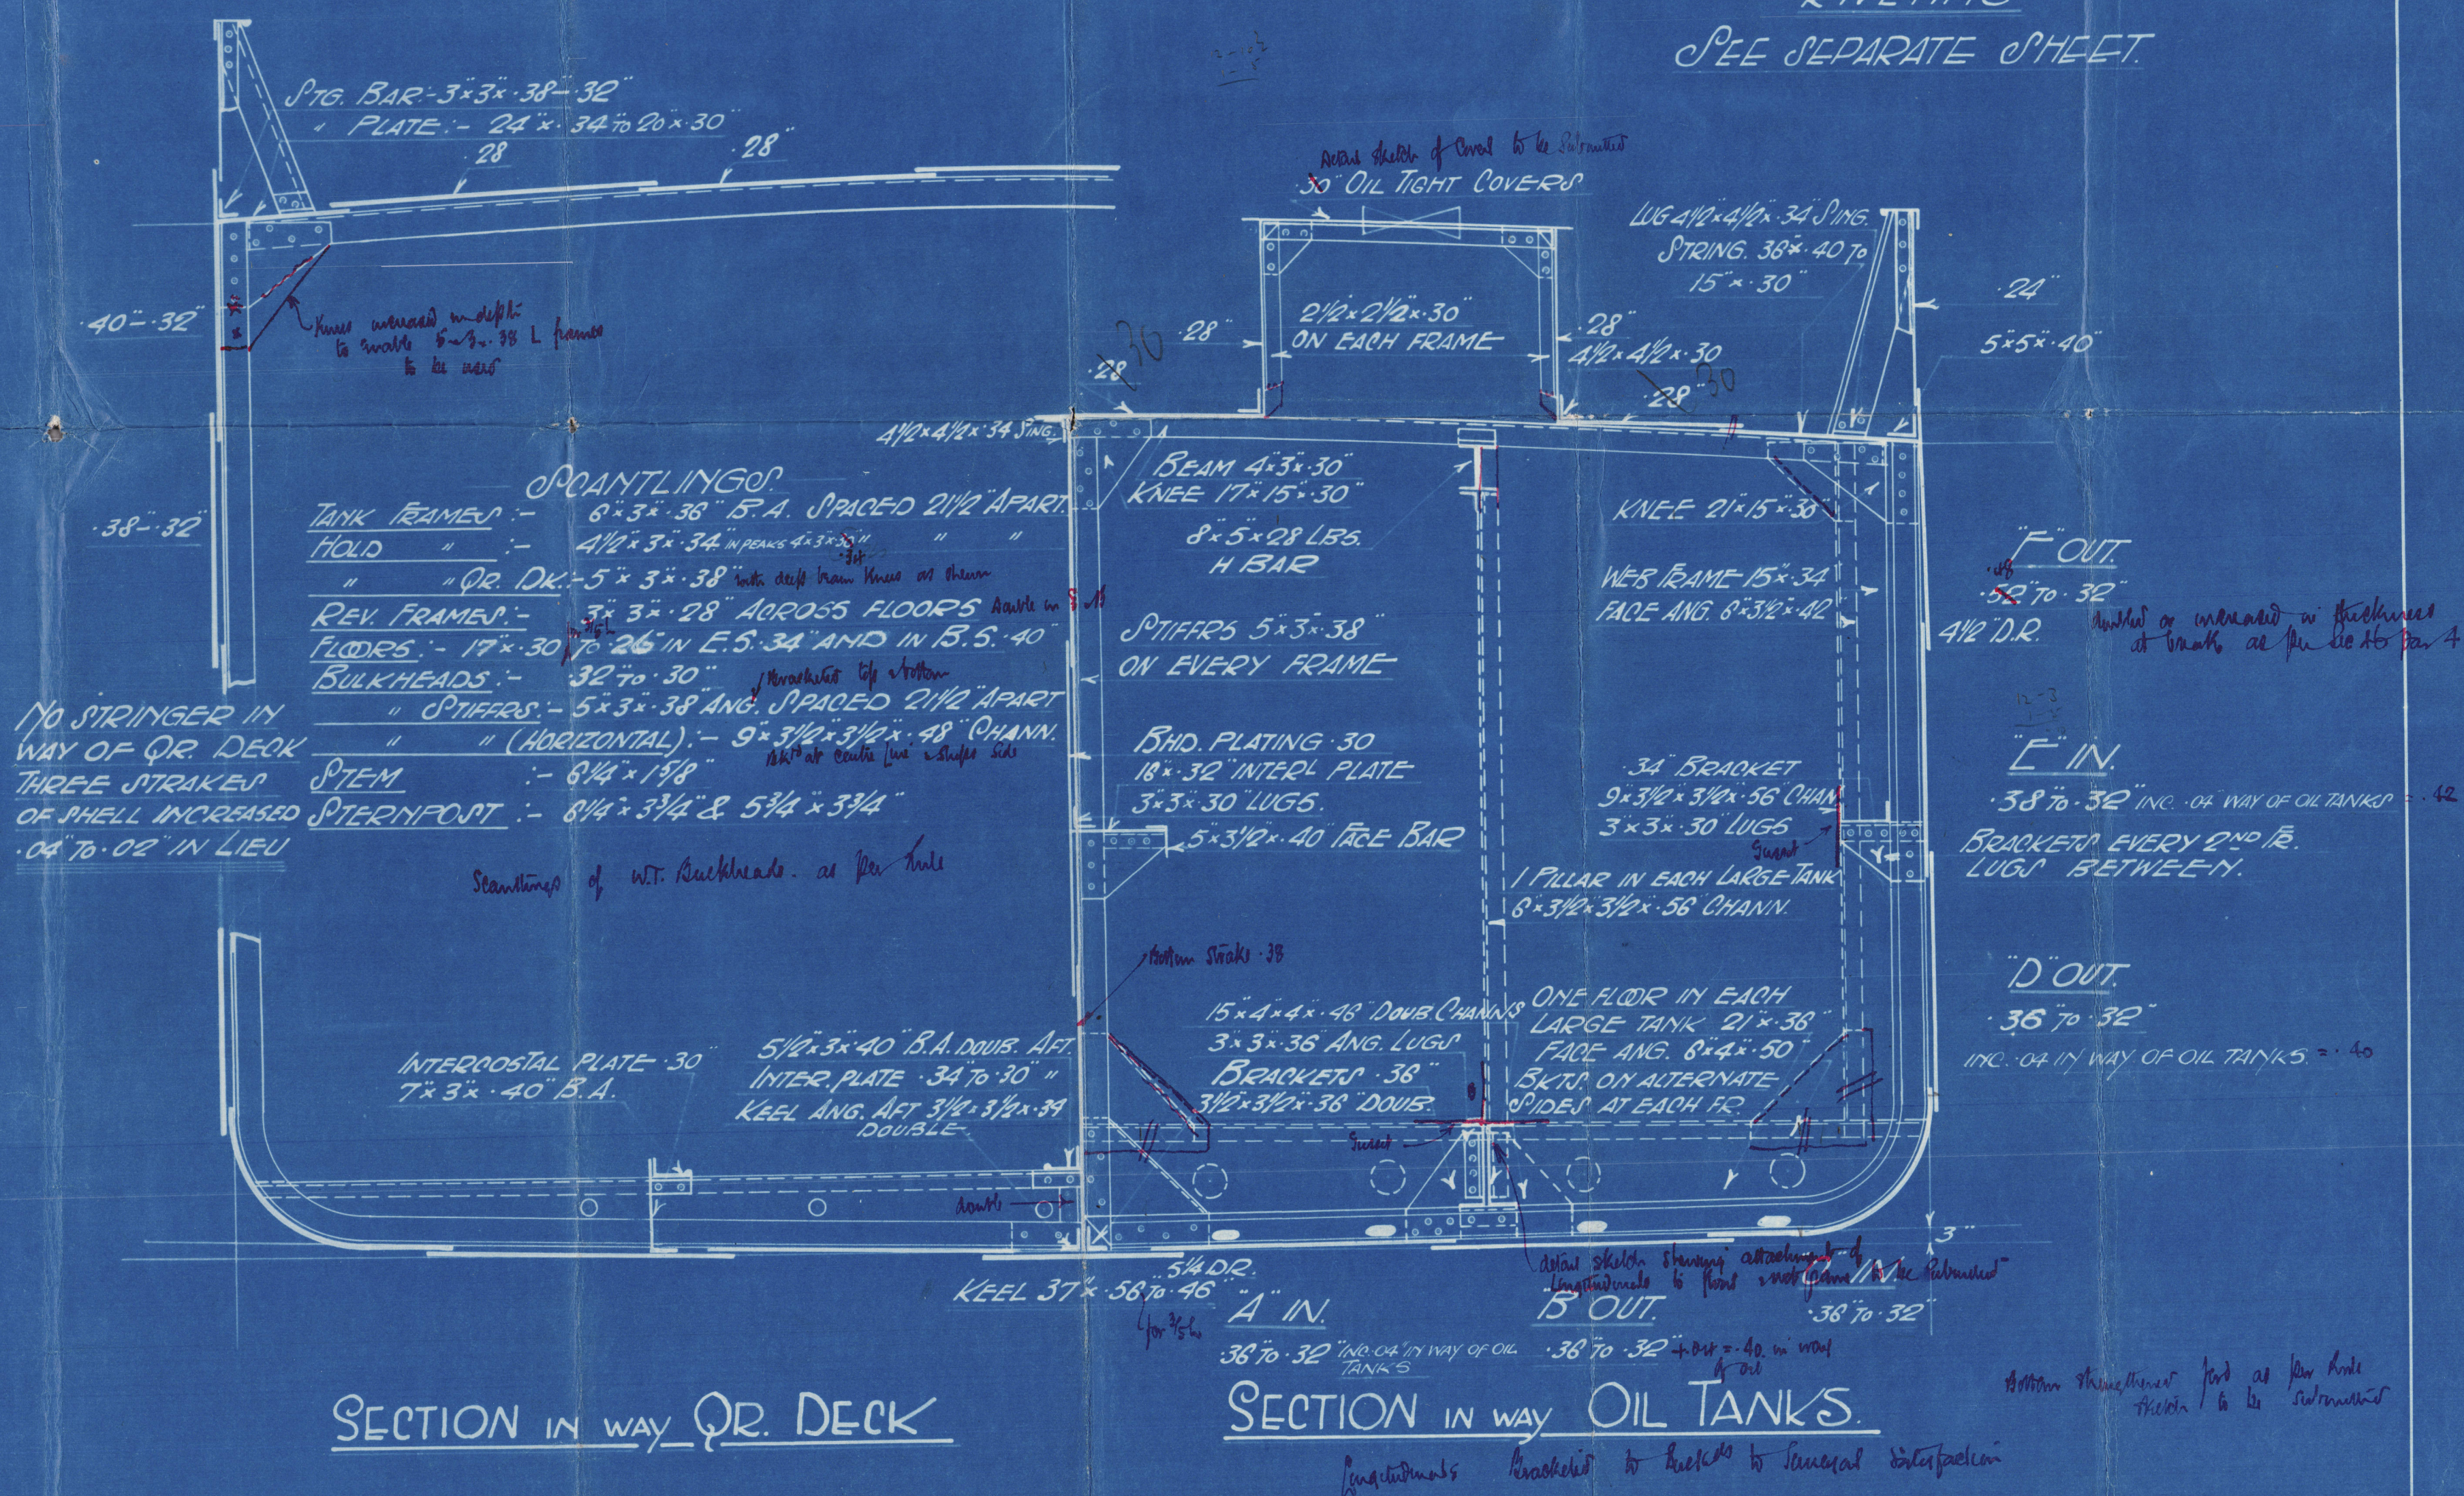

Messrs Geo Brown & Co

S. S. "AGILITY"

No. 141.

Friendship Section

Gr R Regd No. 18210.

004332 - 004337 - 0142



© 2020

Lloyd's Register
Foundation