

10.3.22
N^{os} 1589-90.

— PROFILE & DECK PLANS— PADDLE FERRY STEAMER

DIMENSIONS :- 171'-6" x 44'-0" x 7'-6" MLD:


SCALE $\frac{1}{8}$ " = 1 FOOT

TO CLASS LLOYDS AI FOR WOOLWICH FERRY PURPOSES.

MODIFIED IN BLUE AS BUILT.

NOTE :- POSITION OF BULKHEADS SUBJECT TO 8 OF T
REQUIREMENTS FOR SUBDIVISION

BULKHEADS FITTED AT NOS 8, 17, 33, 48, 64, 73, 78.

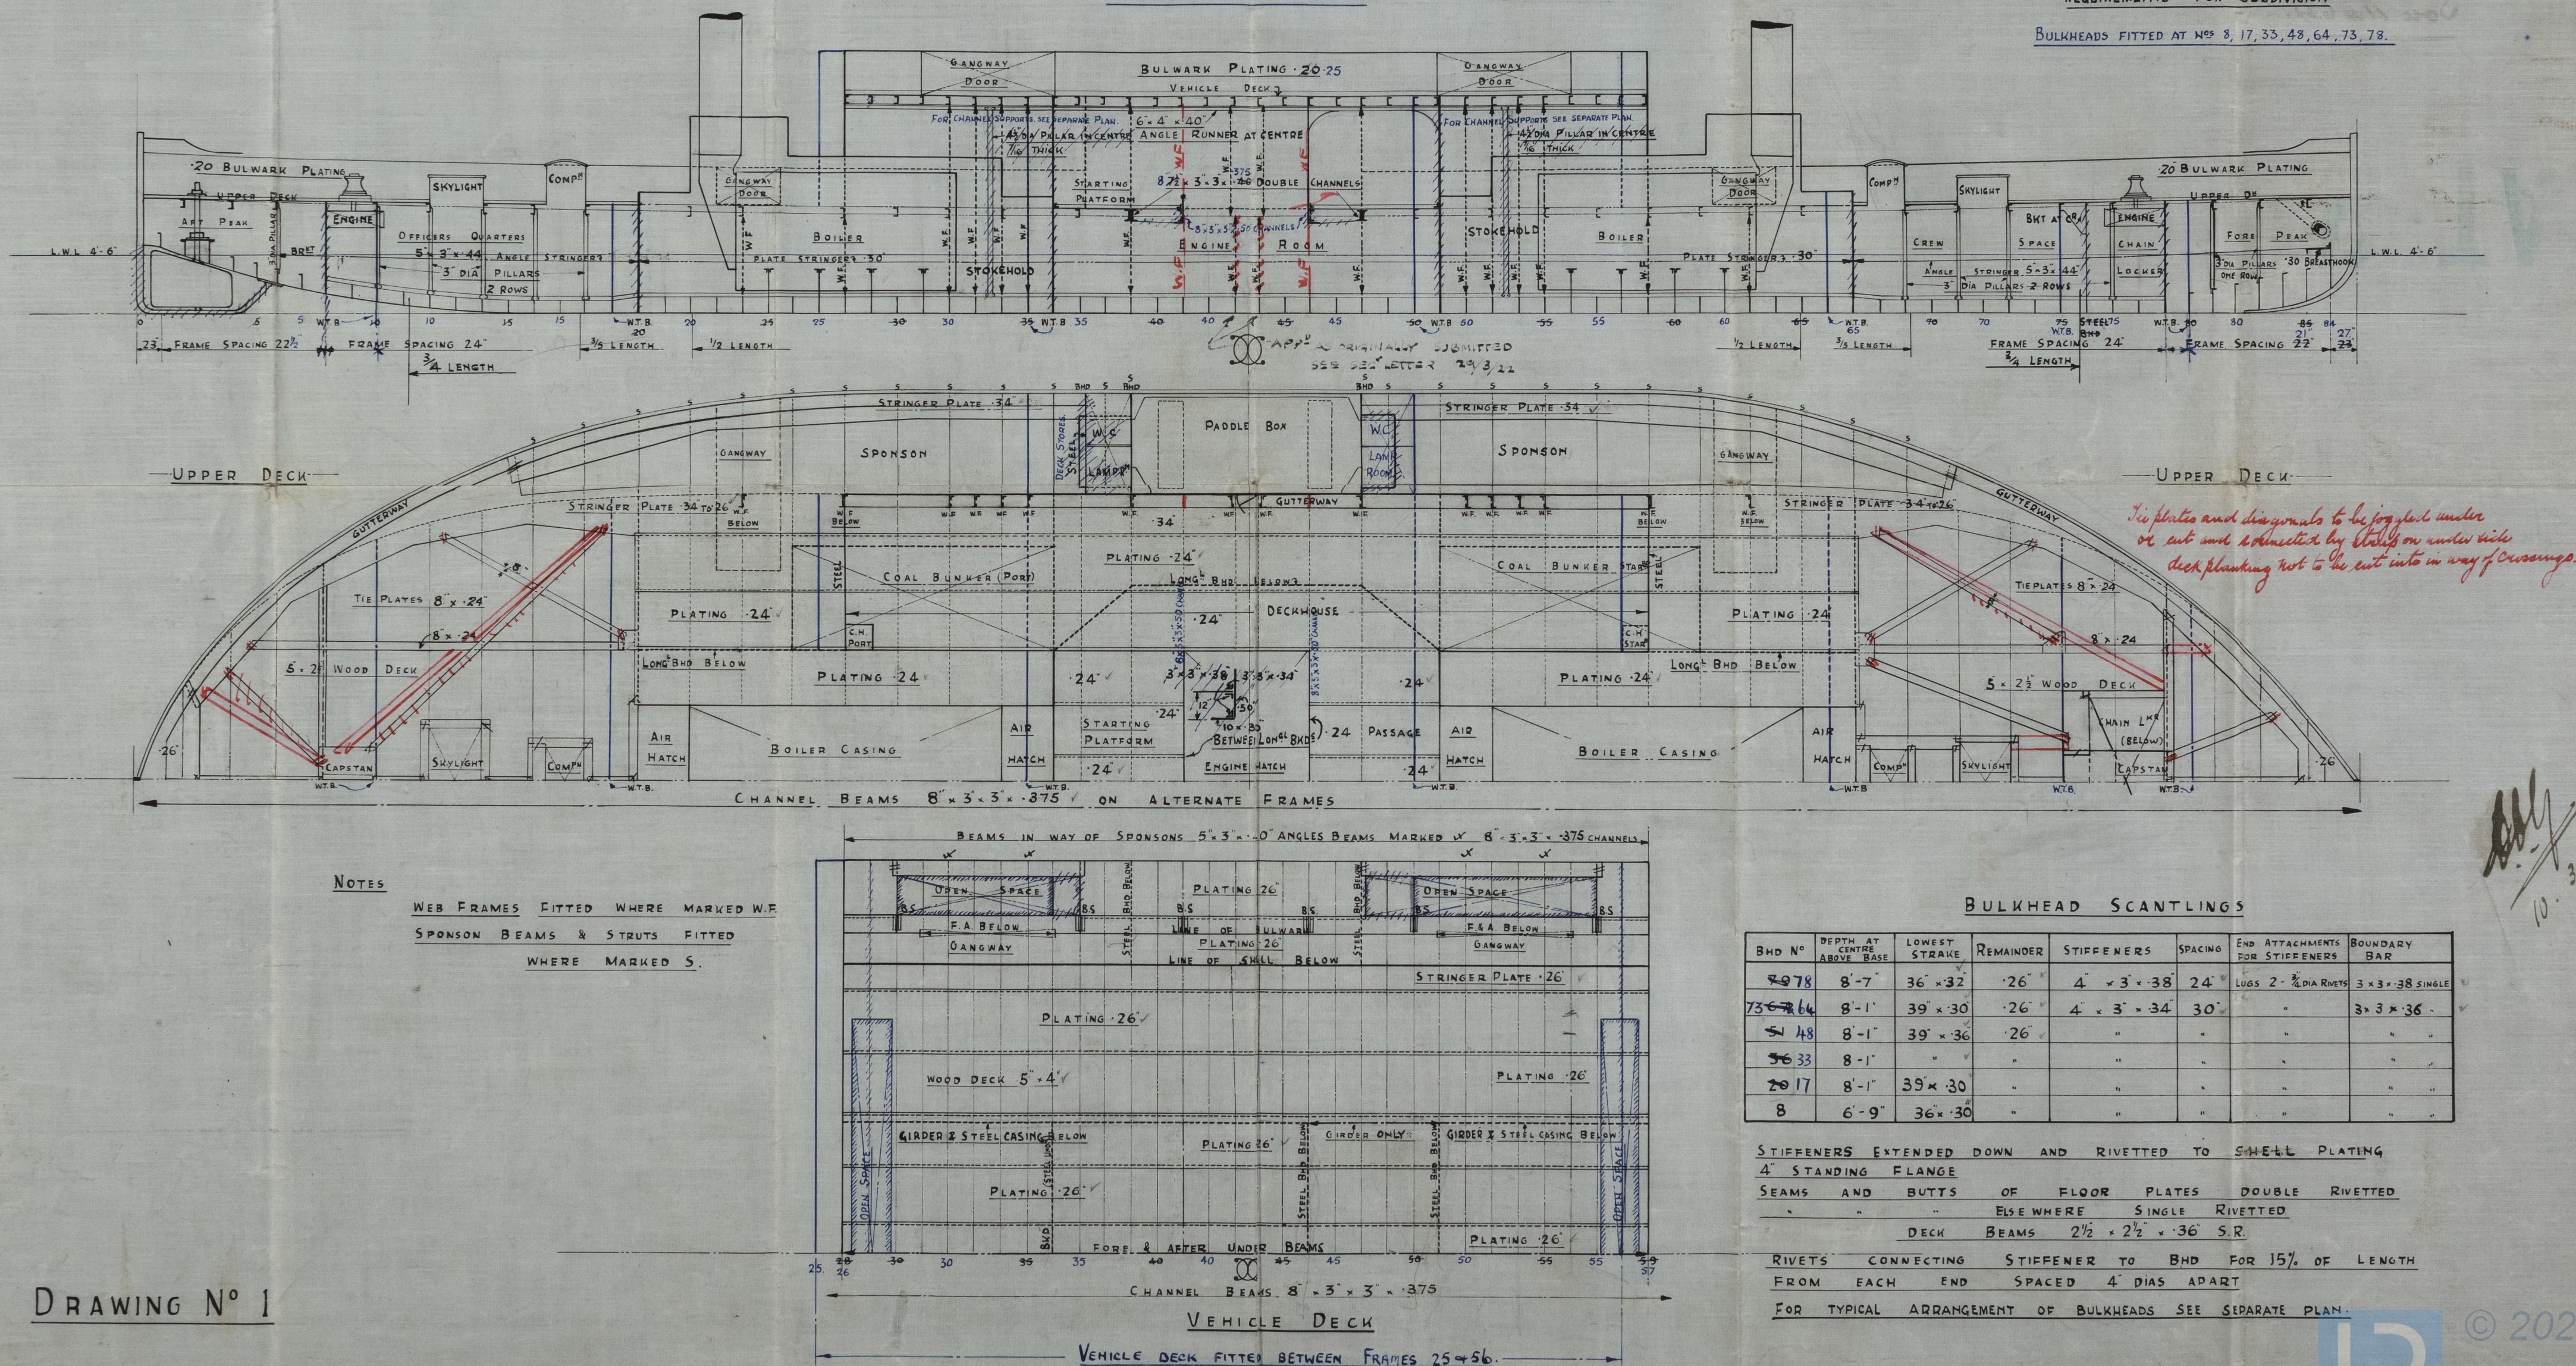

DRAWING N^o 1

Mass. J. S. White Co. So
Bowers.

Profile Deck Plan

Jan N^o 1589-90.

* S/S Squires

So 11433

S/S "Gordon"

So 11464



© 2020

Lloyd's Register
Foundation

004338-004350-0087