

LLOYD'S REGISTER OF SHIPPING

UNITED WITH THE BRITISH CORPORATION REGISTER

ALTERATIONS TO CONDITIONS OF ASSIGNMENT OF LOADLINES

Ship's Name " E D D Y B A Y "


Official No. 184616

Port of Registry London

This ship has been under survey at Plymouth

on 14th August, 1958, and the following alterations to the conditions of assignment of loadlines have now been ~~effected~~/found:—

The Opening into the fo'castle is now closed by a steel plate secured by 22 in No. $\frac{3}{4}$ " diameter hook bolts and nuts and the centre of the plate is fitted with a framed watertight door fitted with clips which can be operated from either side.

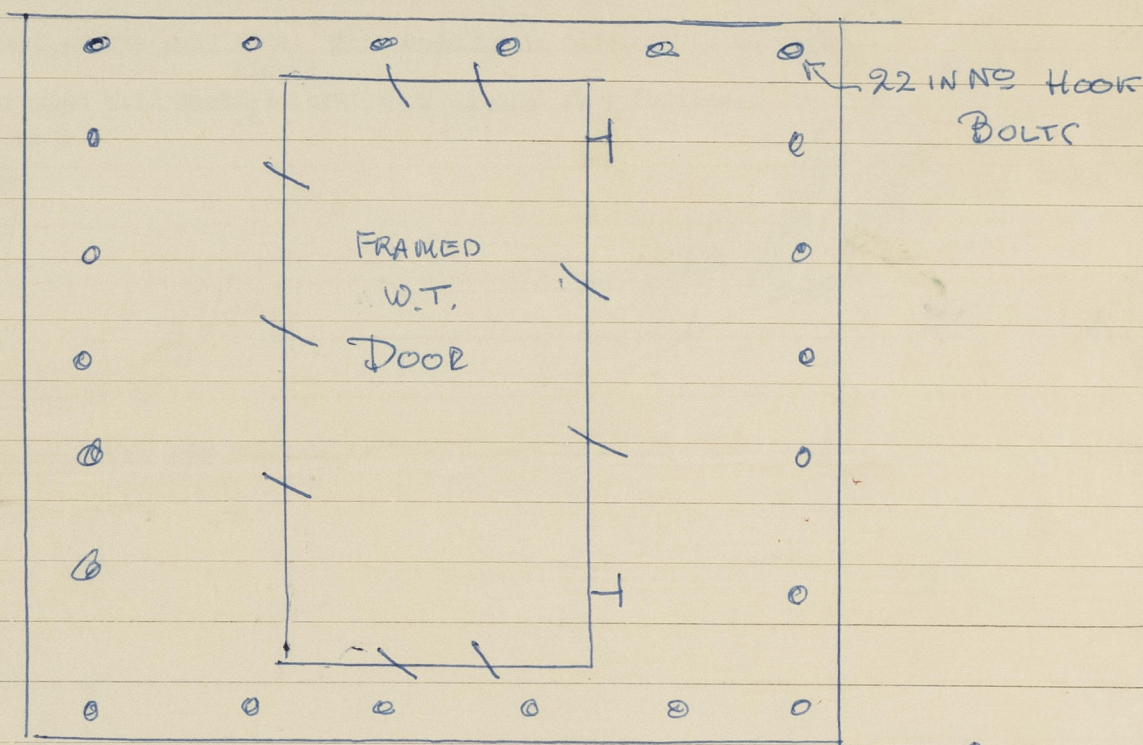

[Signature]
26-1-59

Noted No 2
27-1-59

A copy of this Report has been placed on board.

Submitted
 when he informed
 that it has been reported
 by the Society Surveyors
 Plymouth that the opening
 in the floor of the bulkhead is not
 fitted with a bolted steel plate having
 a hinged watertight steel door. As
 the entrance to the lower artificers' workshop
 the present bulkhead closing appliances will not
 require to be amended they have been
 the ship will be available so that most of the Society's
 surveys can go ahead and work at
 27.1.19