
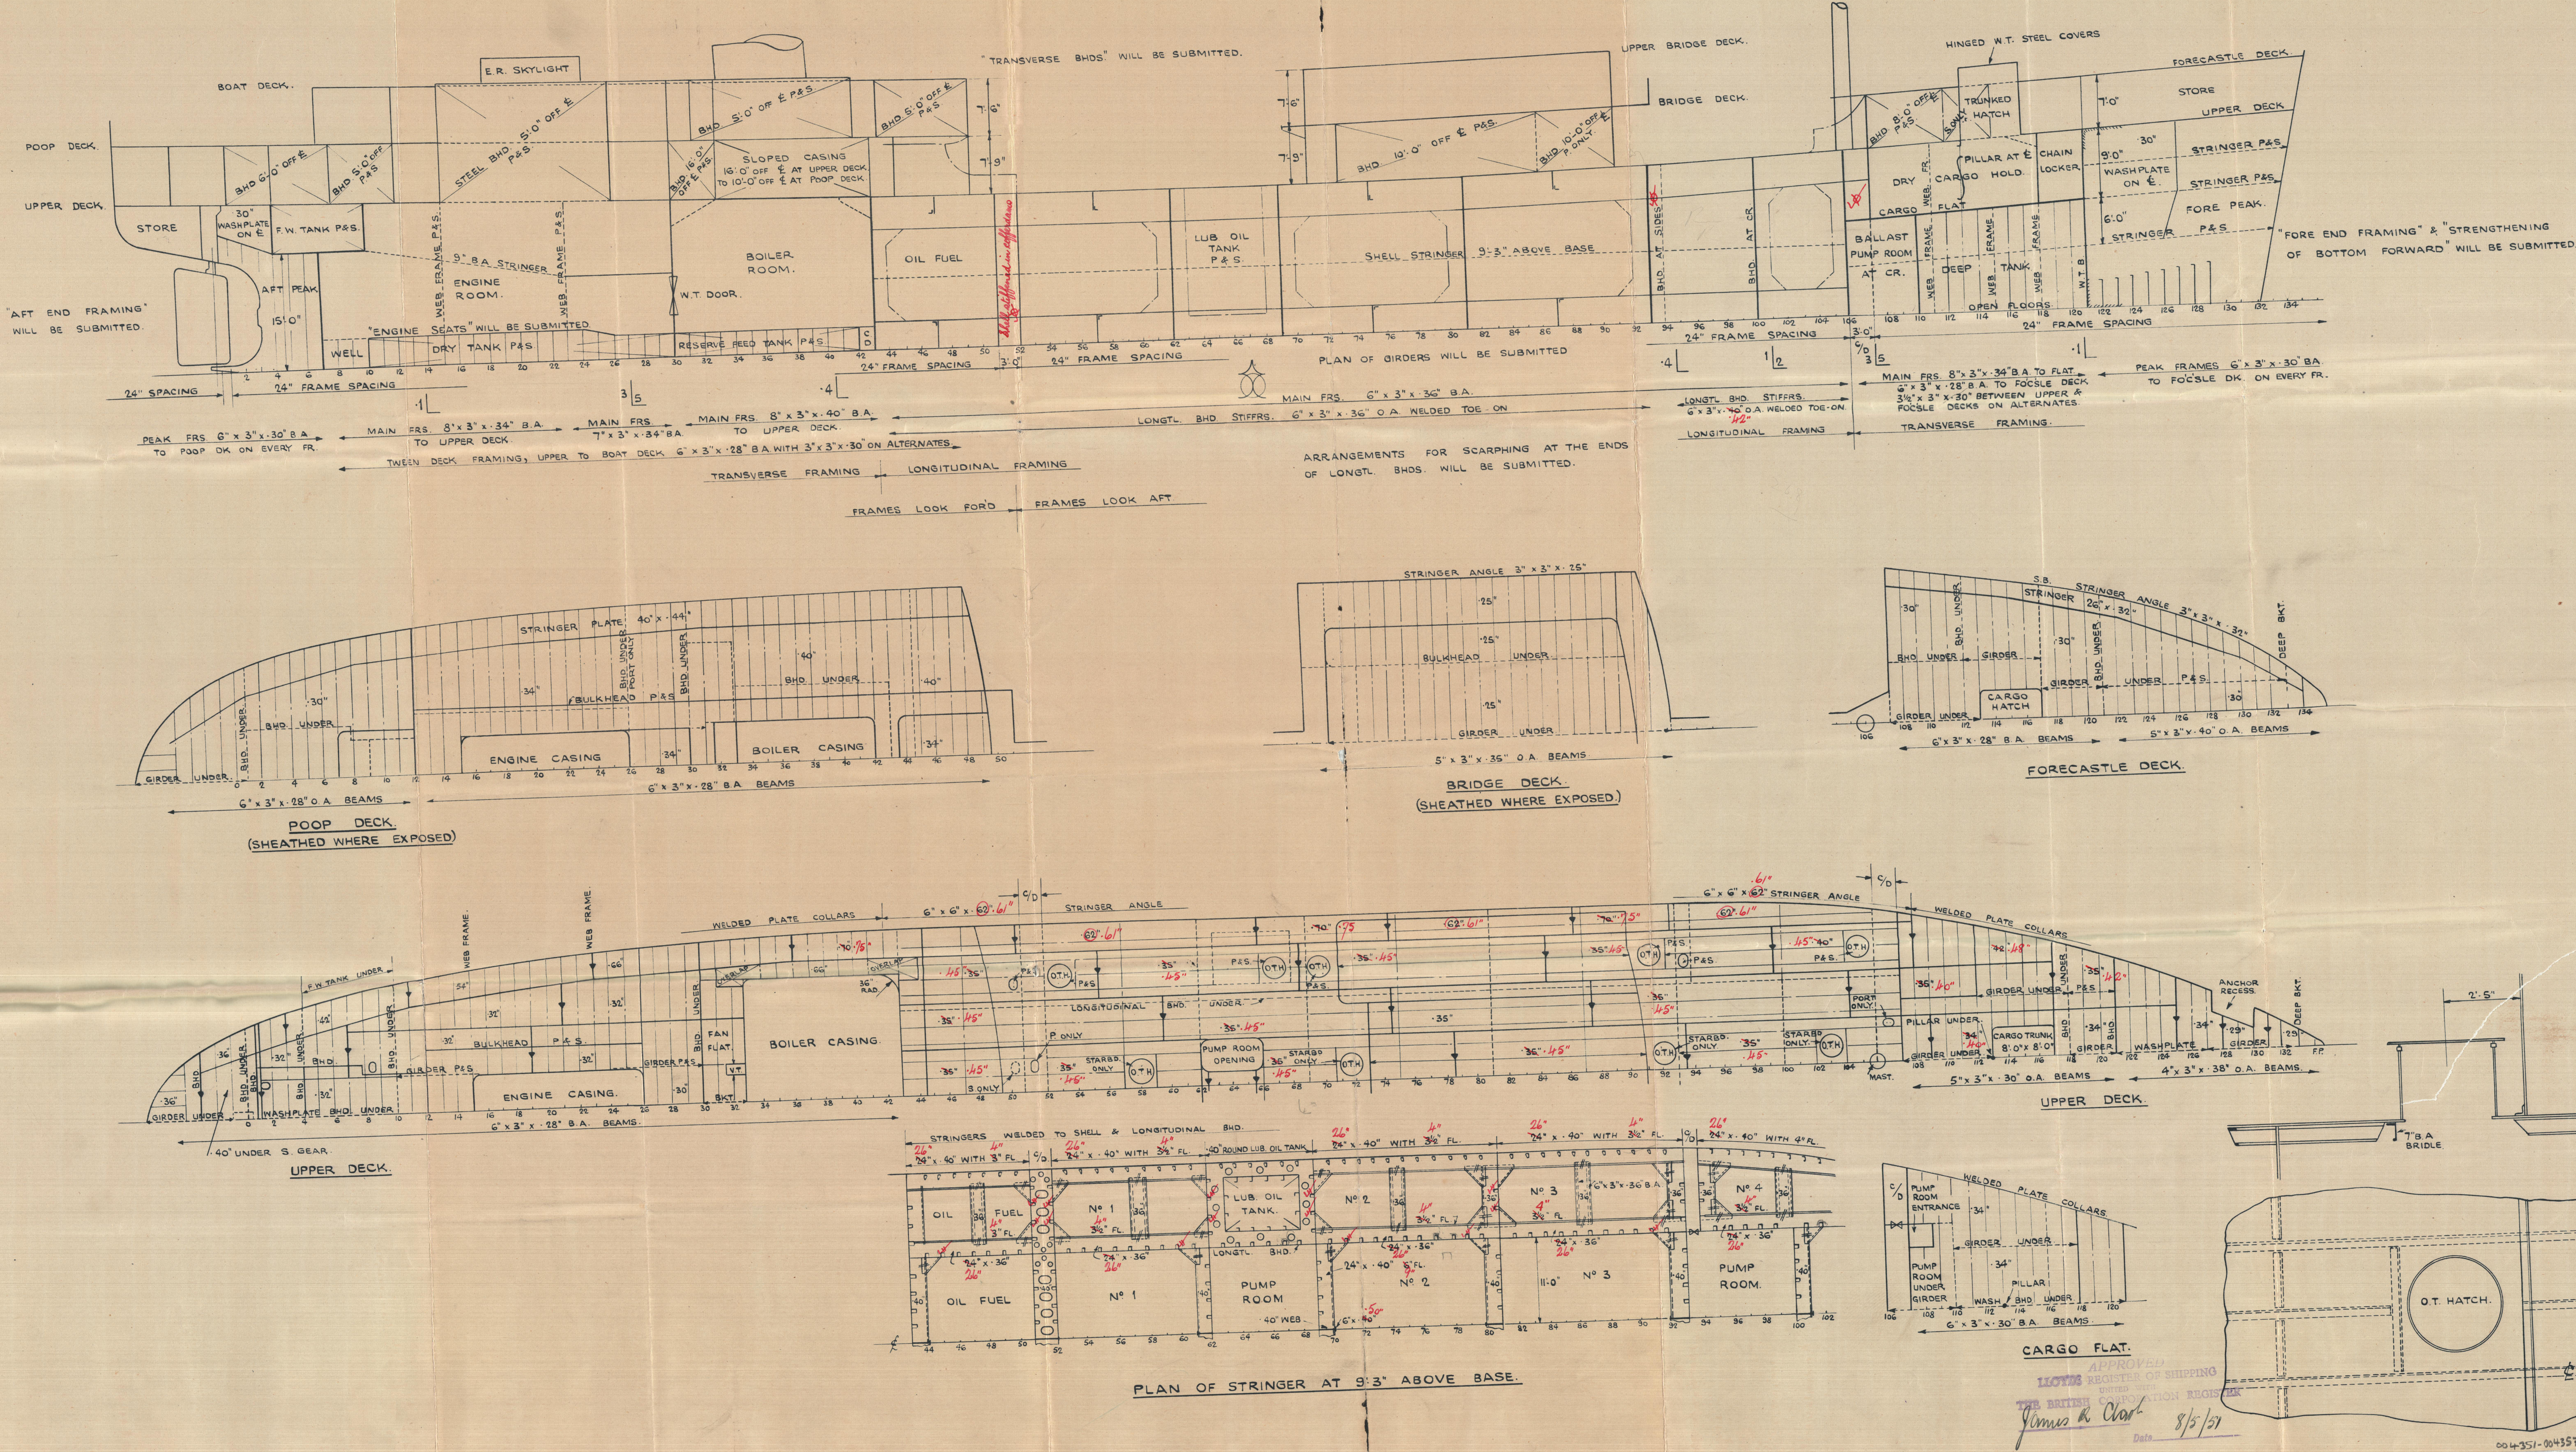


1500 TON FLEET ATTENDANT OIL TANKERS.  
SHIP NOS 492 & 493

PROFILE & DECKS.  
SCALE  $1/8" = ONE FOOT. (1/96)$   
CALEDON SHIPBUILDING & ENGINEERING CO. LTD DUNDEE  
DRAWING N° 2.

NAME OR N° OF SHIP	CONTRACTORS STAMP	ACTION OR REMARKS	AUTHORITY	INSPECTING OFFICERS STAMP
				

DIMENSIONS - 270'-0" L B P x 44'-0" B M x 18'-6" D M. MEAN DRAFT = 17'-1/4"





23.449.1

Caledon Yard No 492  $\frac{1}{2}$ .

Profile and Decks.

CALEDON S.B. & CO. LTD.  
YARD No 492.  
★ "EDDYREEF"  
Dundee Rpt No 9904.

Profile + Decks.

RECORDS DEPT.  
LONDON

3

PLANS TRANSFERRED  
TO SISTER VESSEL

EDDYBAY★



© 2020

Lloyd's Register  
Foundation

004351-004351-0201