

DUNDEE REPORT NO 9846

1500 TON FLEET ATTENDANT OIL TANKERS.

R.F.A. EDDYBAY SHIP NO 480.

MIDSHIP SECTION.

SCALE :- 1/2 INCH = 1 FOOT. (1/2).

CALEDON SHIPBUILDING & ENGINEERING Co. LTD. DUNDEE.


DRAWING No. 5.

as fitted
Bourman

NAME OR NO. OF SHIP	CONTRACTOR'S STAMP	ACTION OR REMARKS	AUTHORITY	INSPECTING OFFICER'S STAMP
		APPROVED BY LLOYDS		DATED 25-1-50

DIMENSIONS 270'-0" LBP x 44'-0" B.M. x 18'-6" D.M.

$L \times D = 270 \times 18.5 = 4995$
 $L \times B \times D = 270 \times (44 - 18.5) = 16875$
 $L \times B = \frac{270}{18.5} = 14.595$

 

EQUIPMENT (NUMERAL 18535 GRADE 3)

2 BOWERS STOCKLESS 45 CWT
1 BOWER STOCKLESS 38 CWT
1 STREAM EX STOCK 12 CWT
270 FATHOMS 1 1/2" STUD LINK CABLE
90 FATHOMS STREAM CHAIN 1 1/2" (STEEL)
ANCHORS AND CABLES TO BE SUPPLIED BY THE ADMIRALTY
90 FATHOMS 4" S.W.R. TOWLING 6 x 12 CONSTR.
2 @ 90 FATHOMS 2 1/2" S.W.R. HAWERS 6 x 12 CONSTR.
2 @ 90 FATHOMS 2 1/2" S.W.R. WARPS 6 x 12 CONSTR.

L x (B + D)	98 x 7.75 x 7.5 =	16875
POOP	17 x 7.75 x 5.0 =	570
BRIDGE	54 x 7 x 7.5 =	143
POOLE	74 x 7.5 x 5.0 =	284
HOUSE ON POOP	40 x 7.5 x 5.0 =	278
HOUSE ON BRIDGE	37 x 7.25 x 5.0 =	150
HOUSE ON UPPER BRIDGE	29 x 7 x 5.0 =	134
HOUSE ON NAV. BRIDGE		101
		18535

RIVETING LIST

RIV. DIAM.	SPACING DIAM.
D.R.	4
D.R.	3 1/2
D.R.	3 1/4
D.R.	3 1/2
D.R.	3 1/2


SHELL SEAMS - 2 STRAKES NEAREST KEEL FROM 1/2" L. FORD TO COLL BHD.
BOTTOM SHELL & SIDE SHELL
SHEER STRAKE
SHEER STRAKE AT ENDS
UPPER DECK - SEAMS

WELDING LIST

KEEL, SIDE & BOTTOM SHELL BUTTS
TANK TOP BUTTS, INCLUDING MARGIN
UPPER DECK BUTTS, INCLUDING STRINGER
TOP DECK BUTTS
LONGIT. & TRANSVERSE BHD. BUTTS
STIFFERS TO LONGIT. & TRANSVERSE BHD.
SIDE STRINGERS TO LONGIT. & TRANSVERSE BHD.
TRANSVERSES TO SHELL
SEE ALSO WELDING SCHEDULE.

SECTION THRO' ENGINE ROOM. SECTION THRO' CARGO SPACE.

RECORDS DEPT.
LONDON

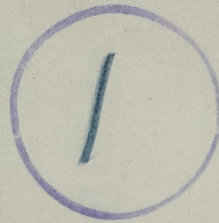

Eddybay*
Midship Section (as filled)

RETAIN



© 2020

004351-004357-0202 1/1
Lloyd's Register
Foundation.

FOR ENCLOSURE

To

Lloyd's

From THE CALEDON SHIPBUILDING & ENGINEERING CO. LTD.
CALEDON SHIPYARD, DUNDEE.

0202 2 1/2