


$416'0'' \text{ L.B.P.} \times 57'2'' \text{ B.E.T.} \times \frac{27'4'' \text{ NORMAL DMLD U.D.K.} \pm 1'0'' \text{ FOR NO SHEER BET. FTS 46 \& 114}}{27'7'' \text{ DMLD SECOND DECK}}$
 Class- 100A1 Lloyds with freeboard corresponding to a draft 18' more than that of a C.S.S. vessel.
 Scale: $\frac{1}{4}'' = 1 \text{ ft.}$

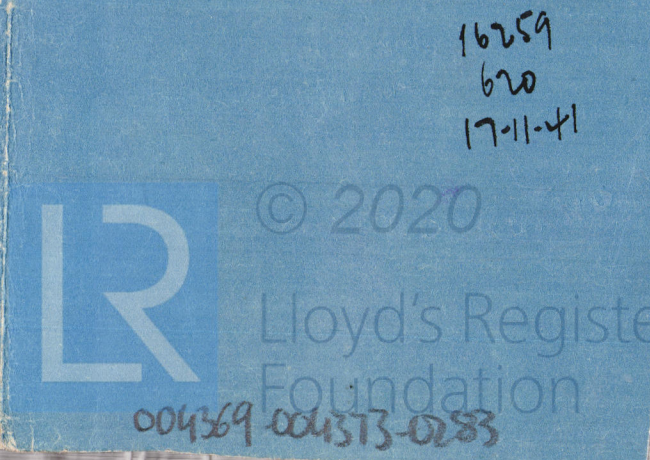

EX INDORE

PROFILE

RECORDS DEPT.,
LONDON.

J. L. THOMPSON & Sons'

YAR No. 620

3

621, 622, 623 / 10.2.42

624 / 15.4.42

626 / 25.6.42

Profile

PLANS TRANSFERRED
TO SISTER VESSEL
NUNEZ DE BALBOA

This date

33503.

Sld. 46. No. 33864. "Denewood." *

N. N. INDORE.

N/N Polegate

Sister vessel to Helixia

RECORDS DEPT.
LONDON

© 2020



Lloyd's Register
Foundation

