
 


S.S. ANDALUSIER
EX S.S. WAR VICOUR.

GENERAL ARRANGEMENT.

DIMENSIONS: 411' 6" BPX 55' 5 1/2" B. MLX 35' 1 1/2" DM (SHELTER-DEK)

SCALE 1/8" INCH PER FOOT

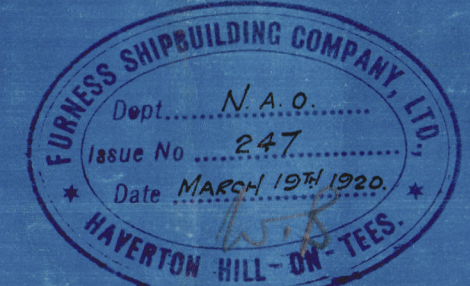

Now named "African Marines"

^{ex}
S.S. "WAR VIGOUR"

^{ex}
NOW NAMED ANDALUSIER

Thos. Furness, S. B. L. N° 10

No. 1 Type Standard

GENERAL ARRANGEMENT


as built

Mar. Rpt. No 10622

~~W. S. 434~~

Castillo Montjuich

RETAIN

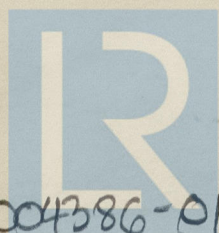

© 2020

Lloyd's Register
Foundation

004382-004386-0122