

S.T. "CAPE CLEVELAND." (EX YESTOR)

SHIP NOS. 682-3.

MIDSHIP SECTION.

DIMENSIONS :- 165'-0" B.P. x 28'-0" B.MLD x 15'-0" D.MLD

CLASS 100 A.I. STEAM TRAWLER.

BUILT BY COOK, WELTON & GEMMEL, BEVERLEY FOR THE ADMIRALTY.


RE-CONVERTED BY THE MIDDLE DOCKS & ENGINEERING CO. LTD.

SCALE:- $\frac{1}{2}" = 1'-0"$

CO: LTD:
See Newcastle Rpt - No 10 to 151
Dated Dec 1946 *eff.*

EQUIPMENT.		
1 STOCKLESS	ANCHOR	10 $\frac{1}{4}$ CWTs.
1 D°	D°	9 $\frac{3}{4}$ CWTs
1 RODGERS	ANCHOR	4 CWTs (EX STOCK)
150 FATHOMS	1 $\frac{3}{16}$ "	STUD LINK CABLE
60 FATHOMS	6"	HAWSEER.
60	"	5 $\frac{11}{16}$ " NAPP


LLOYDS NUMERALS.	
D	15.00
B + D	43.00
L x D	2475.00
L x (B + D)	7095.00
"d"	13.50
$\frac{4}{10}$	11.00
$\frac{4}{8}$	5.89.

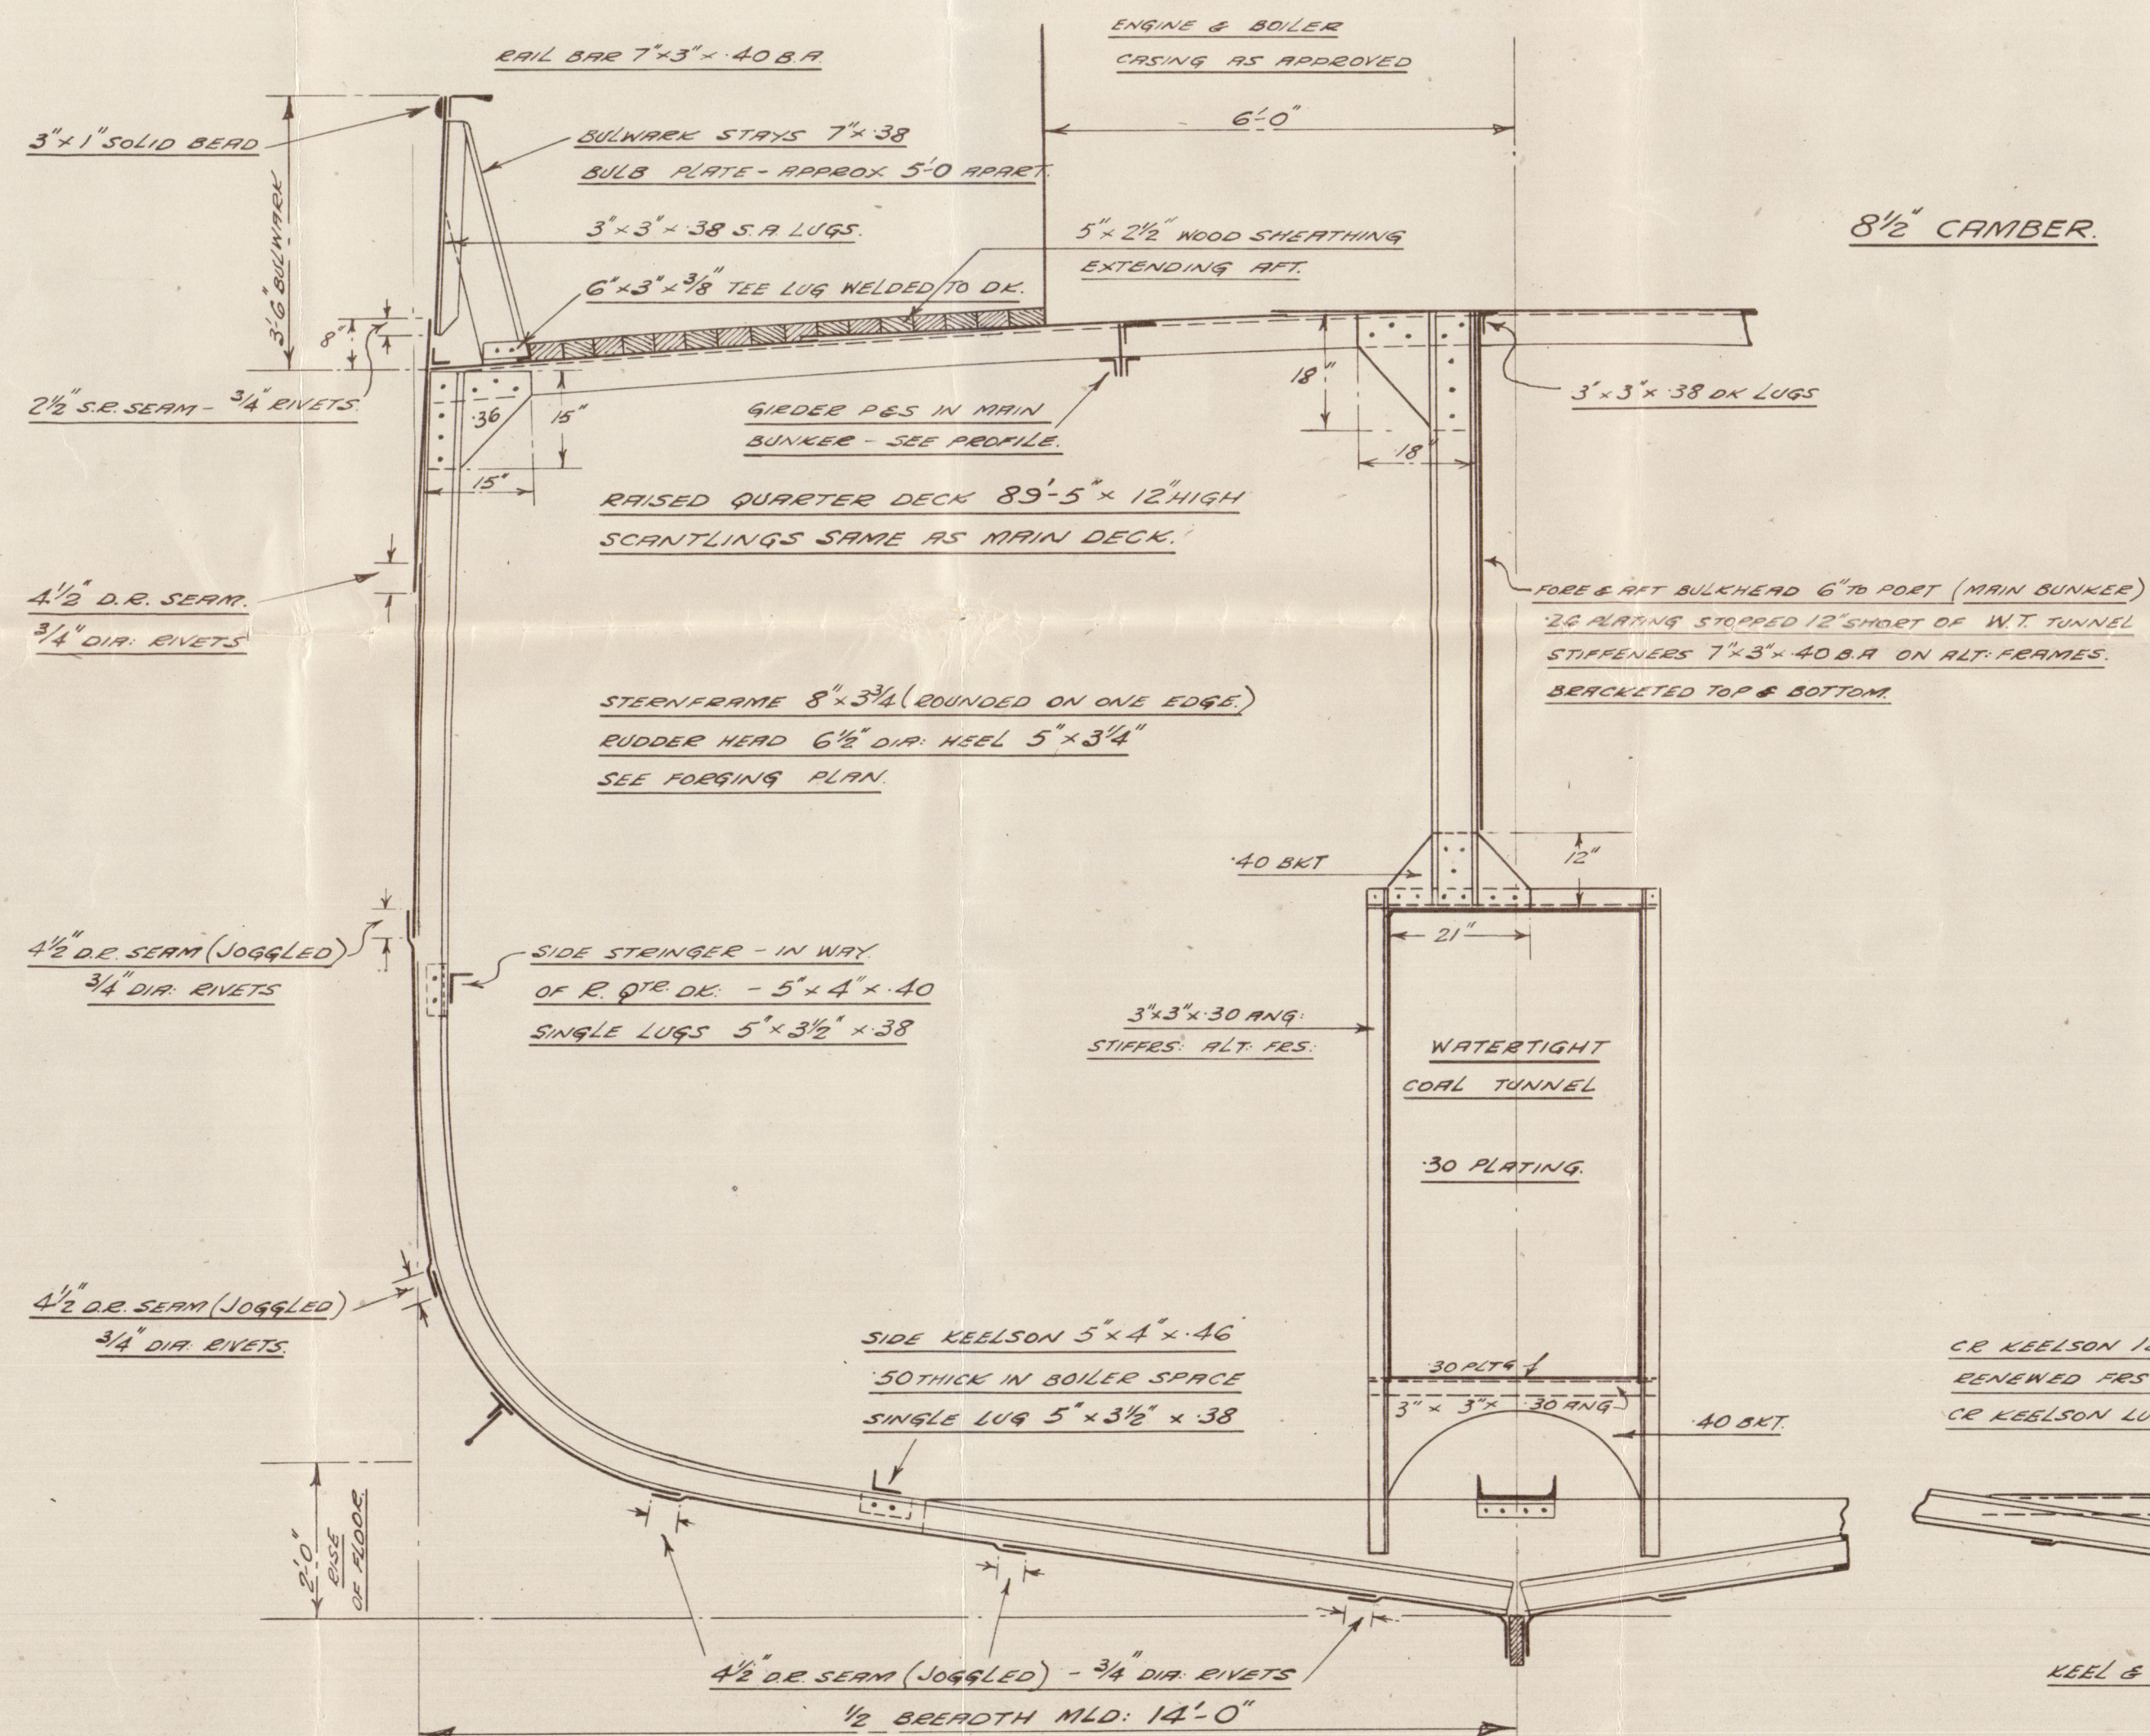


NOTE:- SHELL BEADINGS ELECTRICALLY WELDED IN LIEU OF RIVETING.

SECTION IN WAY OF RAISED Q^{TR} DK:

THRO' MAIN BUNKER.

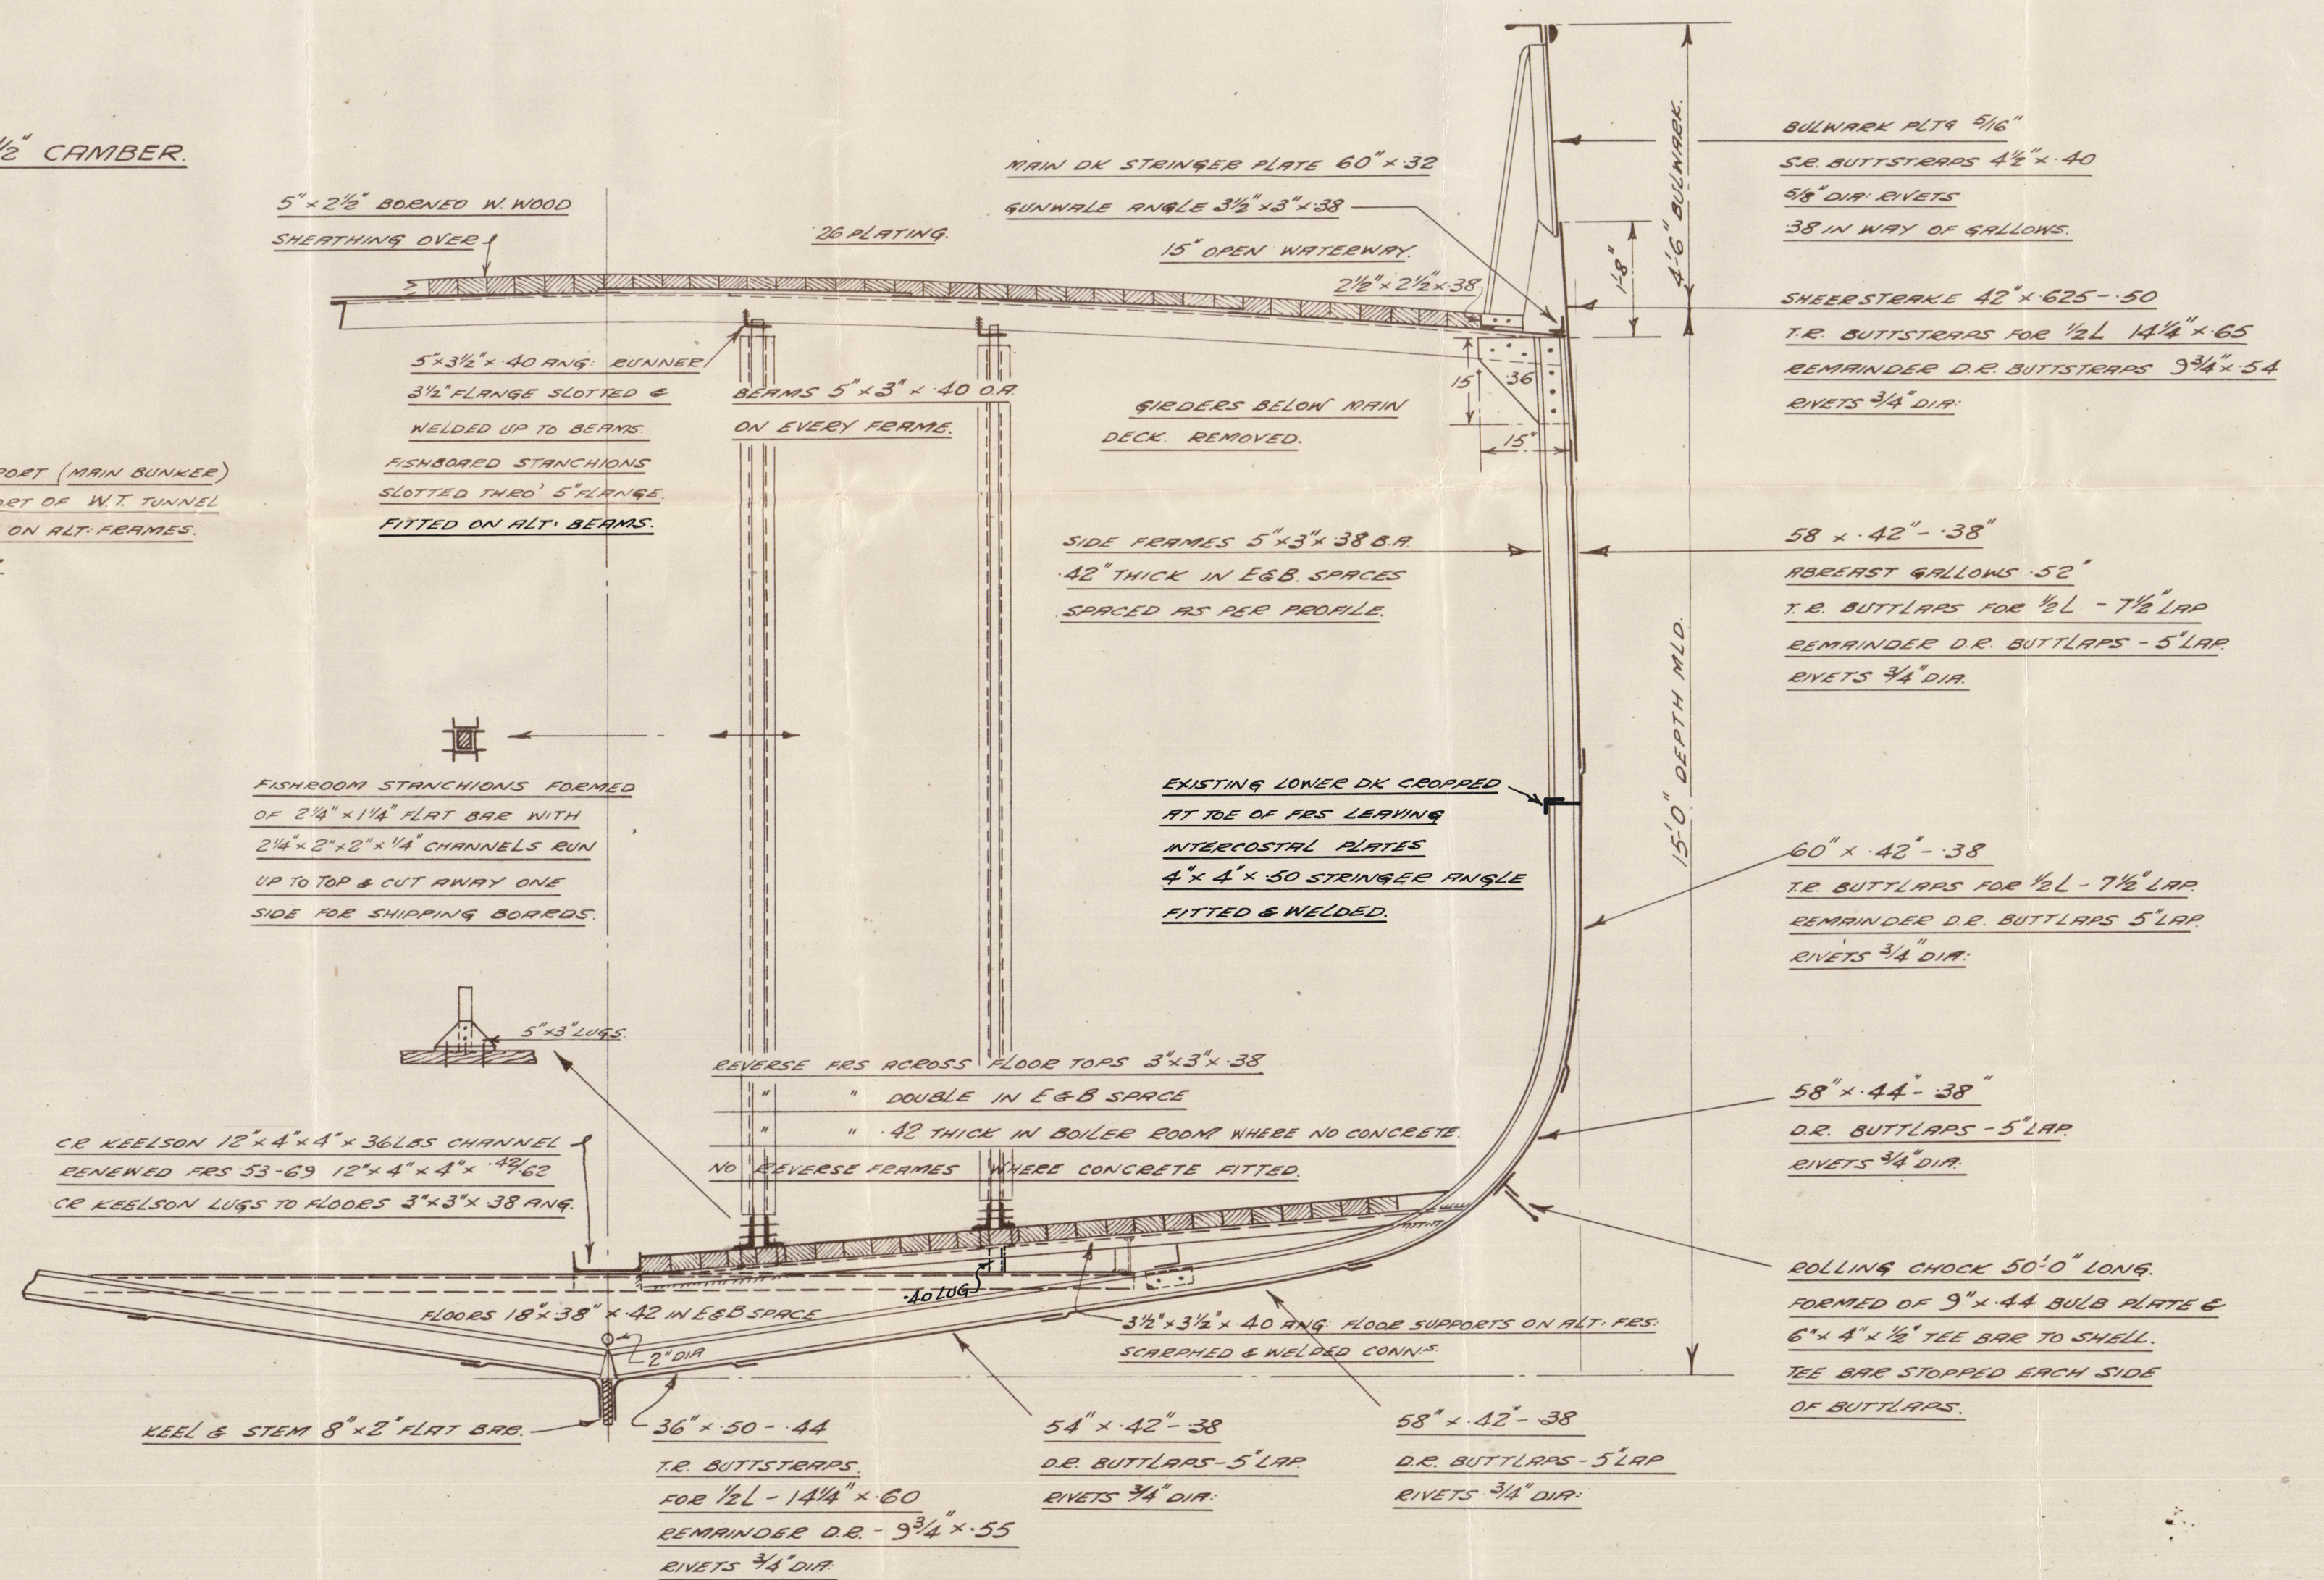

SECTION IN WAY OF MAIN DK:

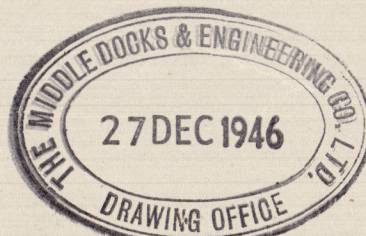

"Cape Cleveland."

Invc rept No. 104151.

M/S.



© 2021

Lloyd's Register
Foundation

004387-004393-0070