



M/s. JUTLANDIA
PASSENGER AND CARGO MOTORSHIP
CLASS LLOYD'S REGISTER 100 A 1+ WITH EREBOARD
CORRESPONDING TO THAT OF A COMPLETE SUPERSTRUCTURE VESSEL
DIMENSIONS 129.54 x 18.6 x 10.975 M (425'0" x 61'0" x 36'0")
SCALE 1:100

 

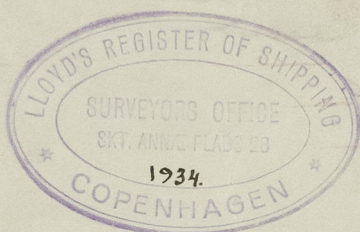

M/
V "JUTLANDIA"

Nakskov. Yard. N^o 60.

Profile & Decks.

("as built")

8456.73 Tons Gross.

Gen. Rpt No. 9481.



© 2021

Lloyd's Register
Foundation

004387-004393-0145